
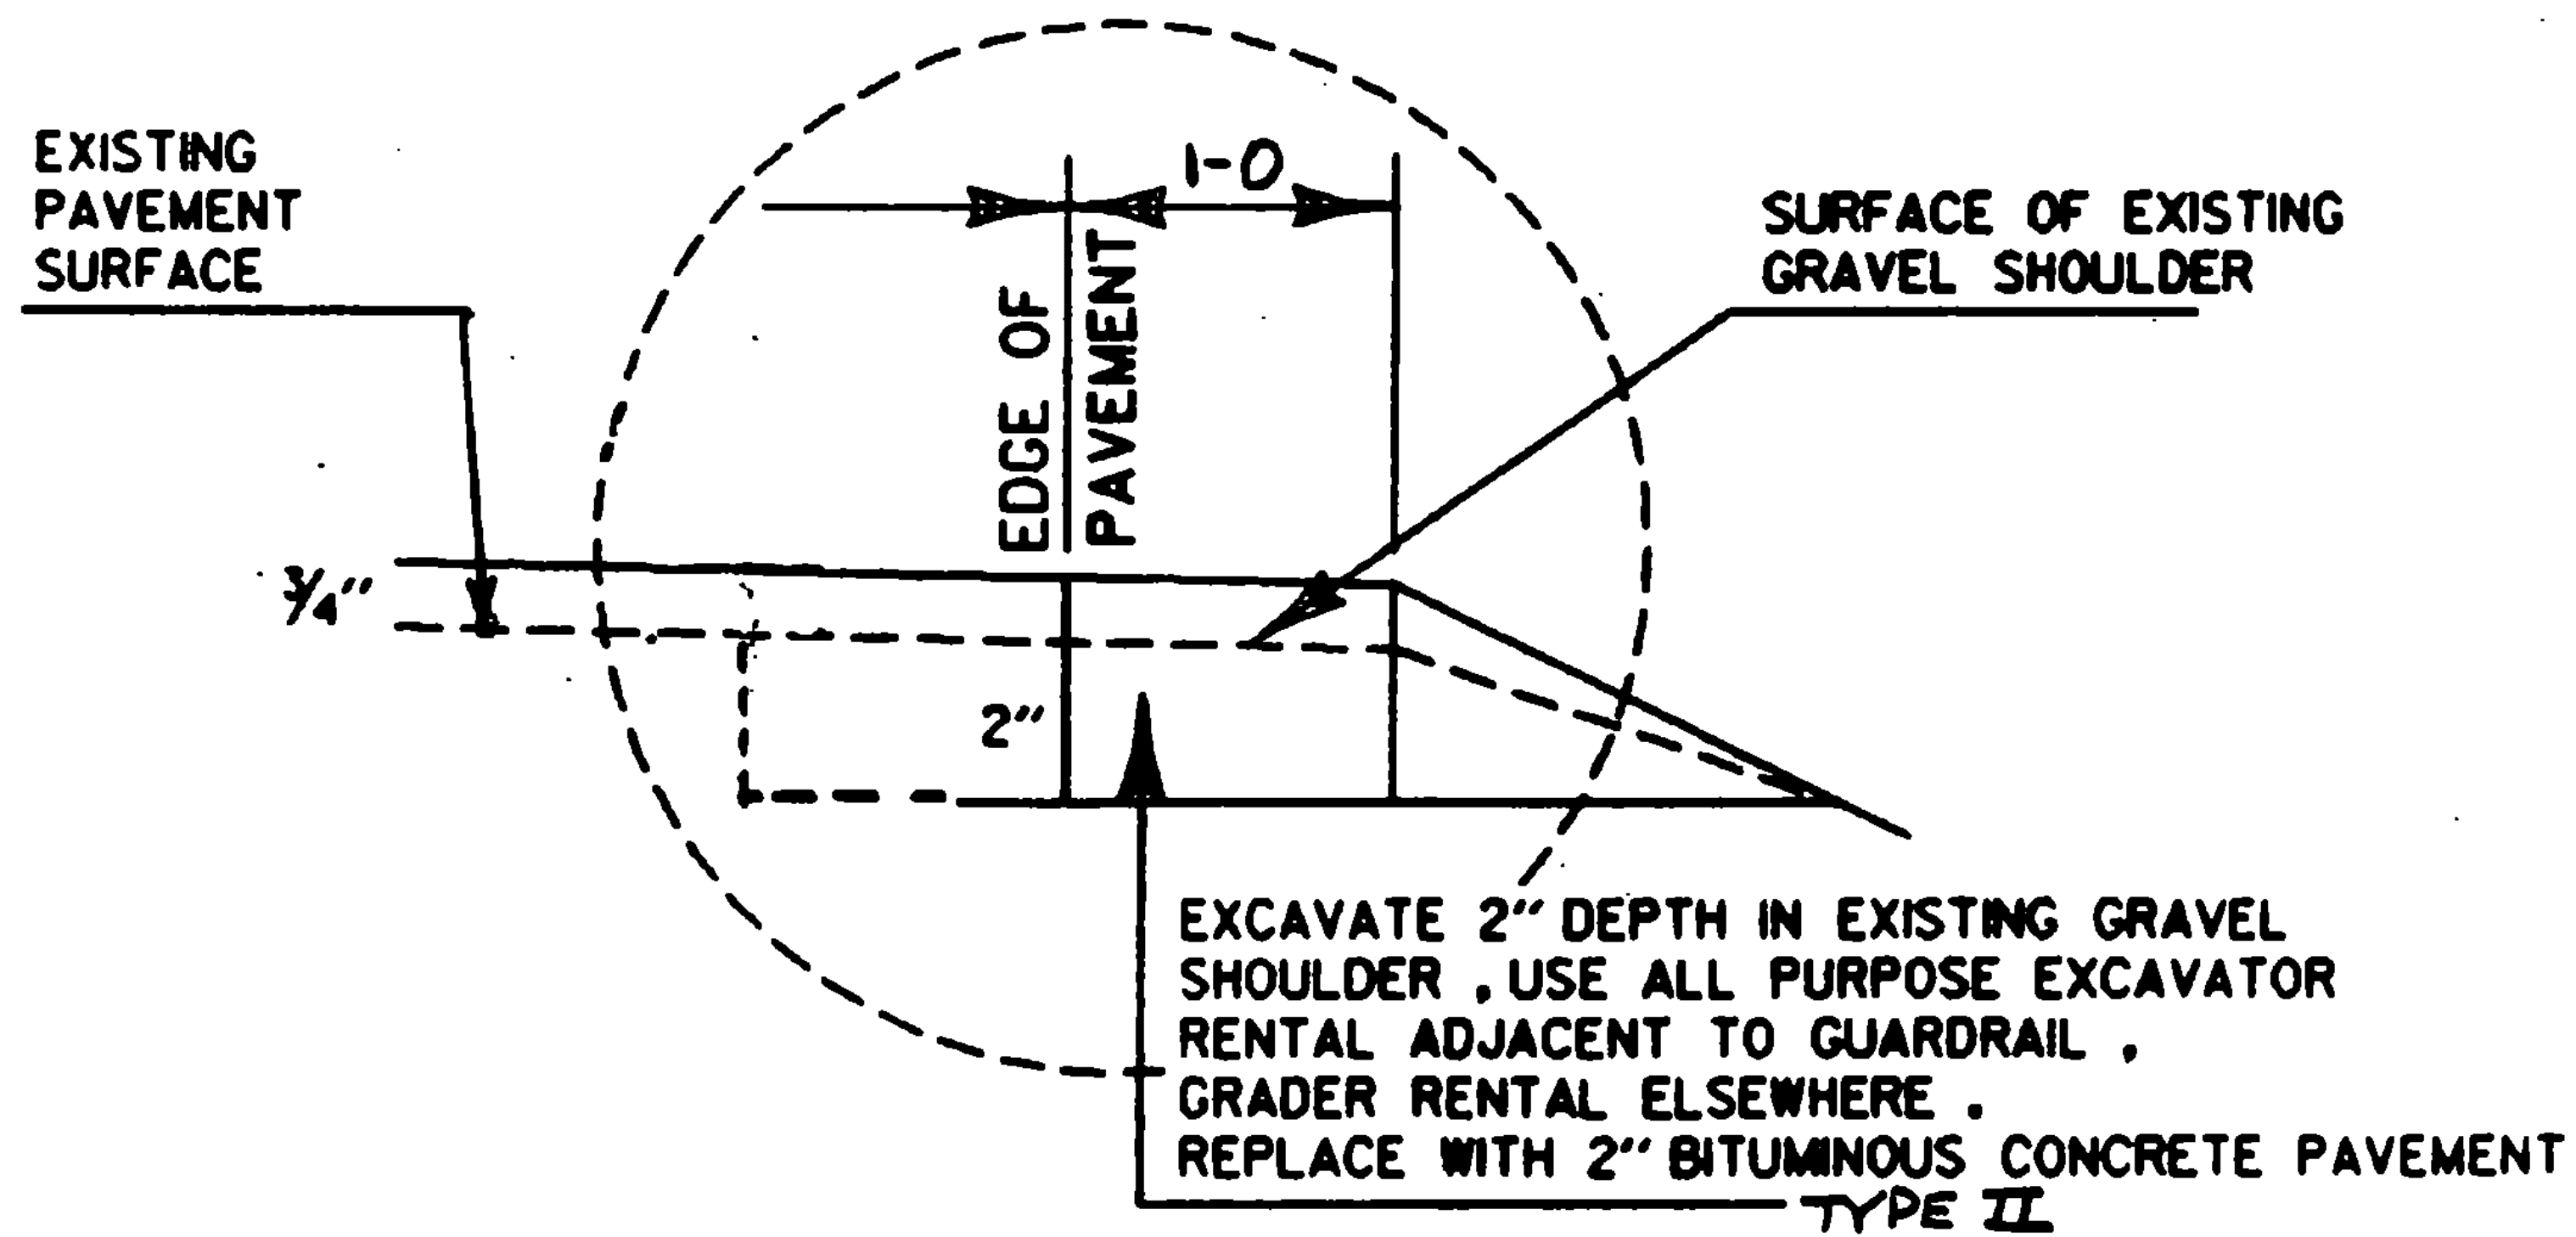


TYPICAL SECTIONS & DESIGN DATA

VERNON MM0.00 ~ MM1.13
 ITEM 406.25 BITUMINOUS CONCRETE PAVEMENT
 LEVELING COURSE TYPE IV (382 TONS/MILE)
 1 1/4" WEARING COURSE TYPE III (± 1/4")
 AS DIRECTED BY THE ENGINEER
 NOTE: EXISTING PAVEMENT IS 10' LANES
 W/ 2' GRAVEL SHOULDERS.

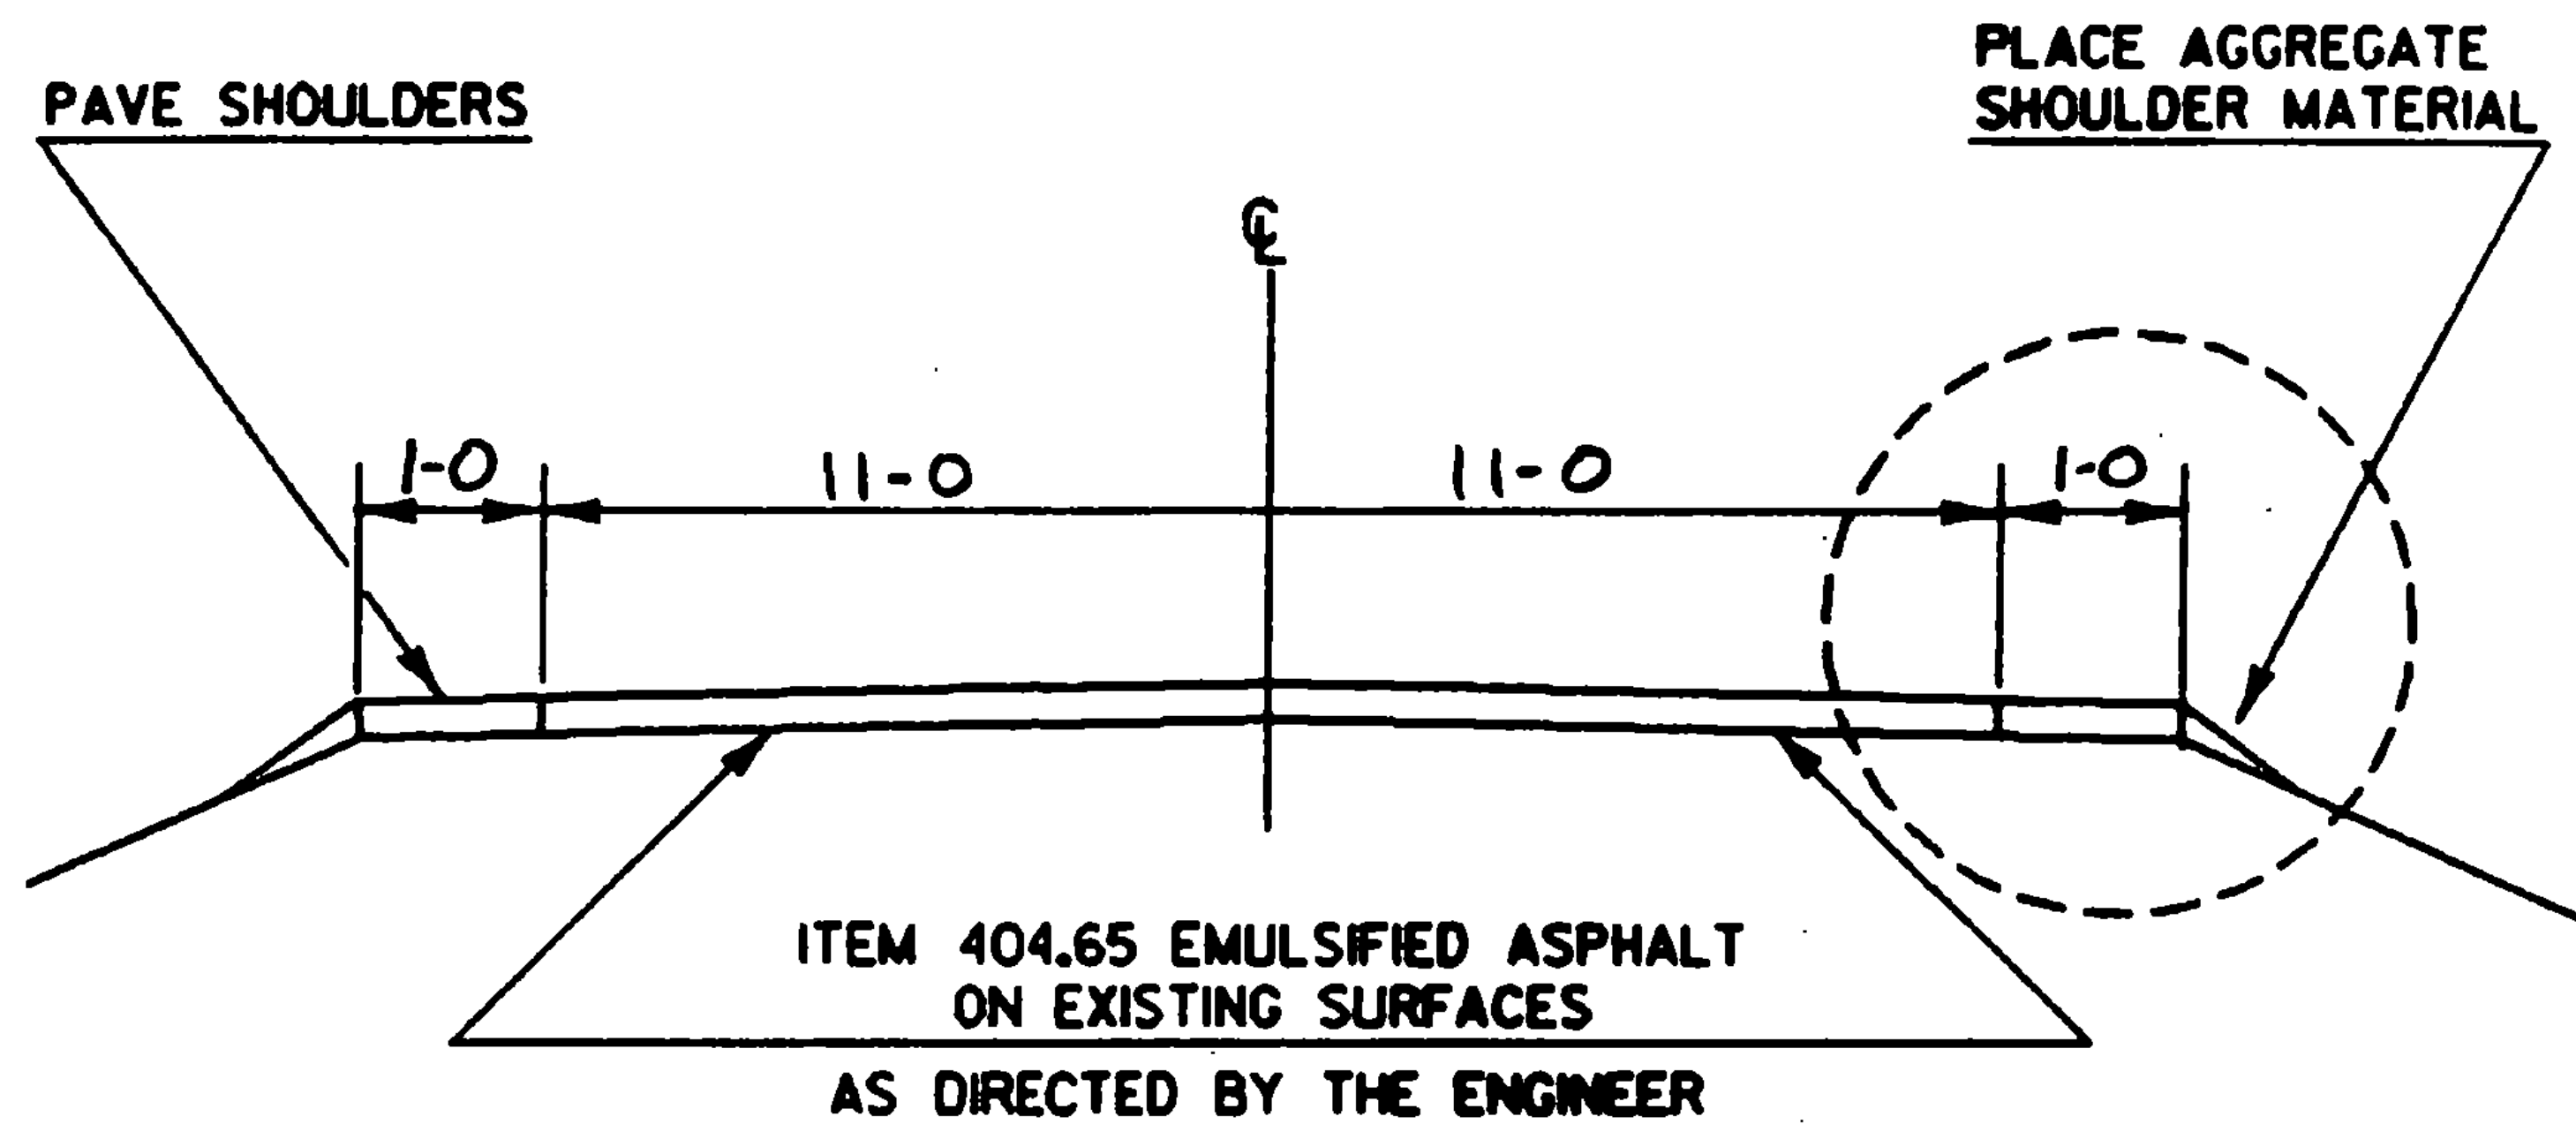

PROJECT Vernon

NO. HMA 2819

SHEET 4 OF 10 SHEETS

SHEET 23 OF 64 SHEETS