



# TYPICAL SECTIONS & DESIGN DATA

VERNON MM1.13 ~ MM 3.62 , MM 3.73 ~ MM 6.800

ITEM 406.25 BITUMINOUS CONCRETE PAVEMENT  
LEVELING COURSE TYPE IV (4 1/4 TONS/MILE )

1 1/4" WEARING COURSE TYPE III (± 1/4")

AS DIRECTED BY THE ENGINEER

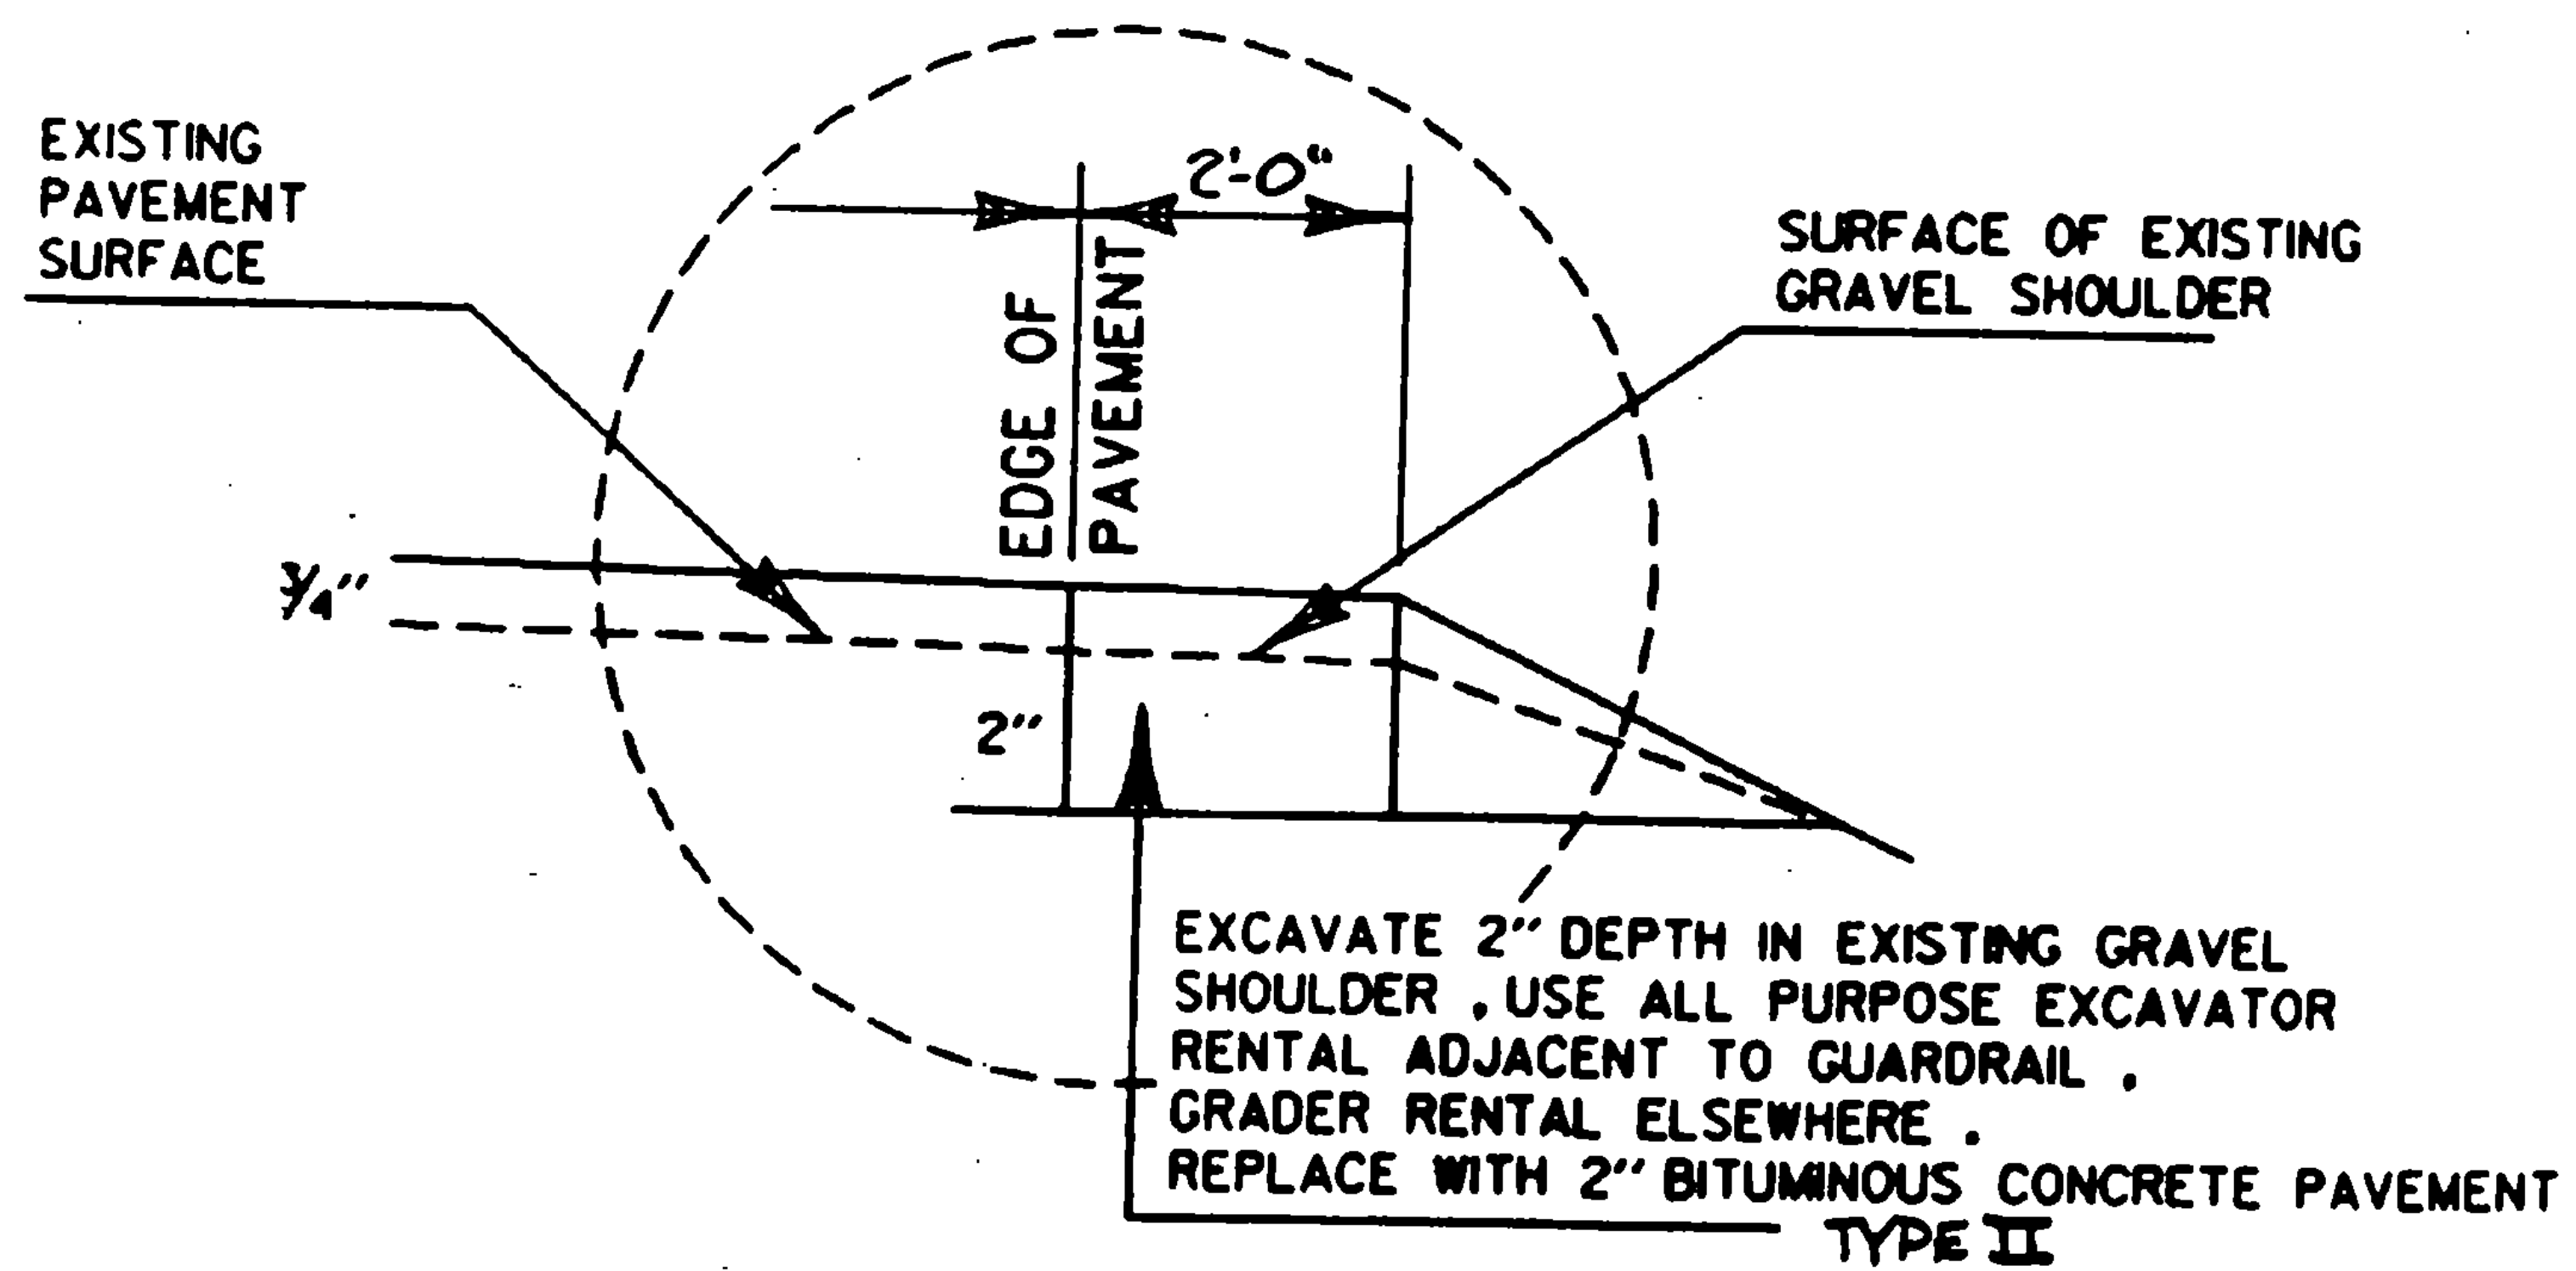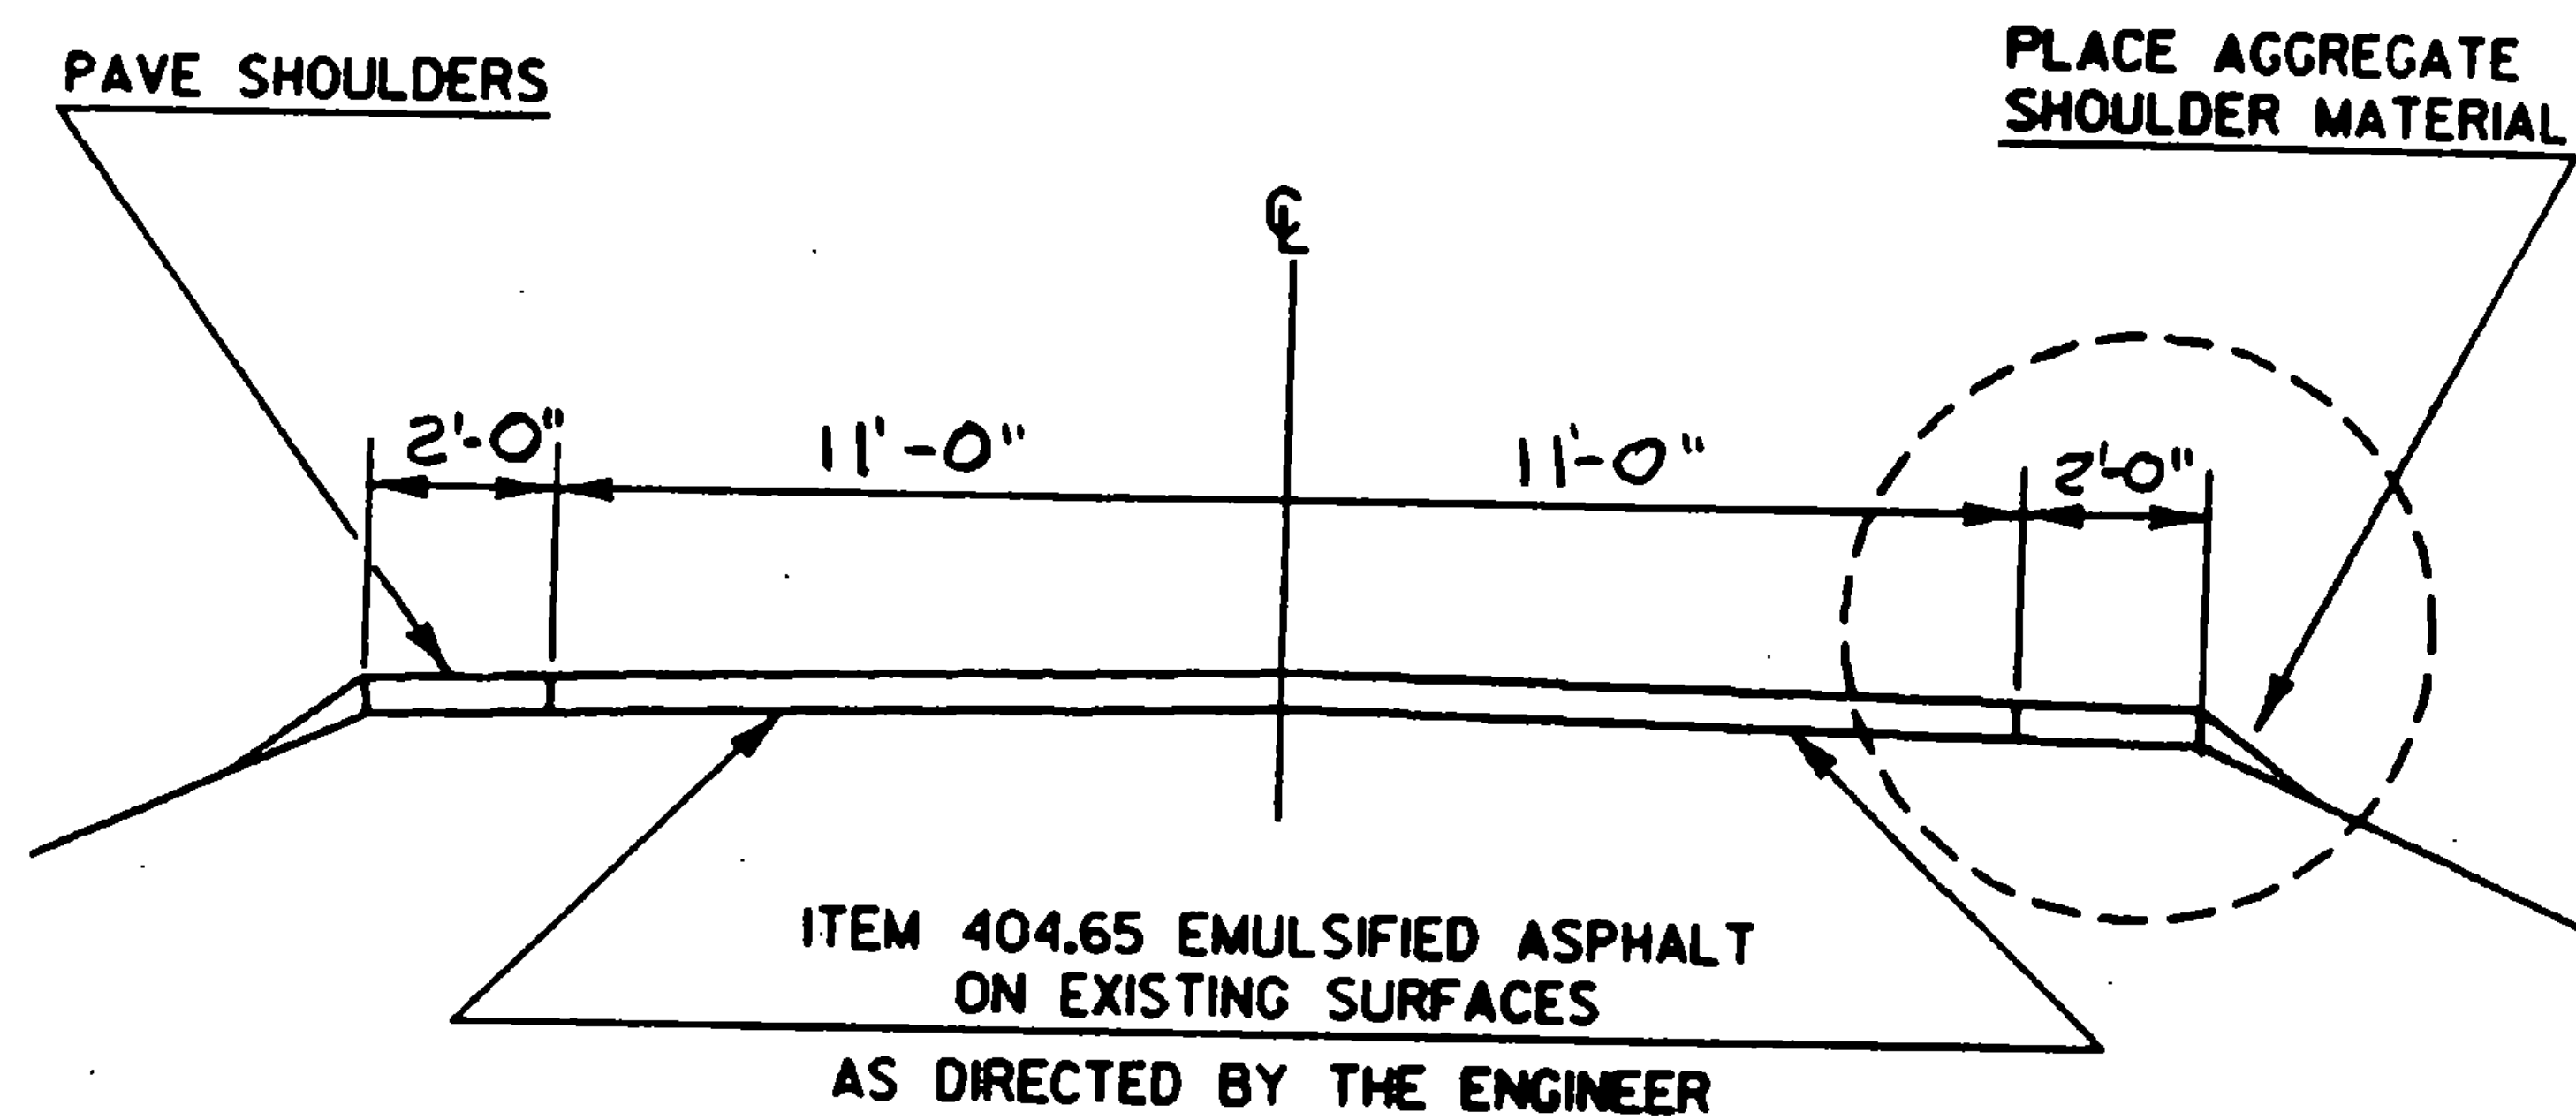

PROJECT Vernon

NO. HMA 2819

SHEET 5 OF 10 SHEETS

SHEET 24 OF 64 SHEETS