
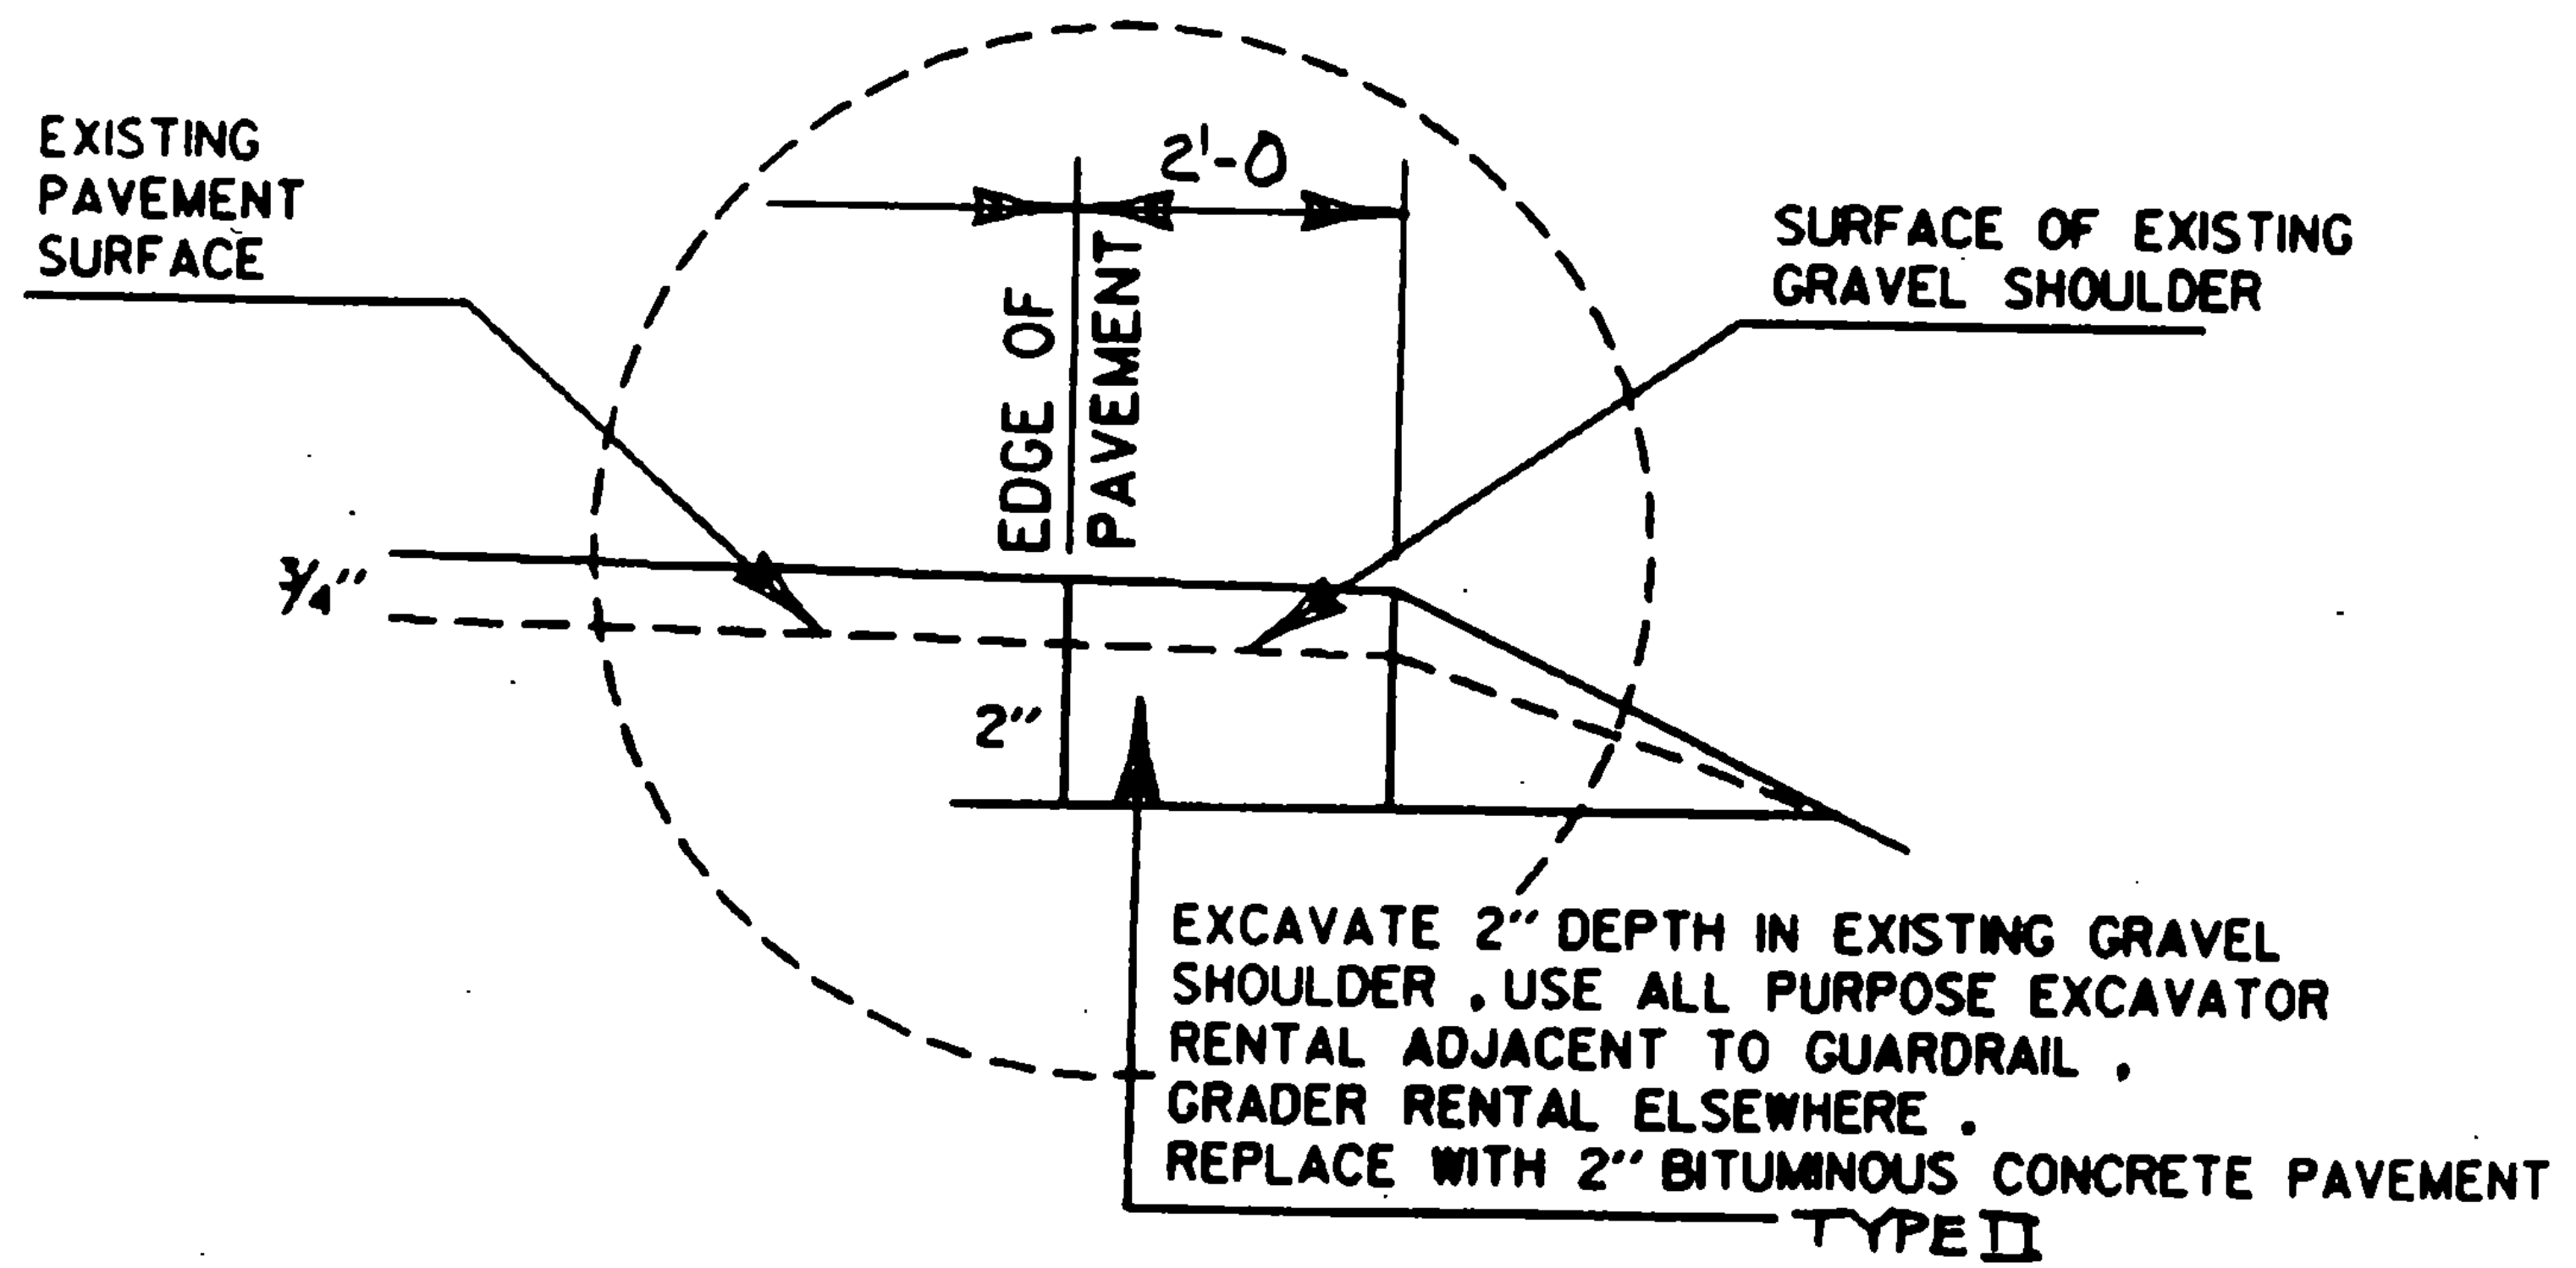


# TYPICAL SECTIONS & DESIGN DATA

VERNON MM 3.62 ~ MM 3.73  
 ITEM 406.25 BITUMINOUS CONCRETE PAVEMENT  
 LEVELING COURSE TYPE IV (477 TONS/MILE)  
 1 1/4" WEARING COURSE TYPE III (± 1/4")  
 AS DIRECTED BY THE ENGINEER

\*NOTE: EXISTING RT. SHOULDER IS PAVED.  
 DETAILED BLOW-UP BELOW  
 APPLIES TO LEFT SHOULDER  
 ONLY.

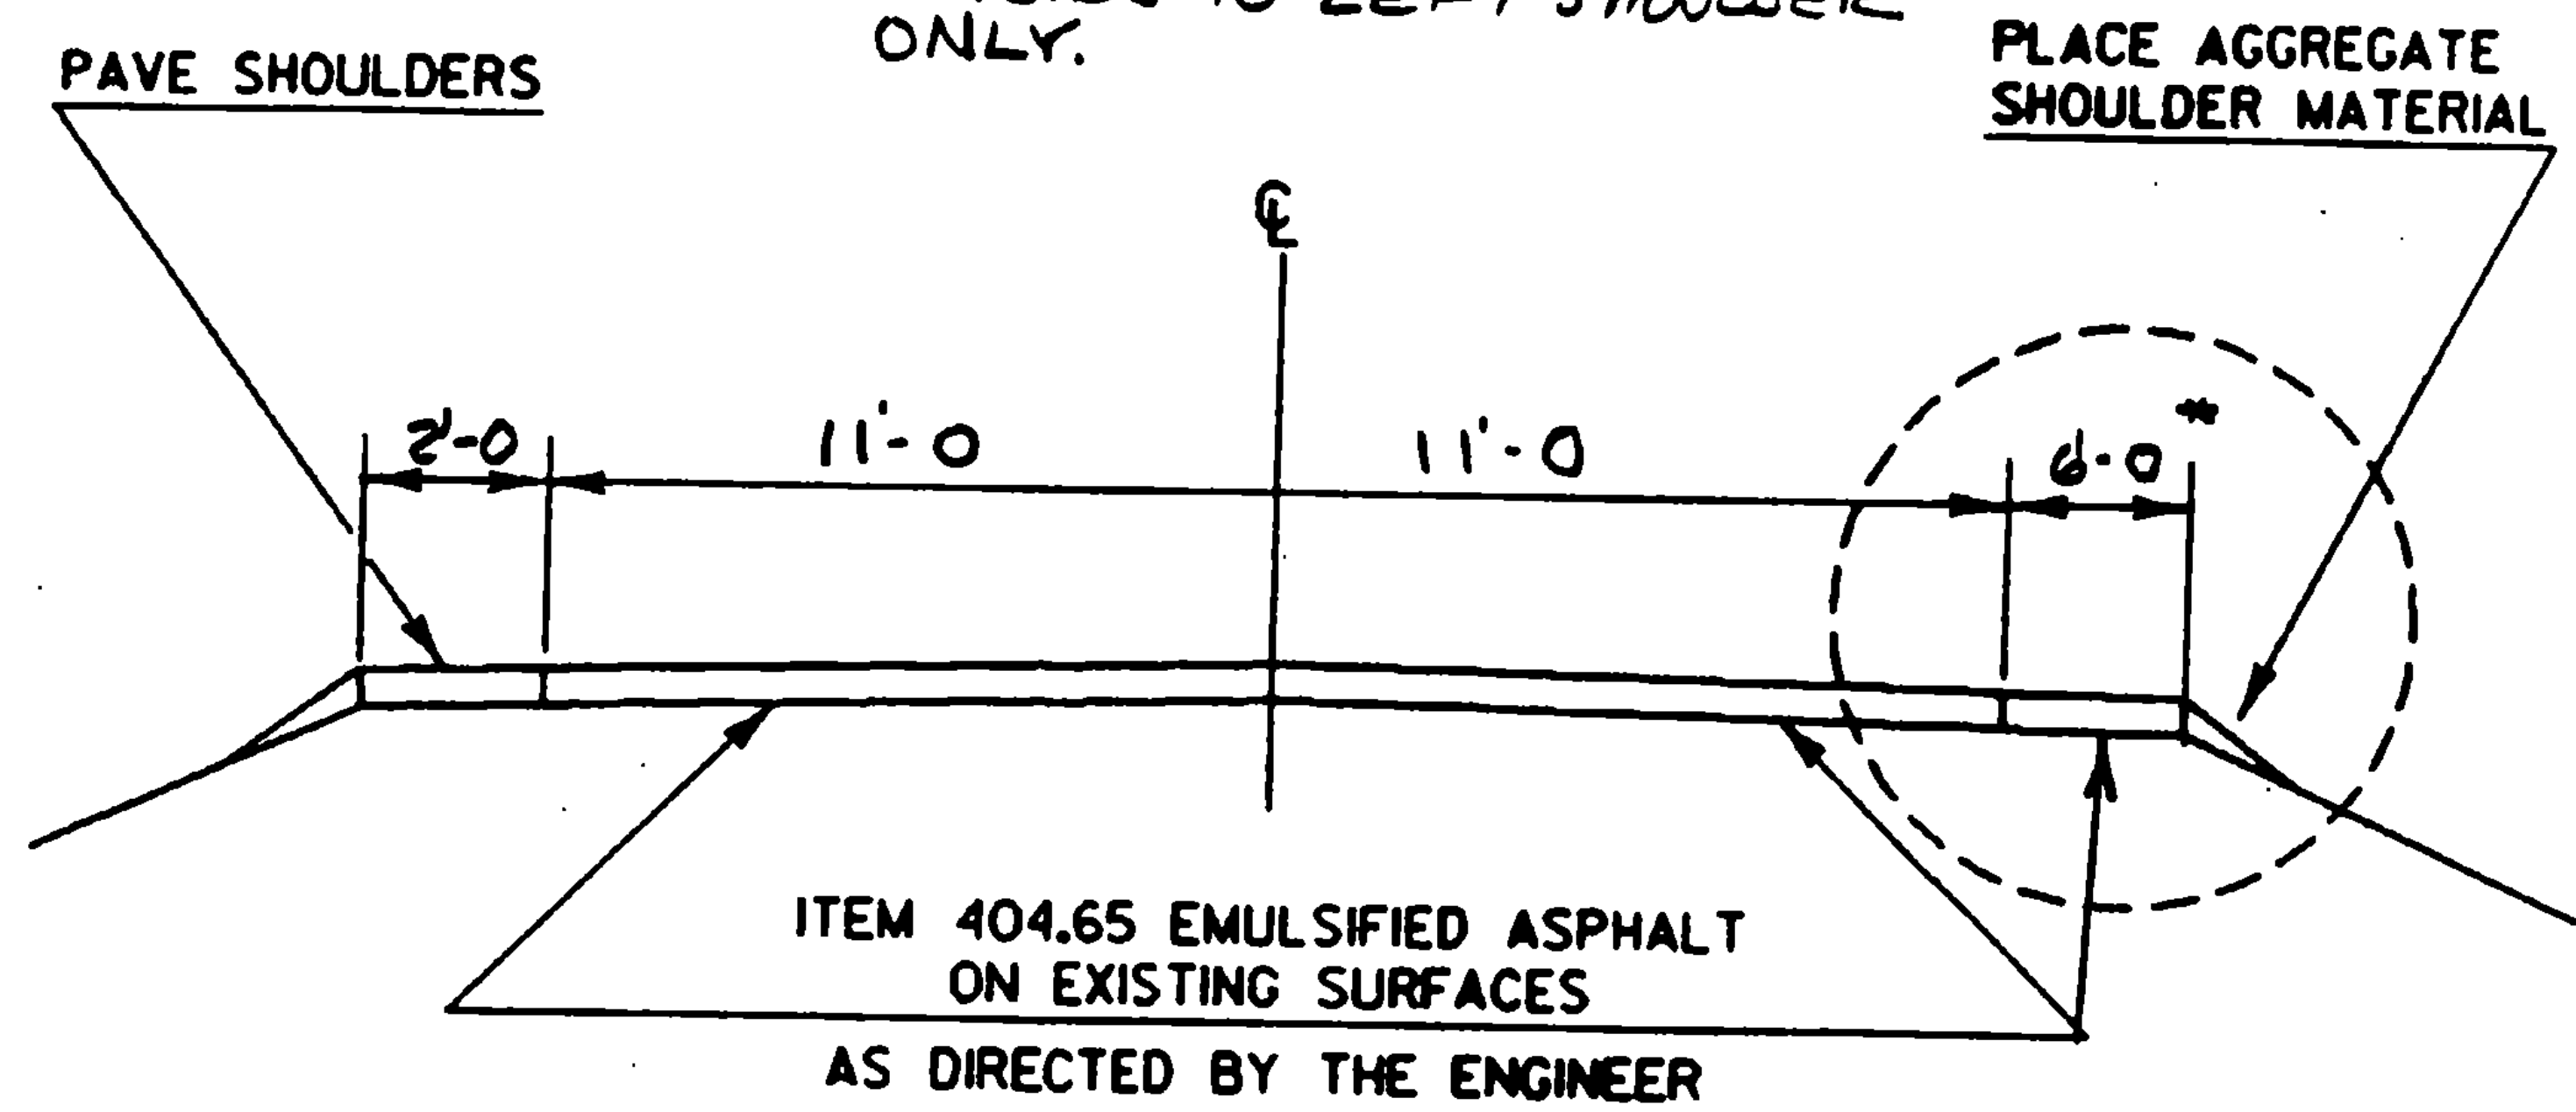

PROJECT Vernon

NO. HMA 2819  
 SHEET 6 OF 10 SHEETS  
 SHEET 25 OF 64 SHEETS