


TYPICAL SECTIONS & DESIGN DATA

WILMINGTON MM 4.283 ~ MM 4.500
ITEM 406.25 BITUMINOUS CONCRETE PAVEMENT
LEVELING COURSE TYPE IV (473 TONS/MILE)
1/4" WEARING COURSE TYPE III ($\pm 1/4"$)

AS DIRECTED BY THE ENGINEER

NOTE: PROJECT STARTS AT WEST END OF BRIDGE 34

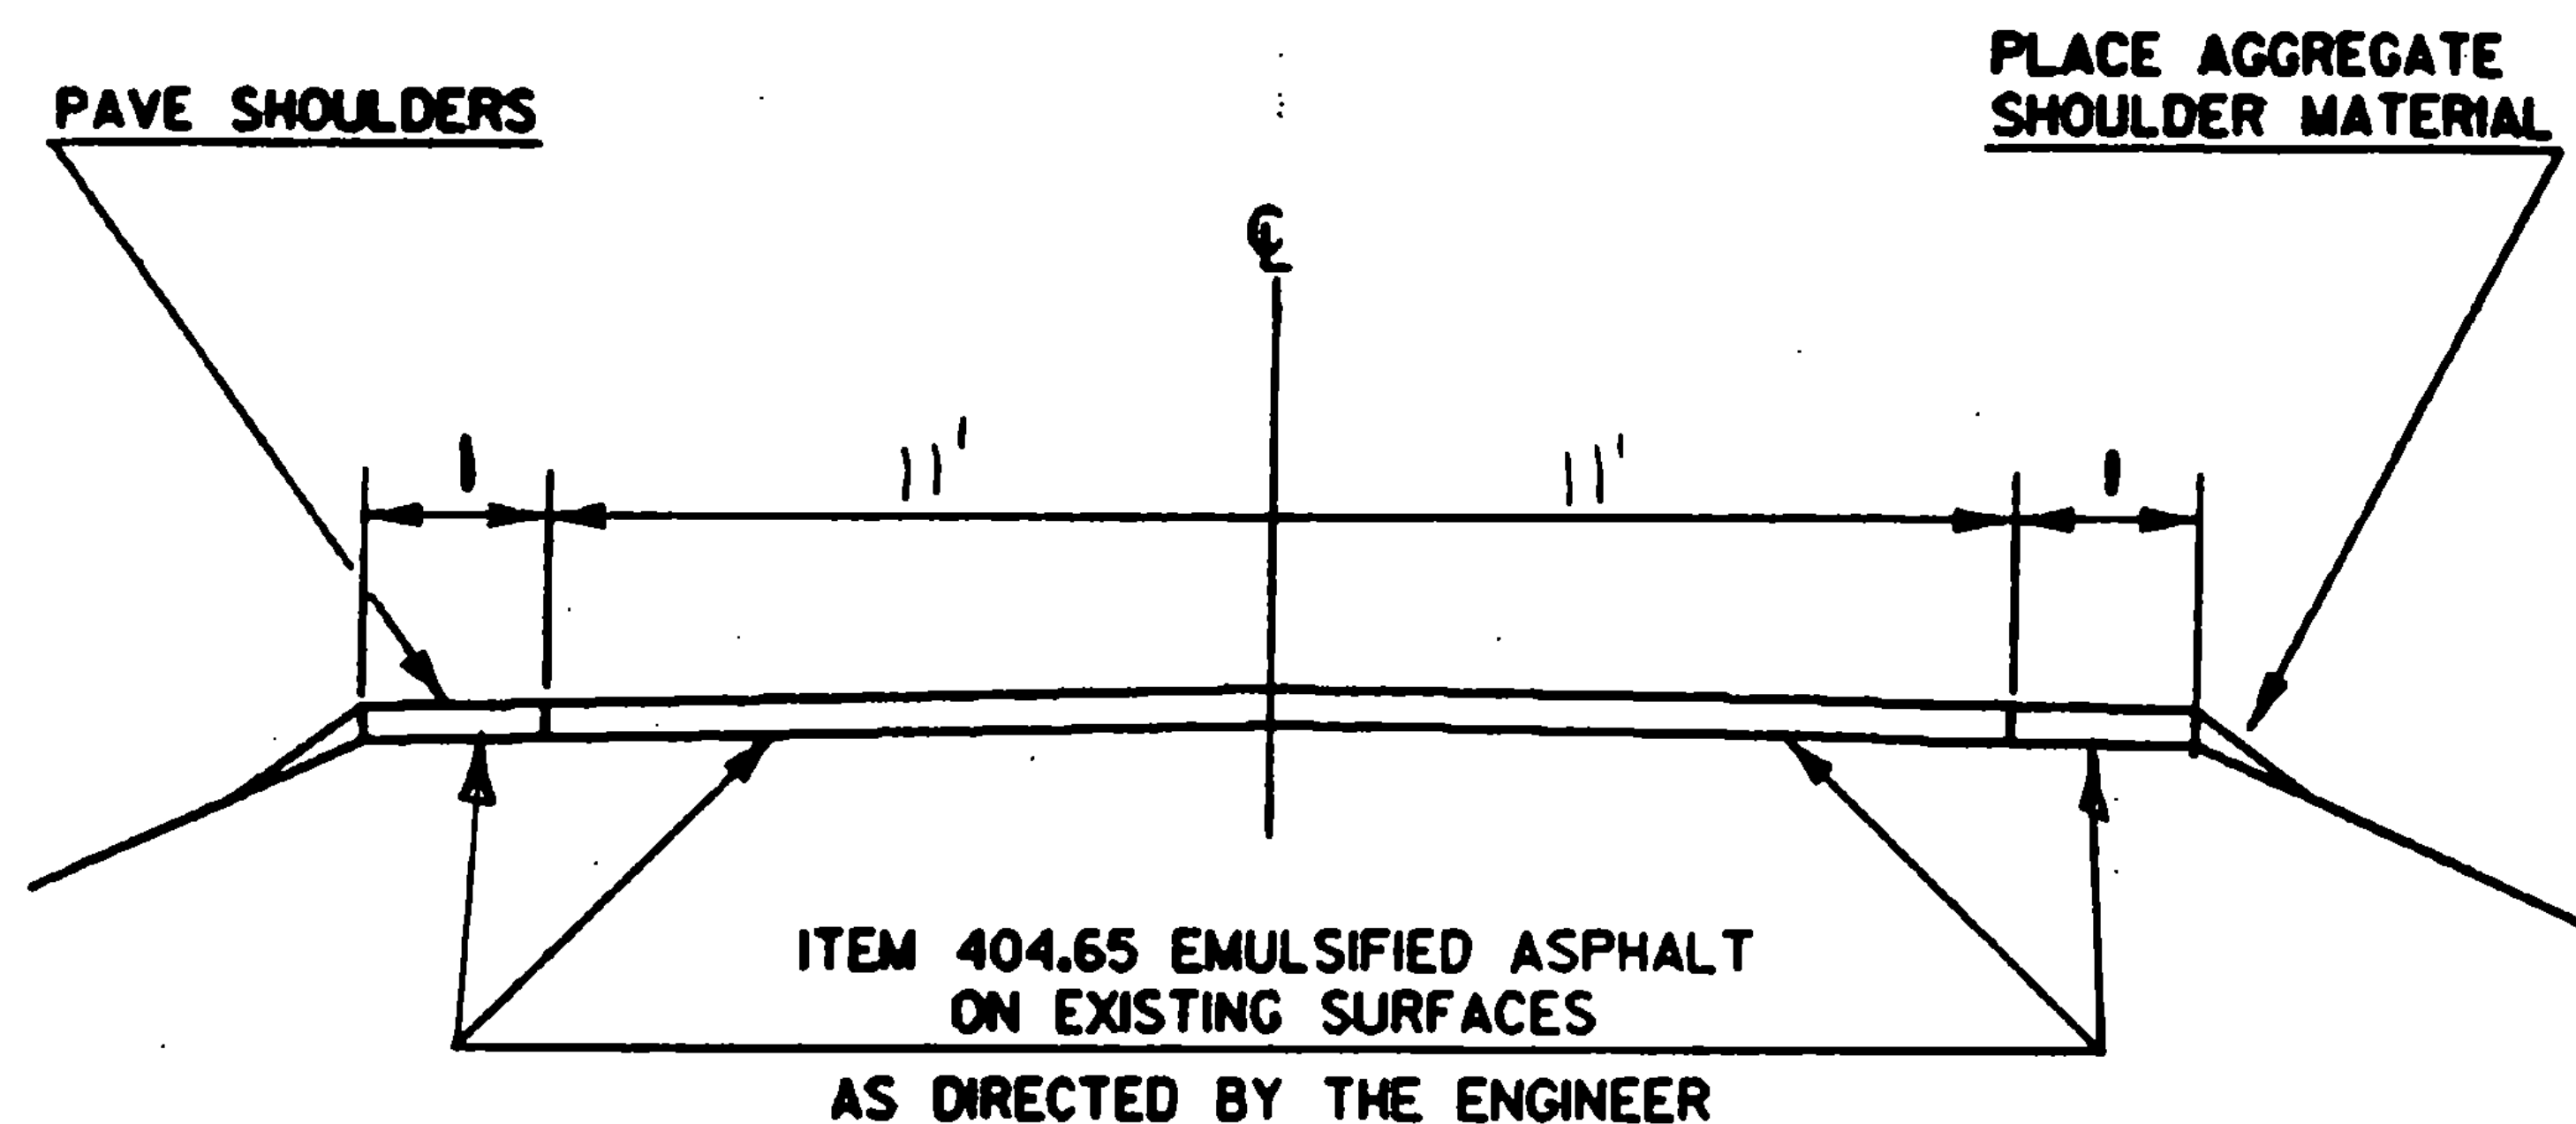

PROJECT WILMINGTON

NO. HMA 2815

SHEET 4 OF 6 SHEETS
SHEET 40 OF 64