


TYPICAL SECTIONS & DESIGN DATA

MARLBORO MM 0.280 ~ MM 0.470
ITEM 406.25 BITUMINOUS CONCRETE PAVEMENT
LEVELING COURSE TYPE IV (432 TONS/MILE)
1/4" WEARING COURSE TYPE III ($\pm 1/4"$)
AS DIRECTED BY THE ENGINEER

NOTE: ROADWAY & SHOULDER WIDTHS TAPER TO LIMITS
SHOWN STARTING AT MM 0.280 TO END OF
PROJECT.

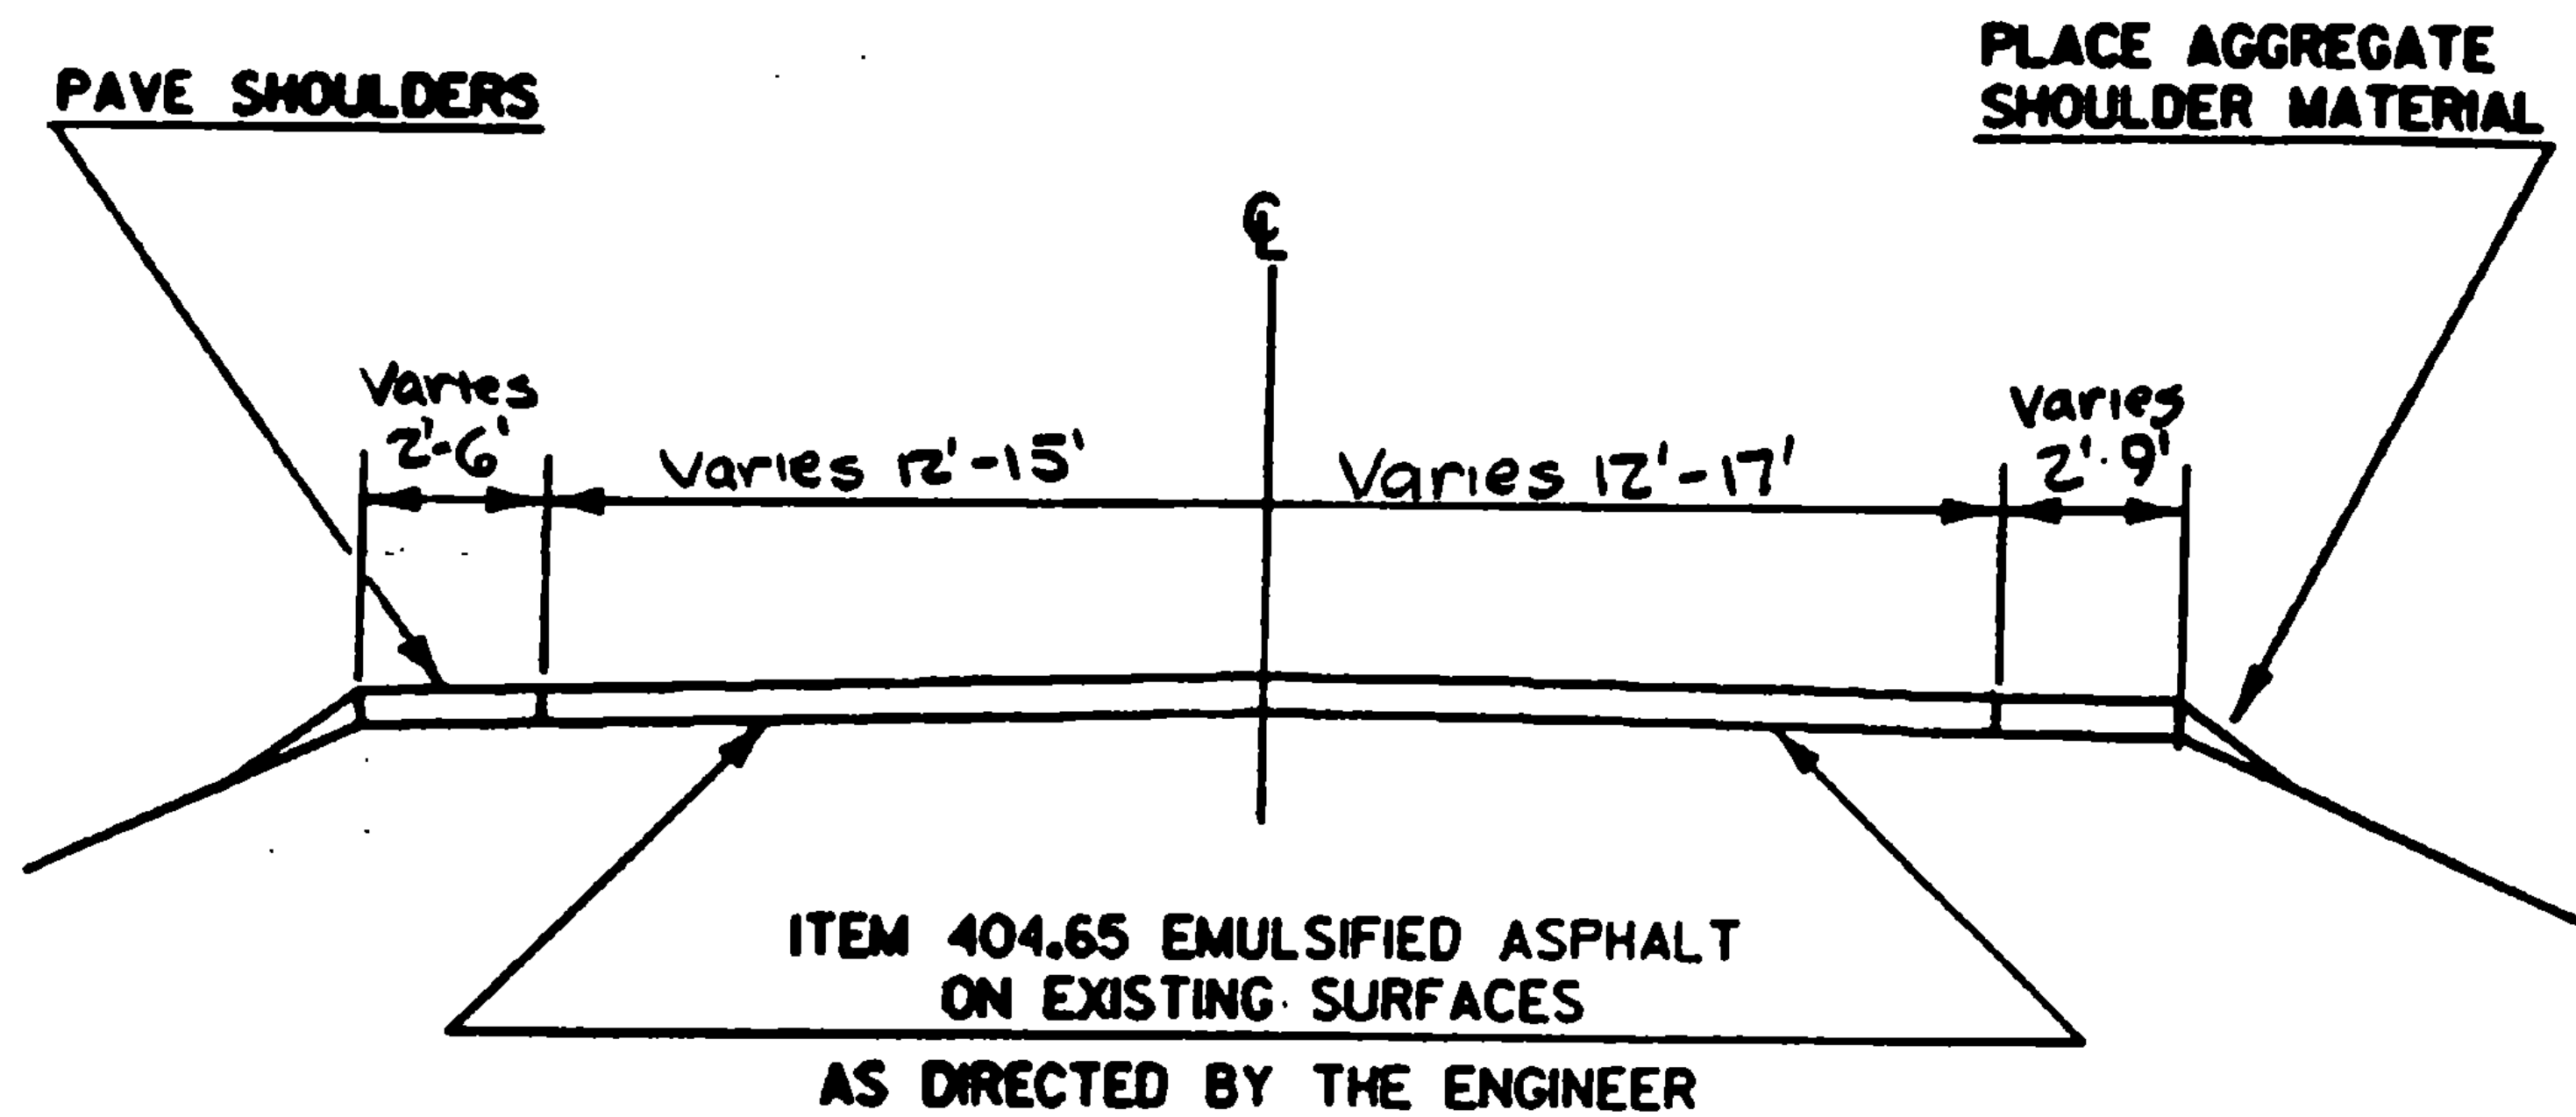

PROJECT WILMINGTON - MARLBORO

NO. HMA 2851
SHEET 5 OF 8 SHEETS
SHT. 54 OF 64