



PAVING LIMITS FOR DRIVES & TOWN ROADS

PAVING LIMITS FOR TOWN ROADS

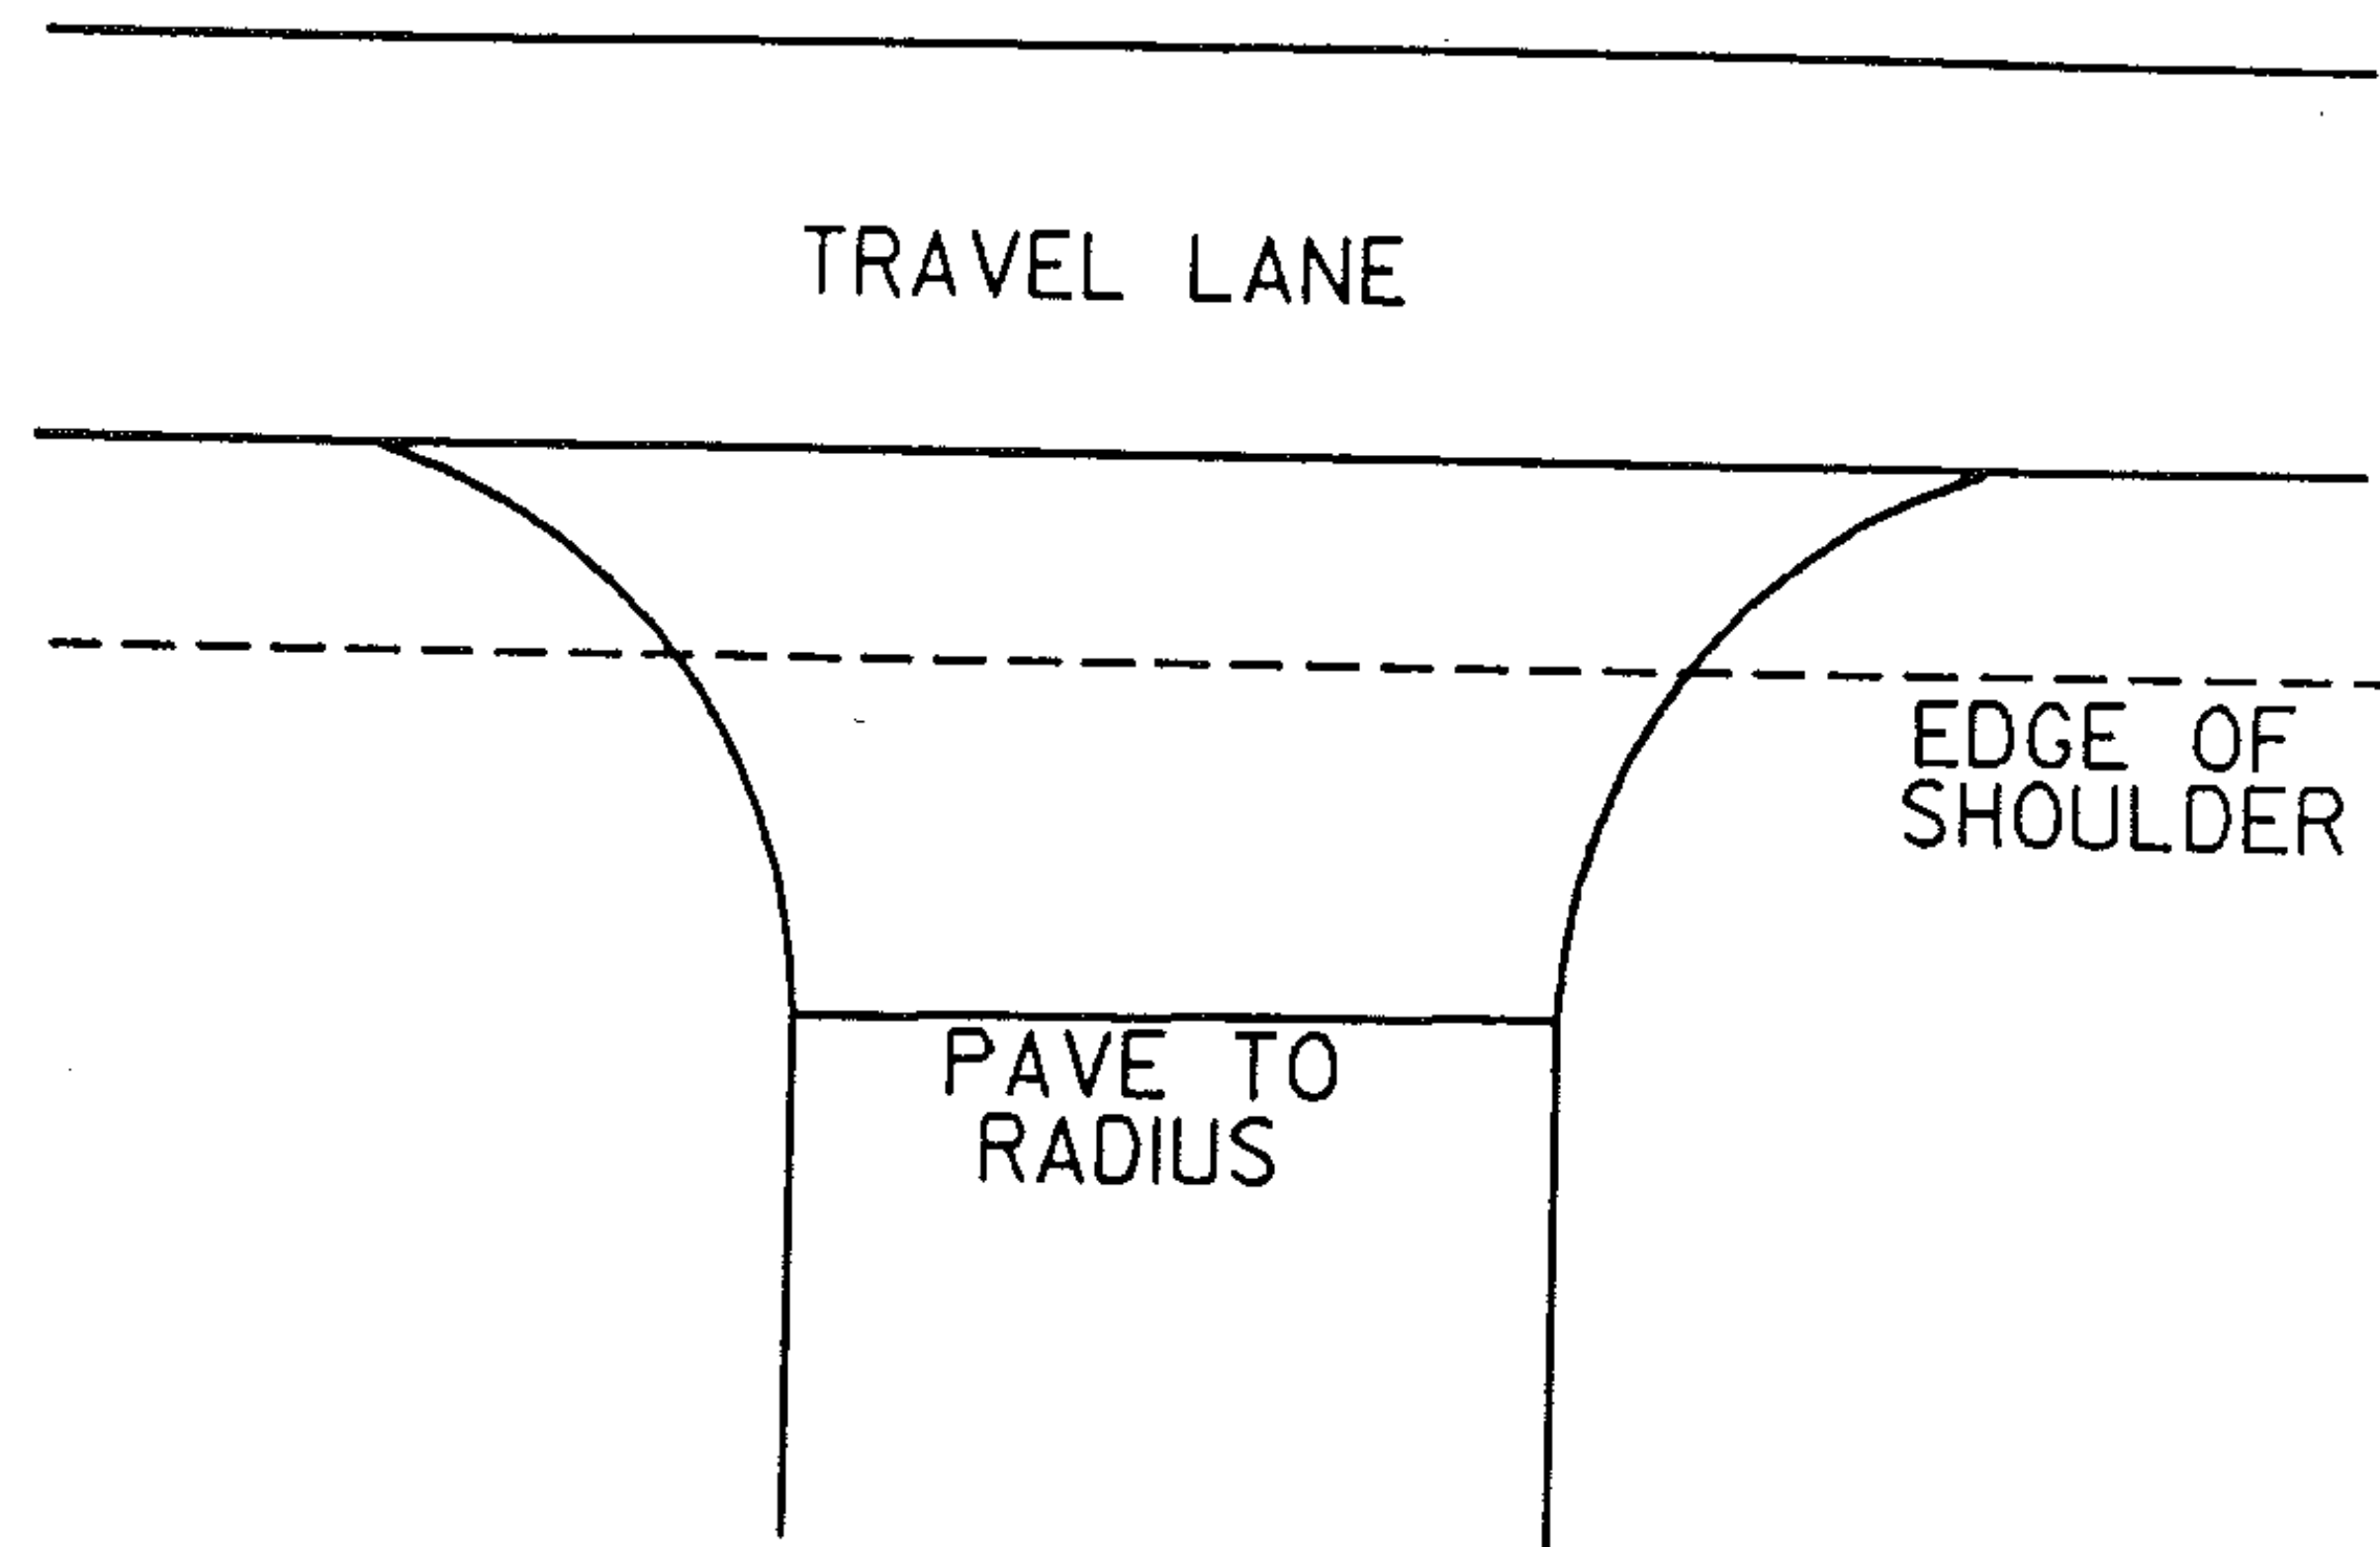

PAVING LIMITS FOR DRIVES

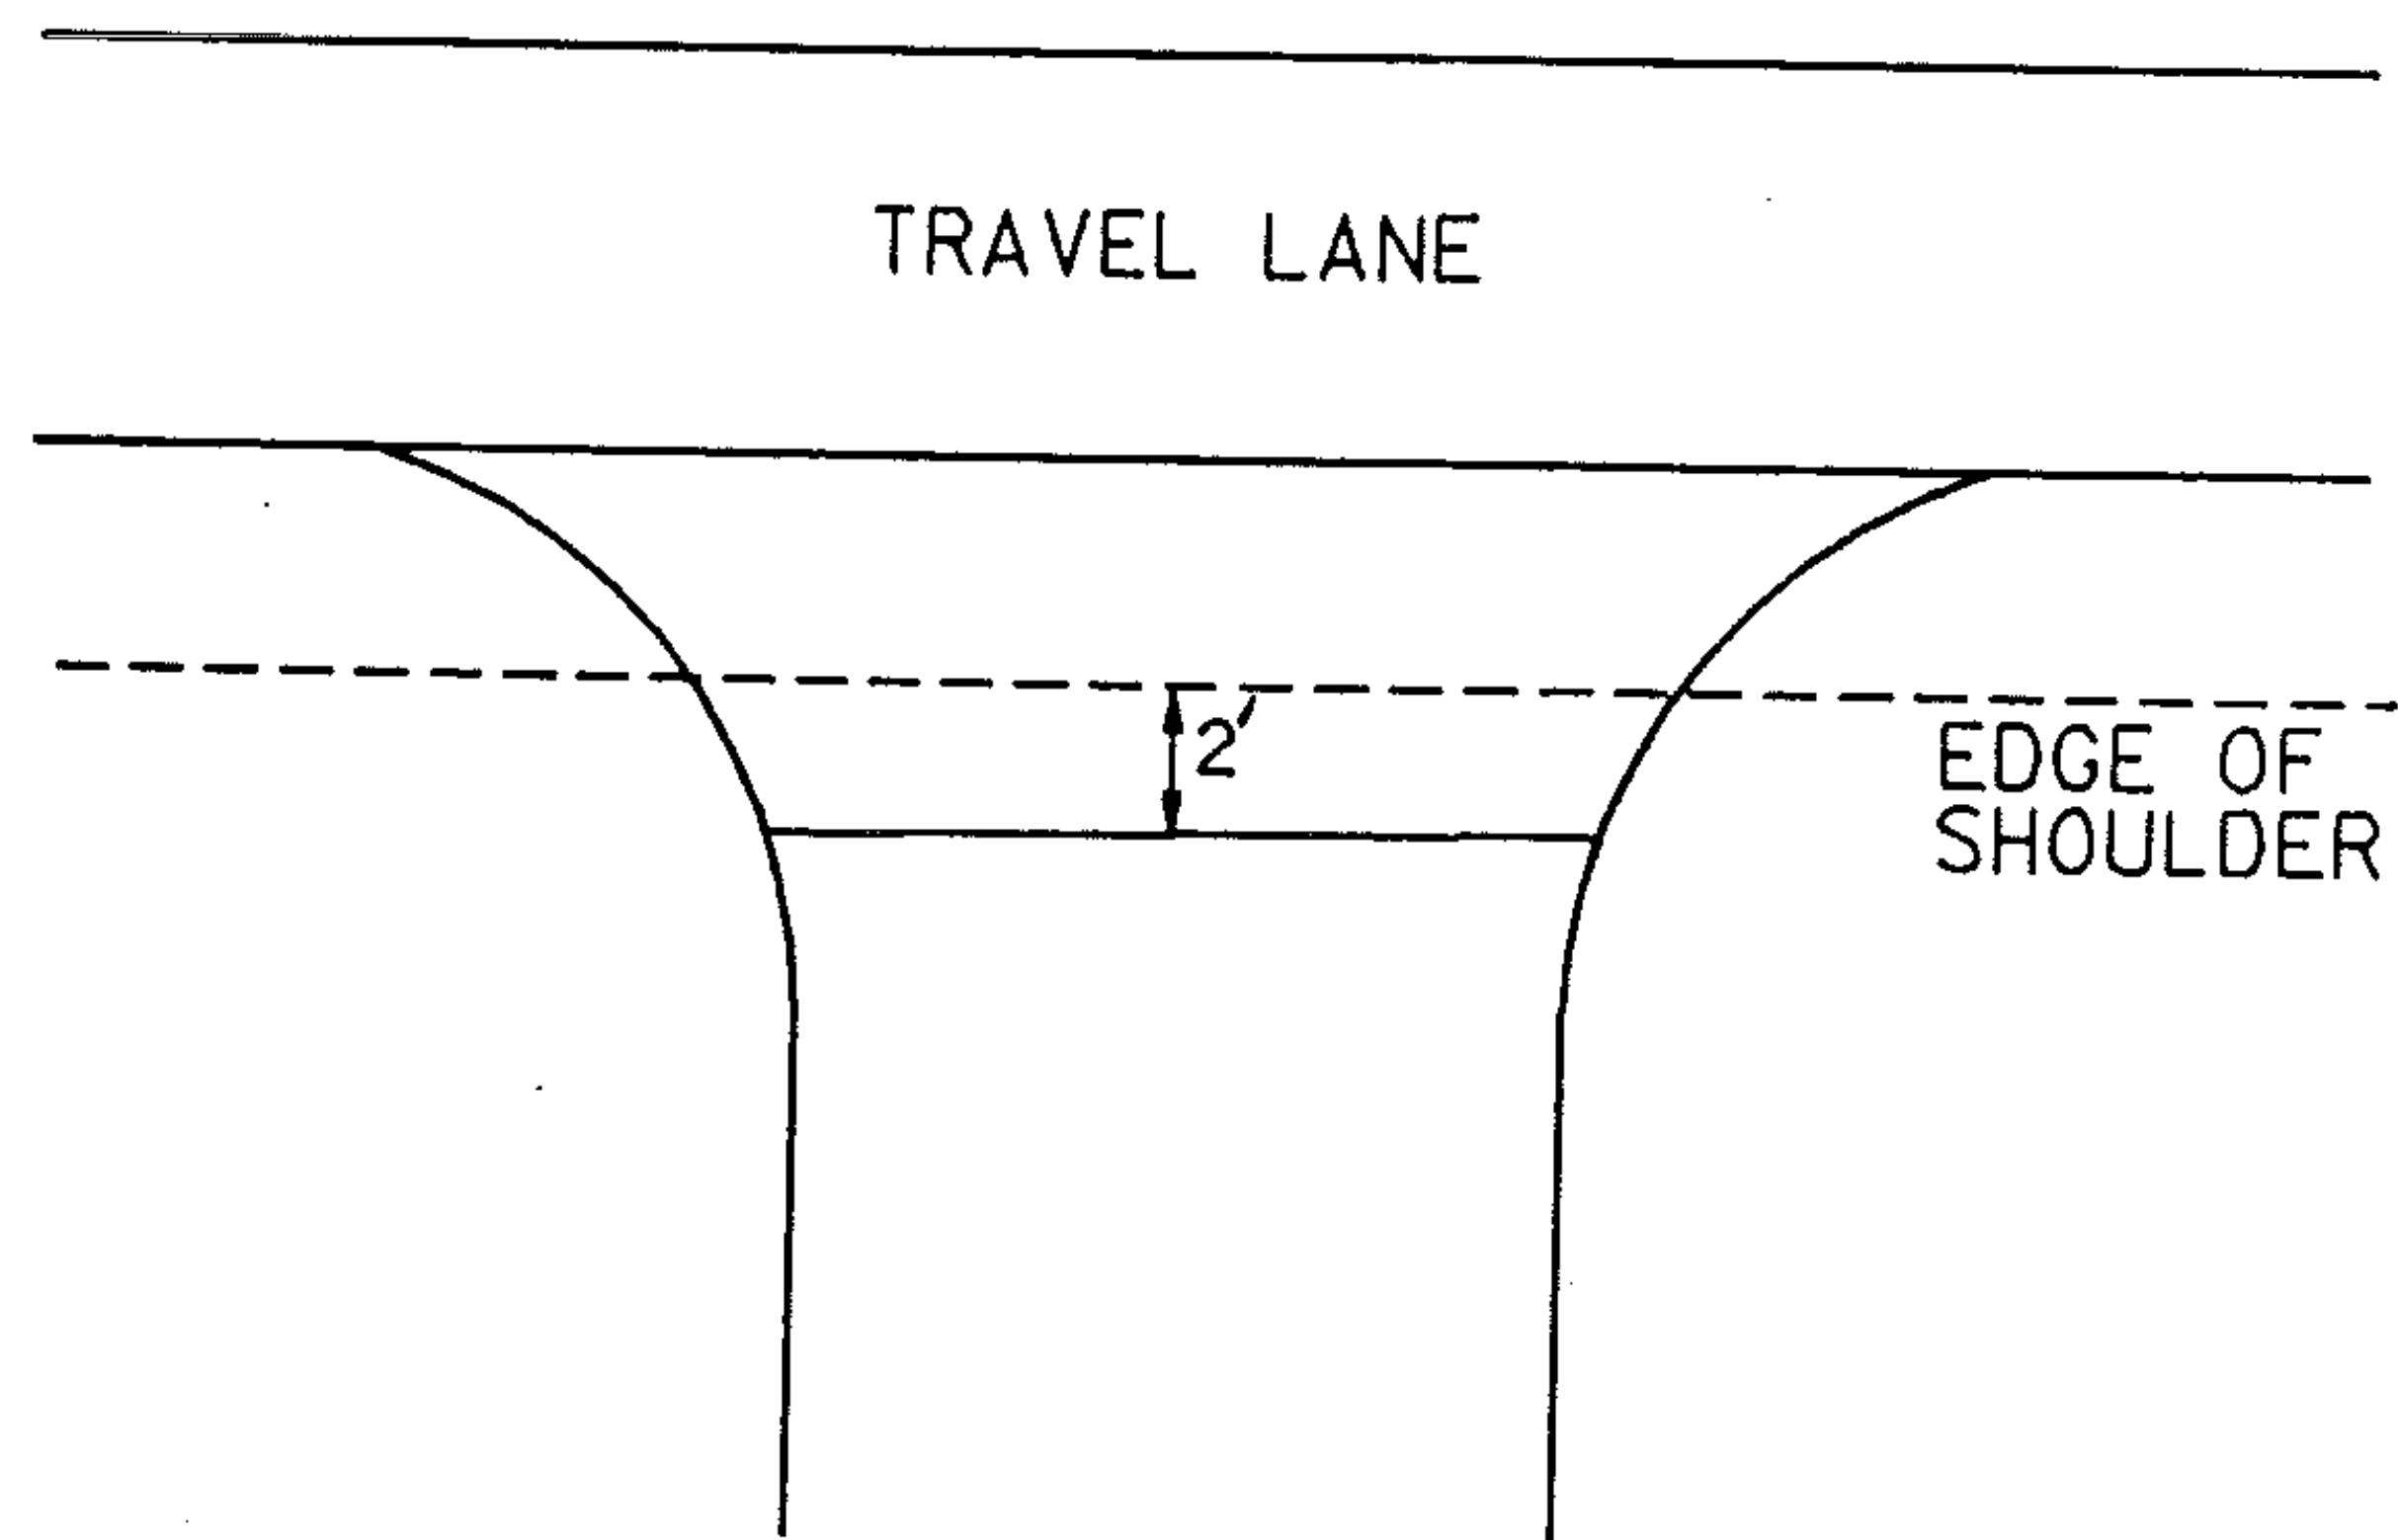

PROJECT ARLINGTON

NO. HMA 2858

SHEET 30 OF 34 SHEETS