



PAVING LIMITS FOR DRIVES & TOWN ROADS

PAVING LIMITS FOR TOWN ROADS

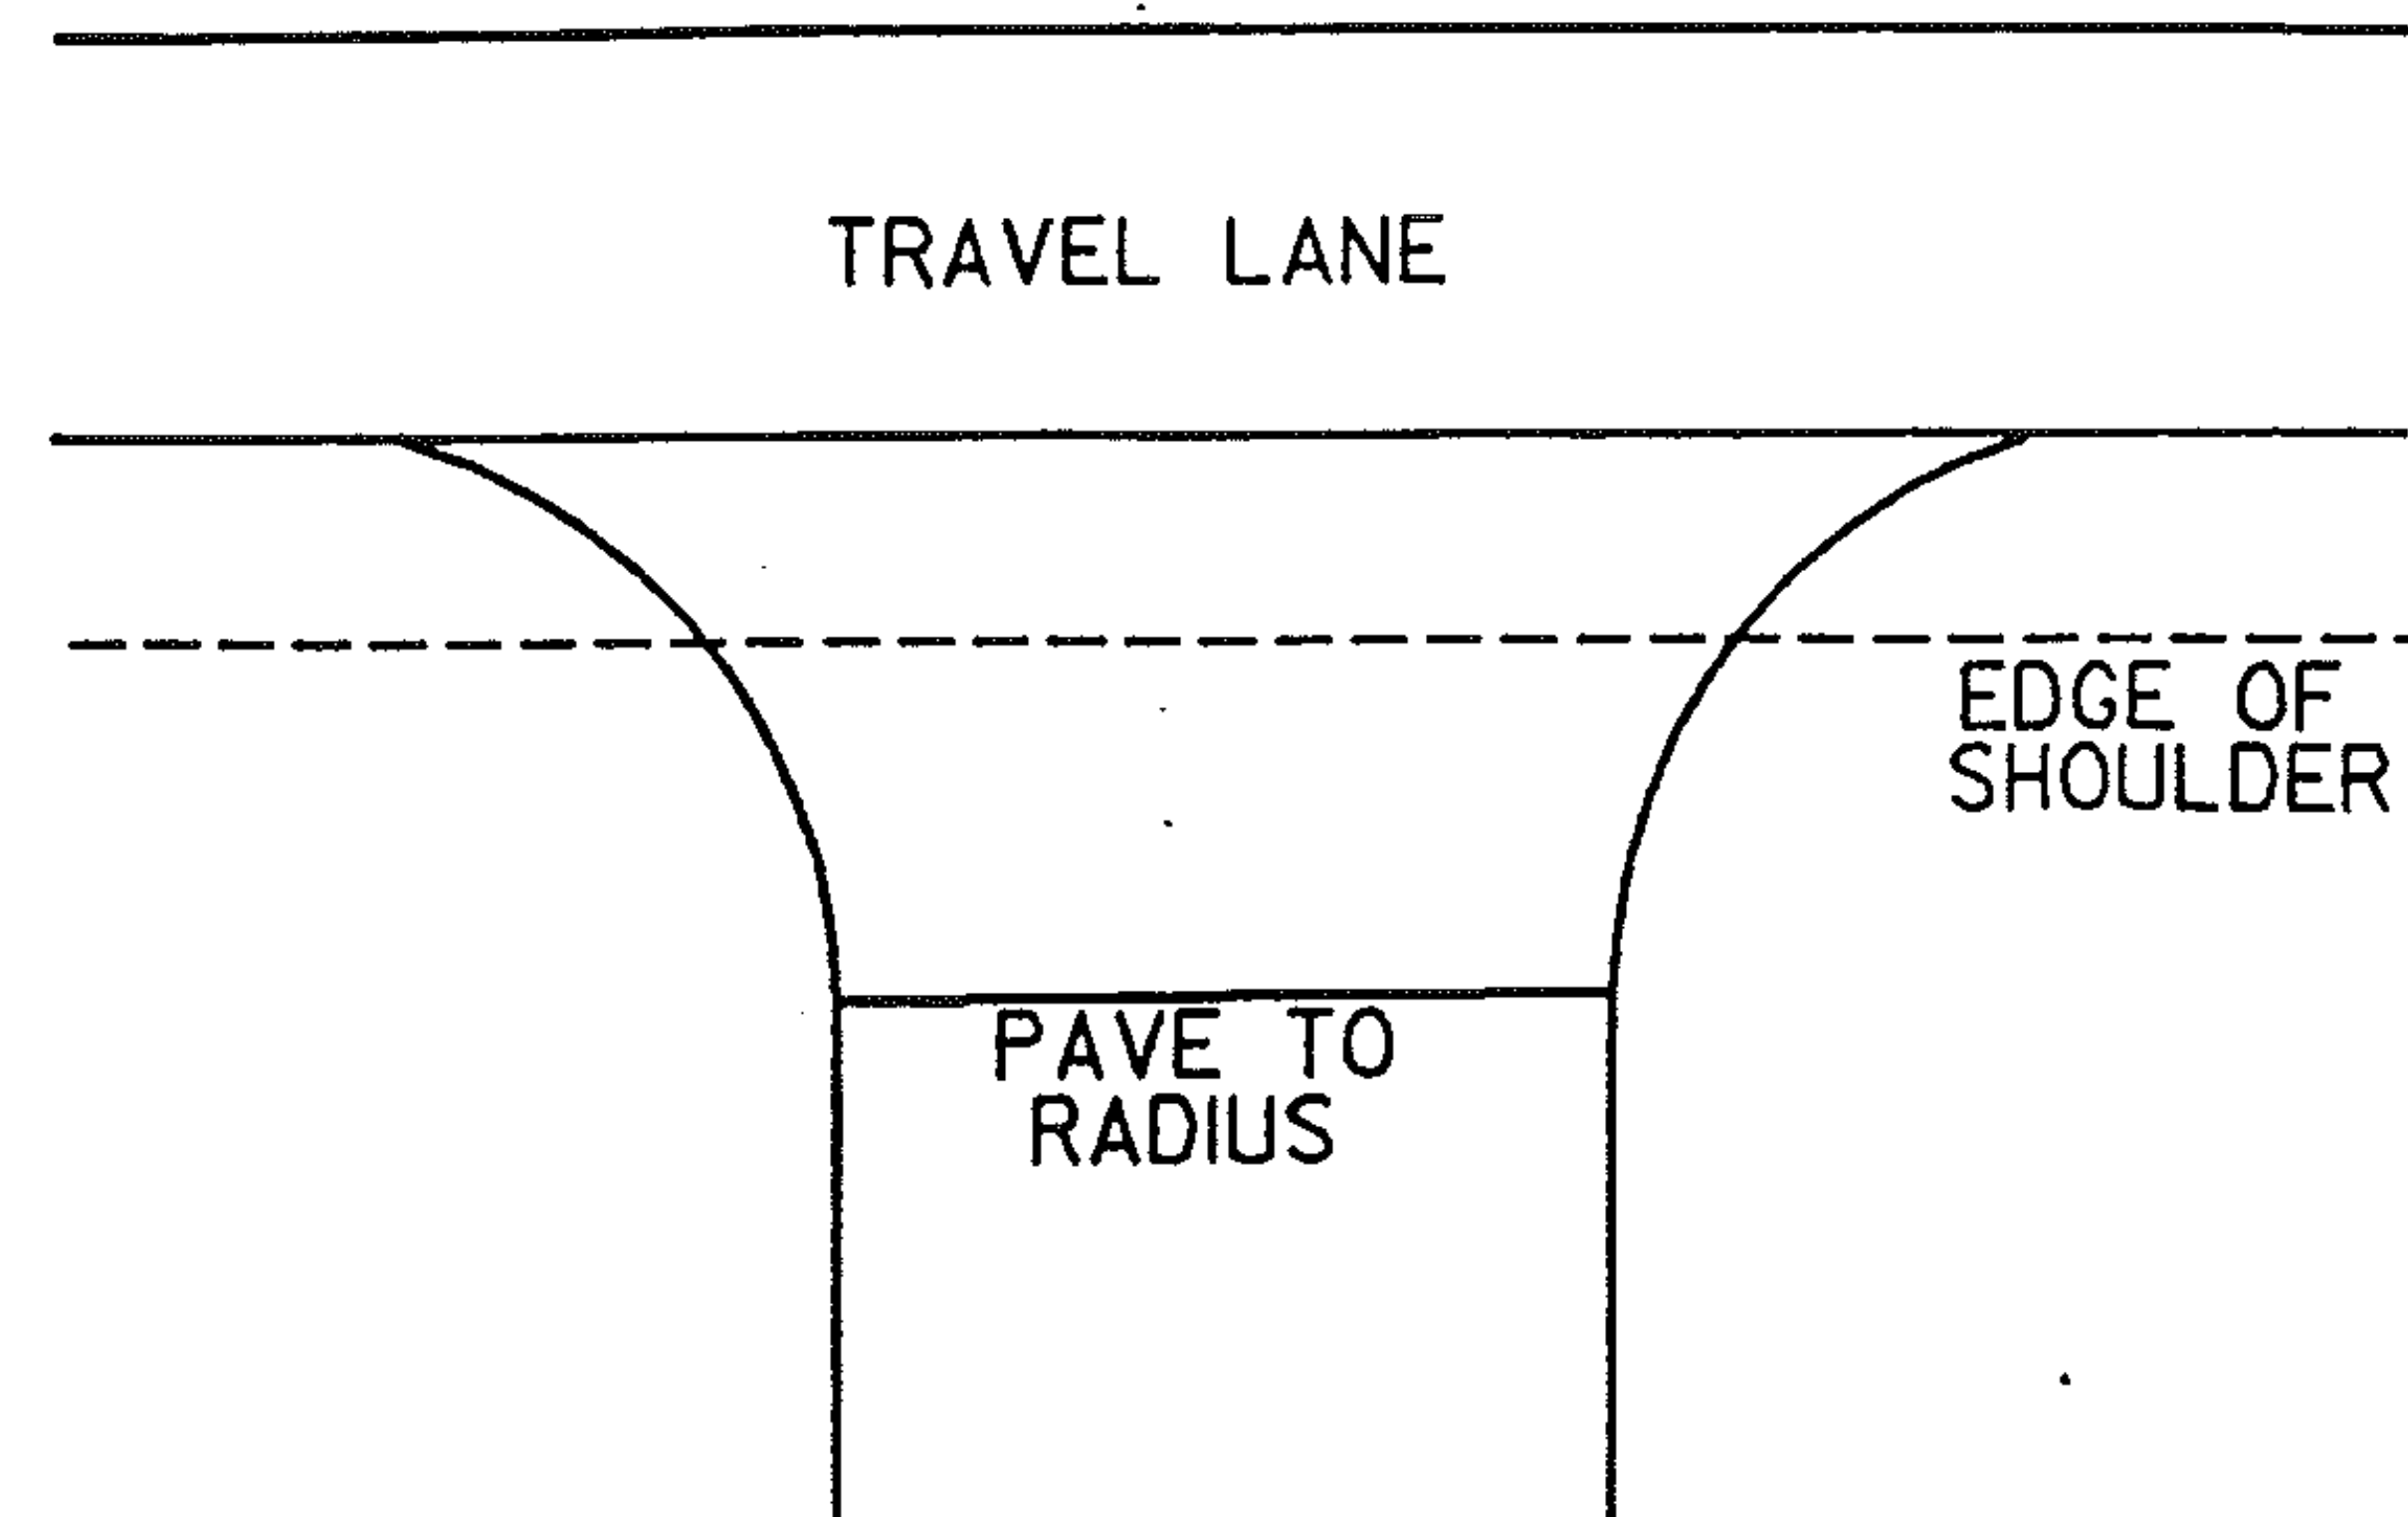

PAVING LIMITS FOR DRIVES

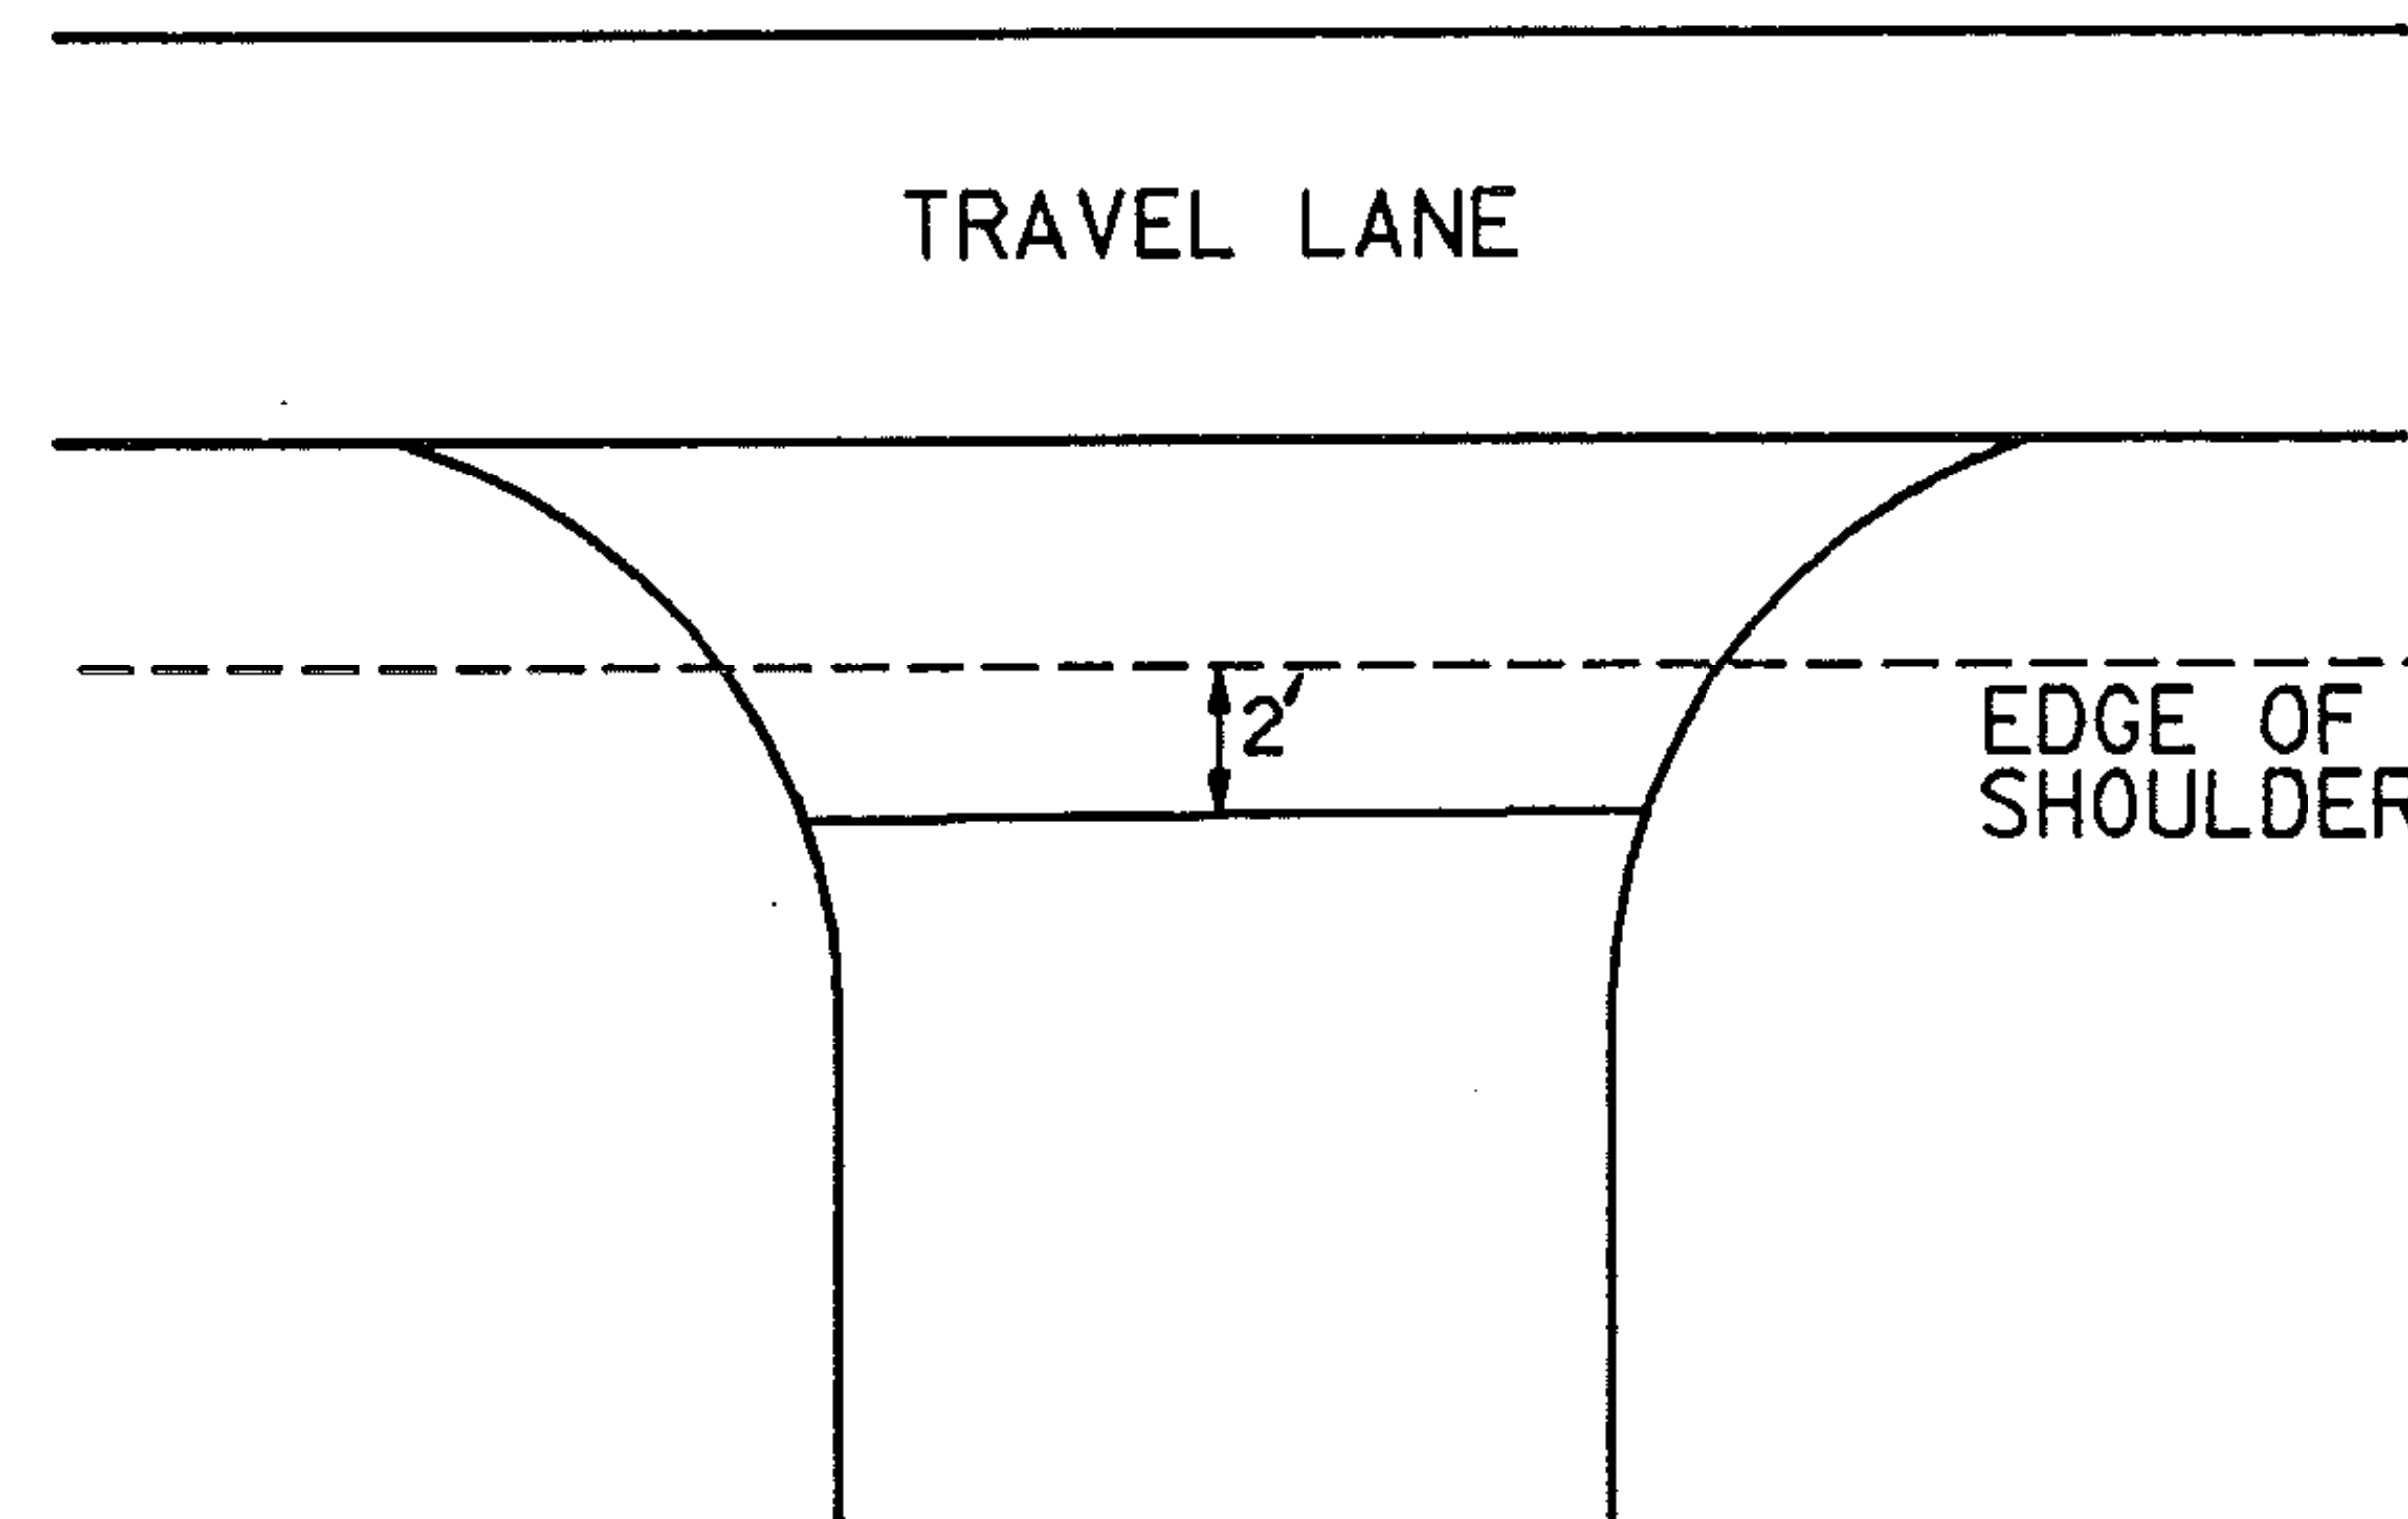

PROJECT Resurfacing Projects

NO. _____

SHEET 3 OF 75 SHEETS