


DESCRIPTION AND LOCATION

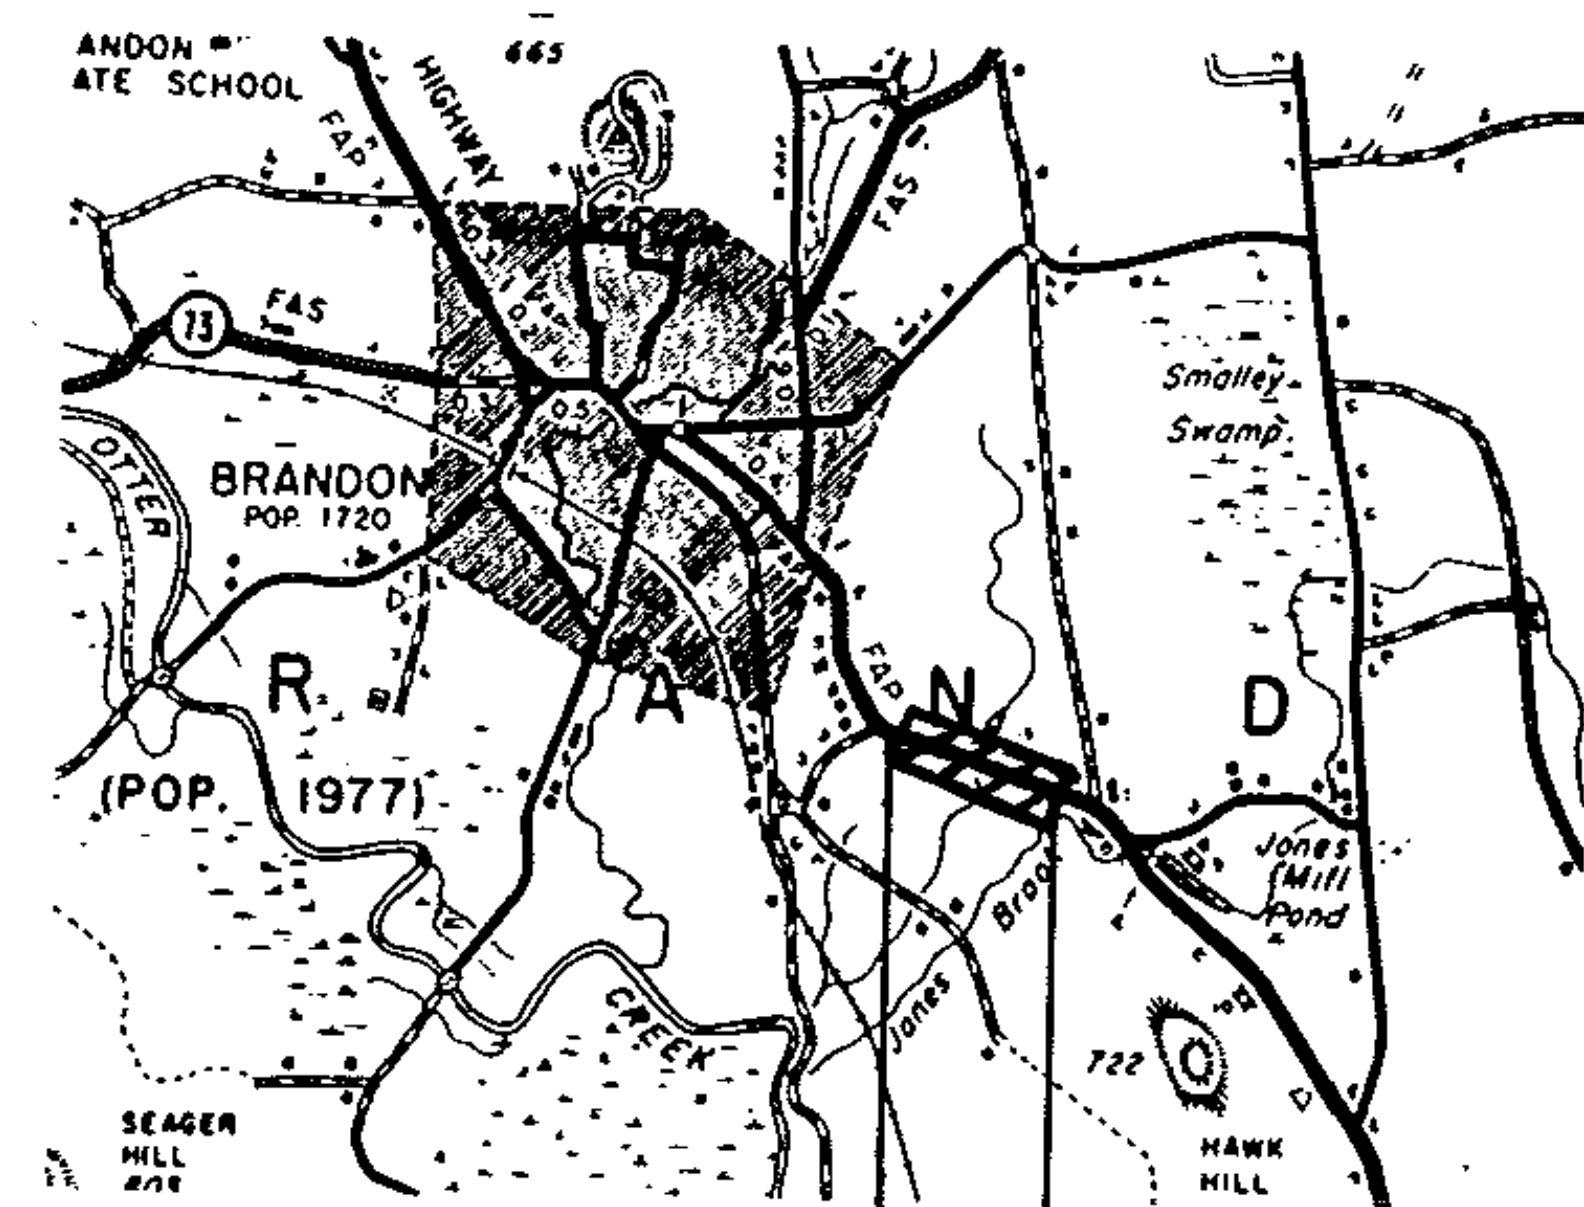

Scale: 1" = 1 mile

End Project HMA 2813
MM 2.807

Begin Project HMA 2813
MM 2.407

Beginning at a point on US 7, 2.407 miles northerly of the Pittsford - Brandon town line and extending 0.400 miles northerly to MM 2.807.

Work consists of resurfacing of the highway, including shoulders and new pavement markings

1986 ADT 6000

Length of Project 2112 feet
0.400 miles

PROJECT Brandon

NO. HMA 2813

SHEET 3 OF 7 SHEETS

SHEET 23 OF 75 SHEETS