


DESCRIPTION AND LOCATION

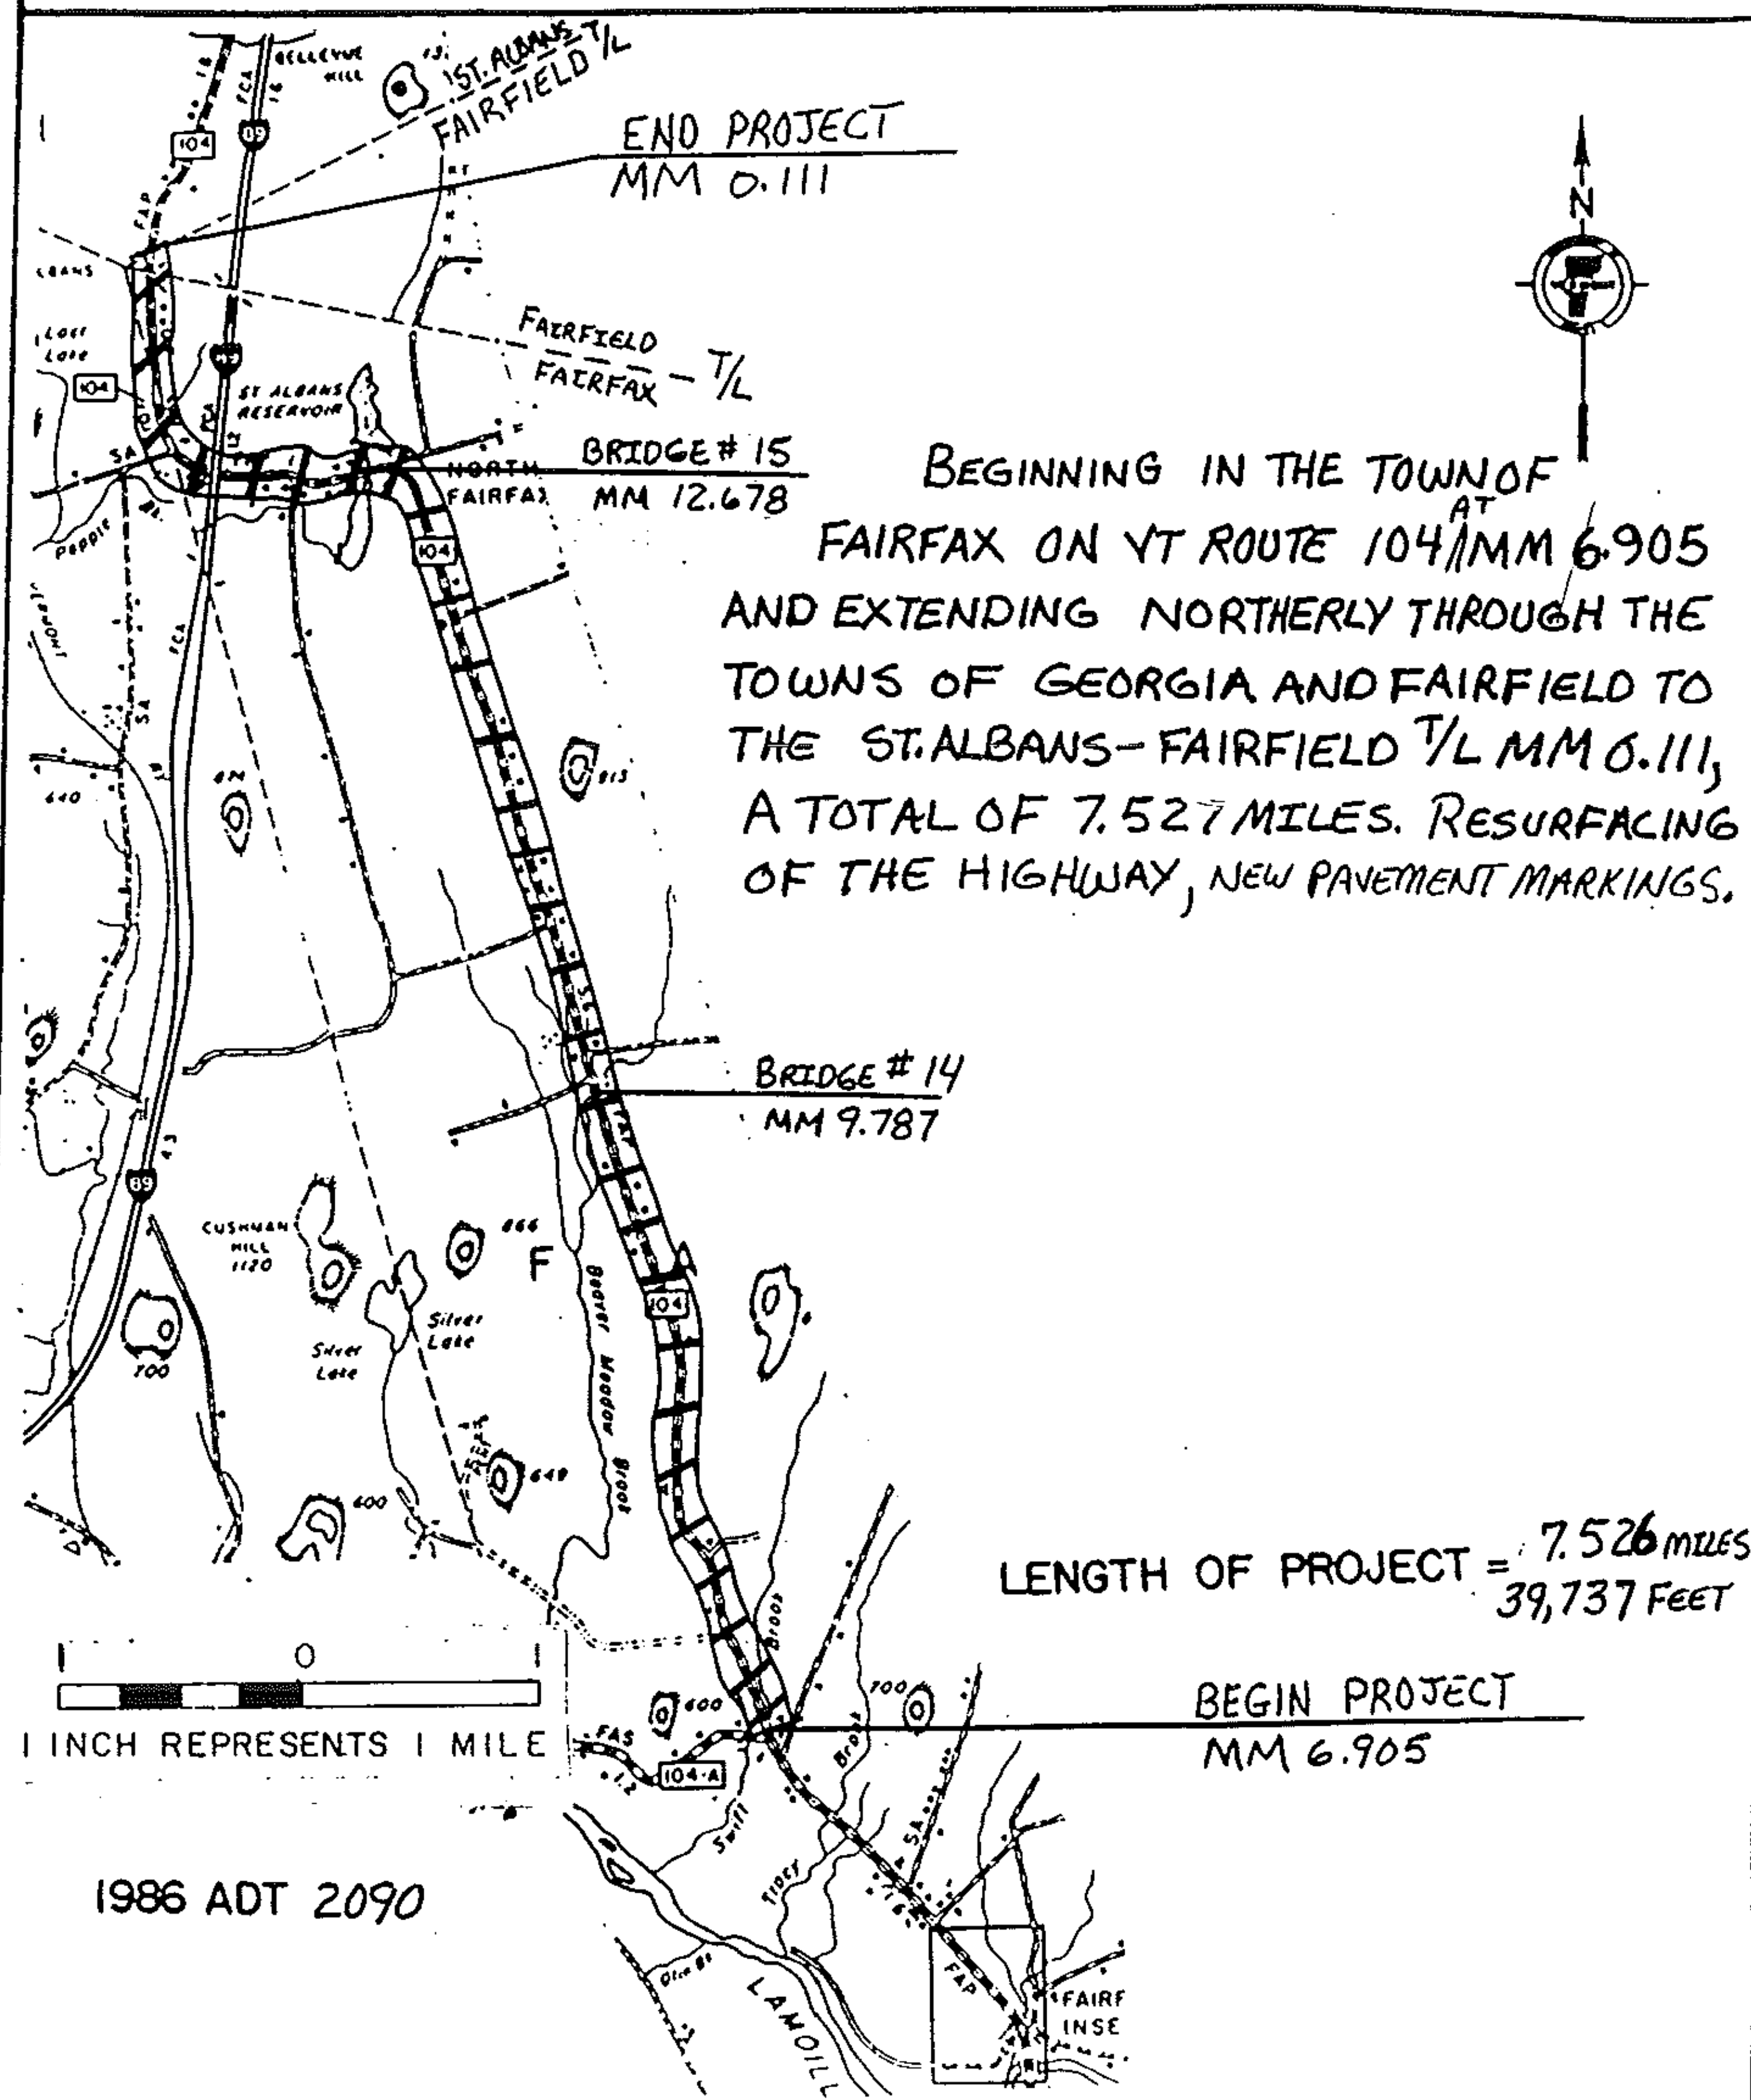

BEGINNING IN THE TOWN OF
FAIRFAX ON VT ROUTE 104 AT MM 6.905
AND EXTENDING NORTHERLY THROUGH THE
TOWNS OF GEORGIA AND FAIRFIELD TO
THE ST. ALBANS-FAIRFIELD T/L MM 0.111,
A TOTAL OF 7.527 MILES. RESURFACING
OF THE HIGHWAY, NEW PAVEMENT MARKINGS.

LENGTH OF PROJECT = 7.526 MILES
39,737 FEET

BEGIN PROJECT
MM 6.905

PROJECT FAIRFAX - GEORGIA - FAIRFIELD

NO. HMA 2836

SHEET 19 OF 60 SHEETS