


DESCRIPTION AND LOCATION

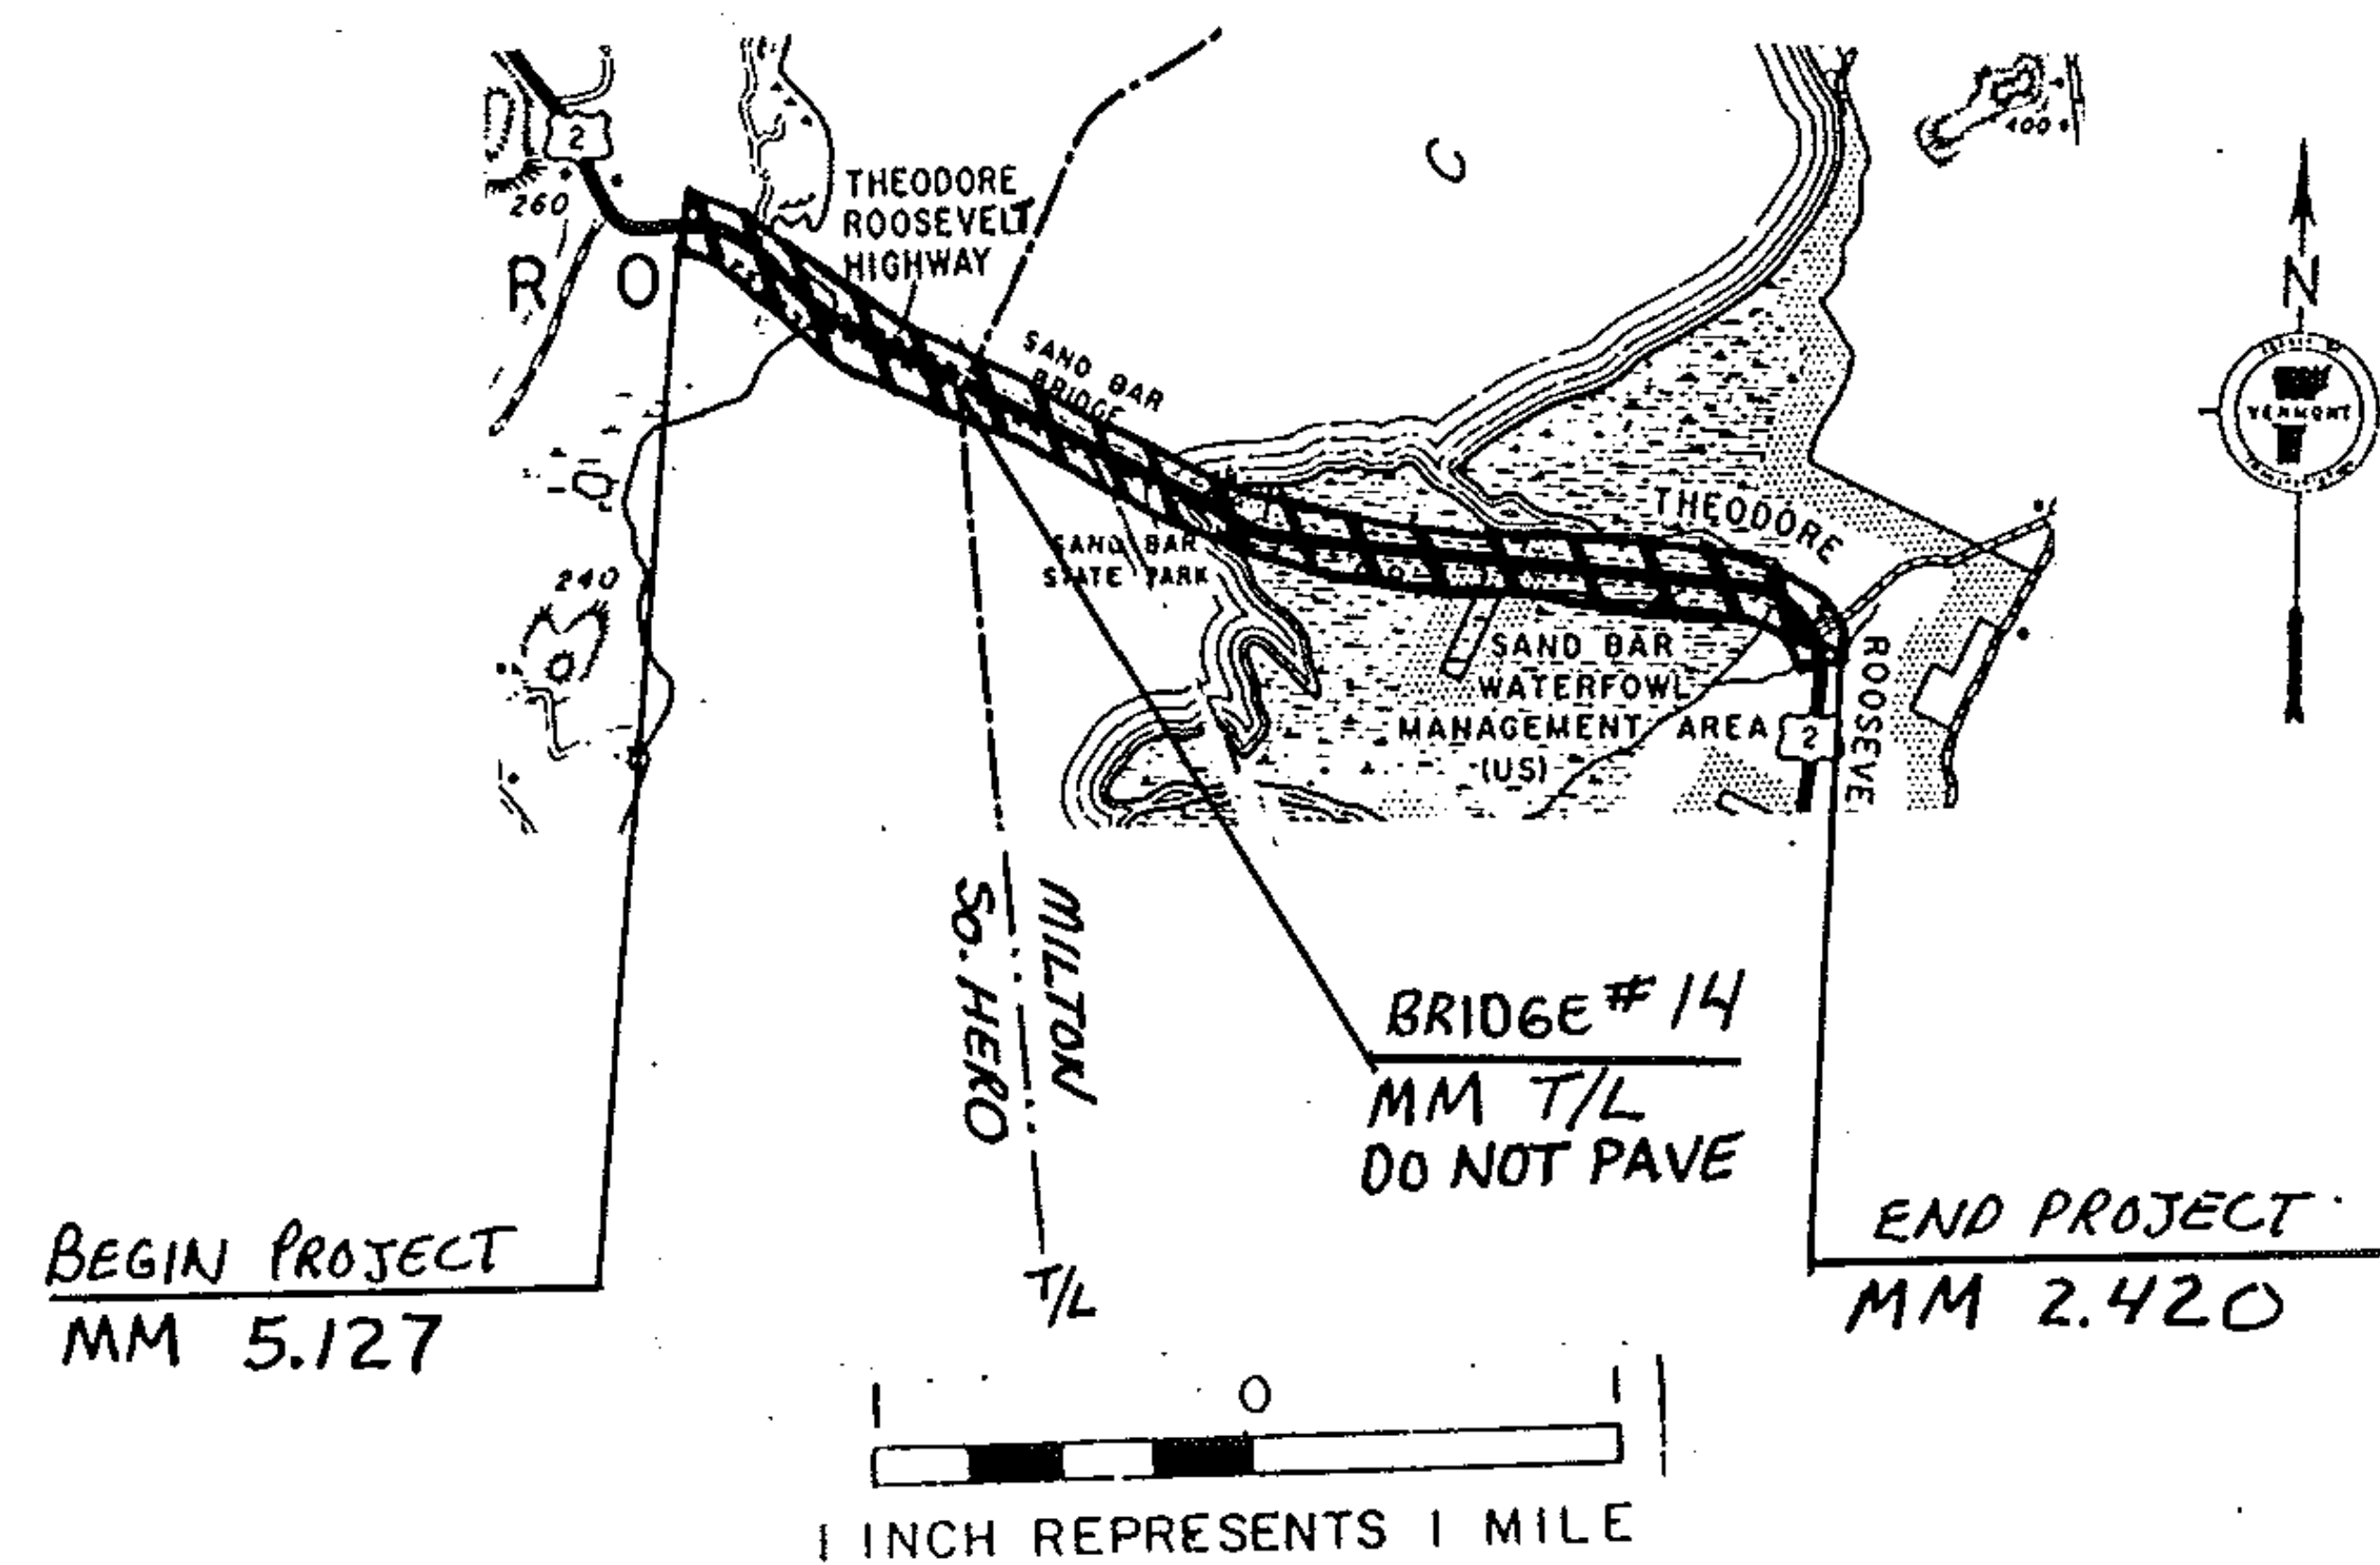

BEGINNING IN THE TOWN OF SO. HERO AT MM 5.127 ON US2, AND EXTENDING EAST 3.174 MILES TO MM 2.42 IN THE TOWN OF MILTON. RESURFACING AND NEW PAVEMENT MARKINGS.

LENGTH : 3.174 MILES
16759 FEET

1984 ADT: 5290

PROJECT So. Hero - Milton

NO. HMA 2850

SHEET 31 OF 60 SHEETS