


TYPICAL SECTIONS & DESIGN DATA

ITEM 406.25 BITUMINOUS CONCRETE PAVEMENT
LEVELING COURSE TYPE IV (45 STONS/MILE)
1/2" WEARING COURSE TYPE III ($\pm 1/4"$)
AS DIRECTED BY THE ENGINEER

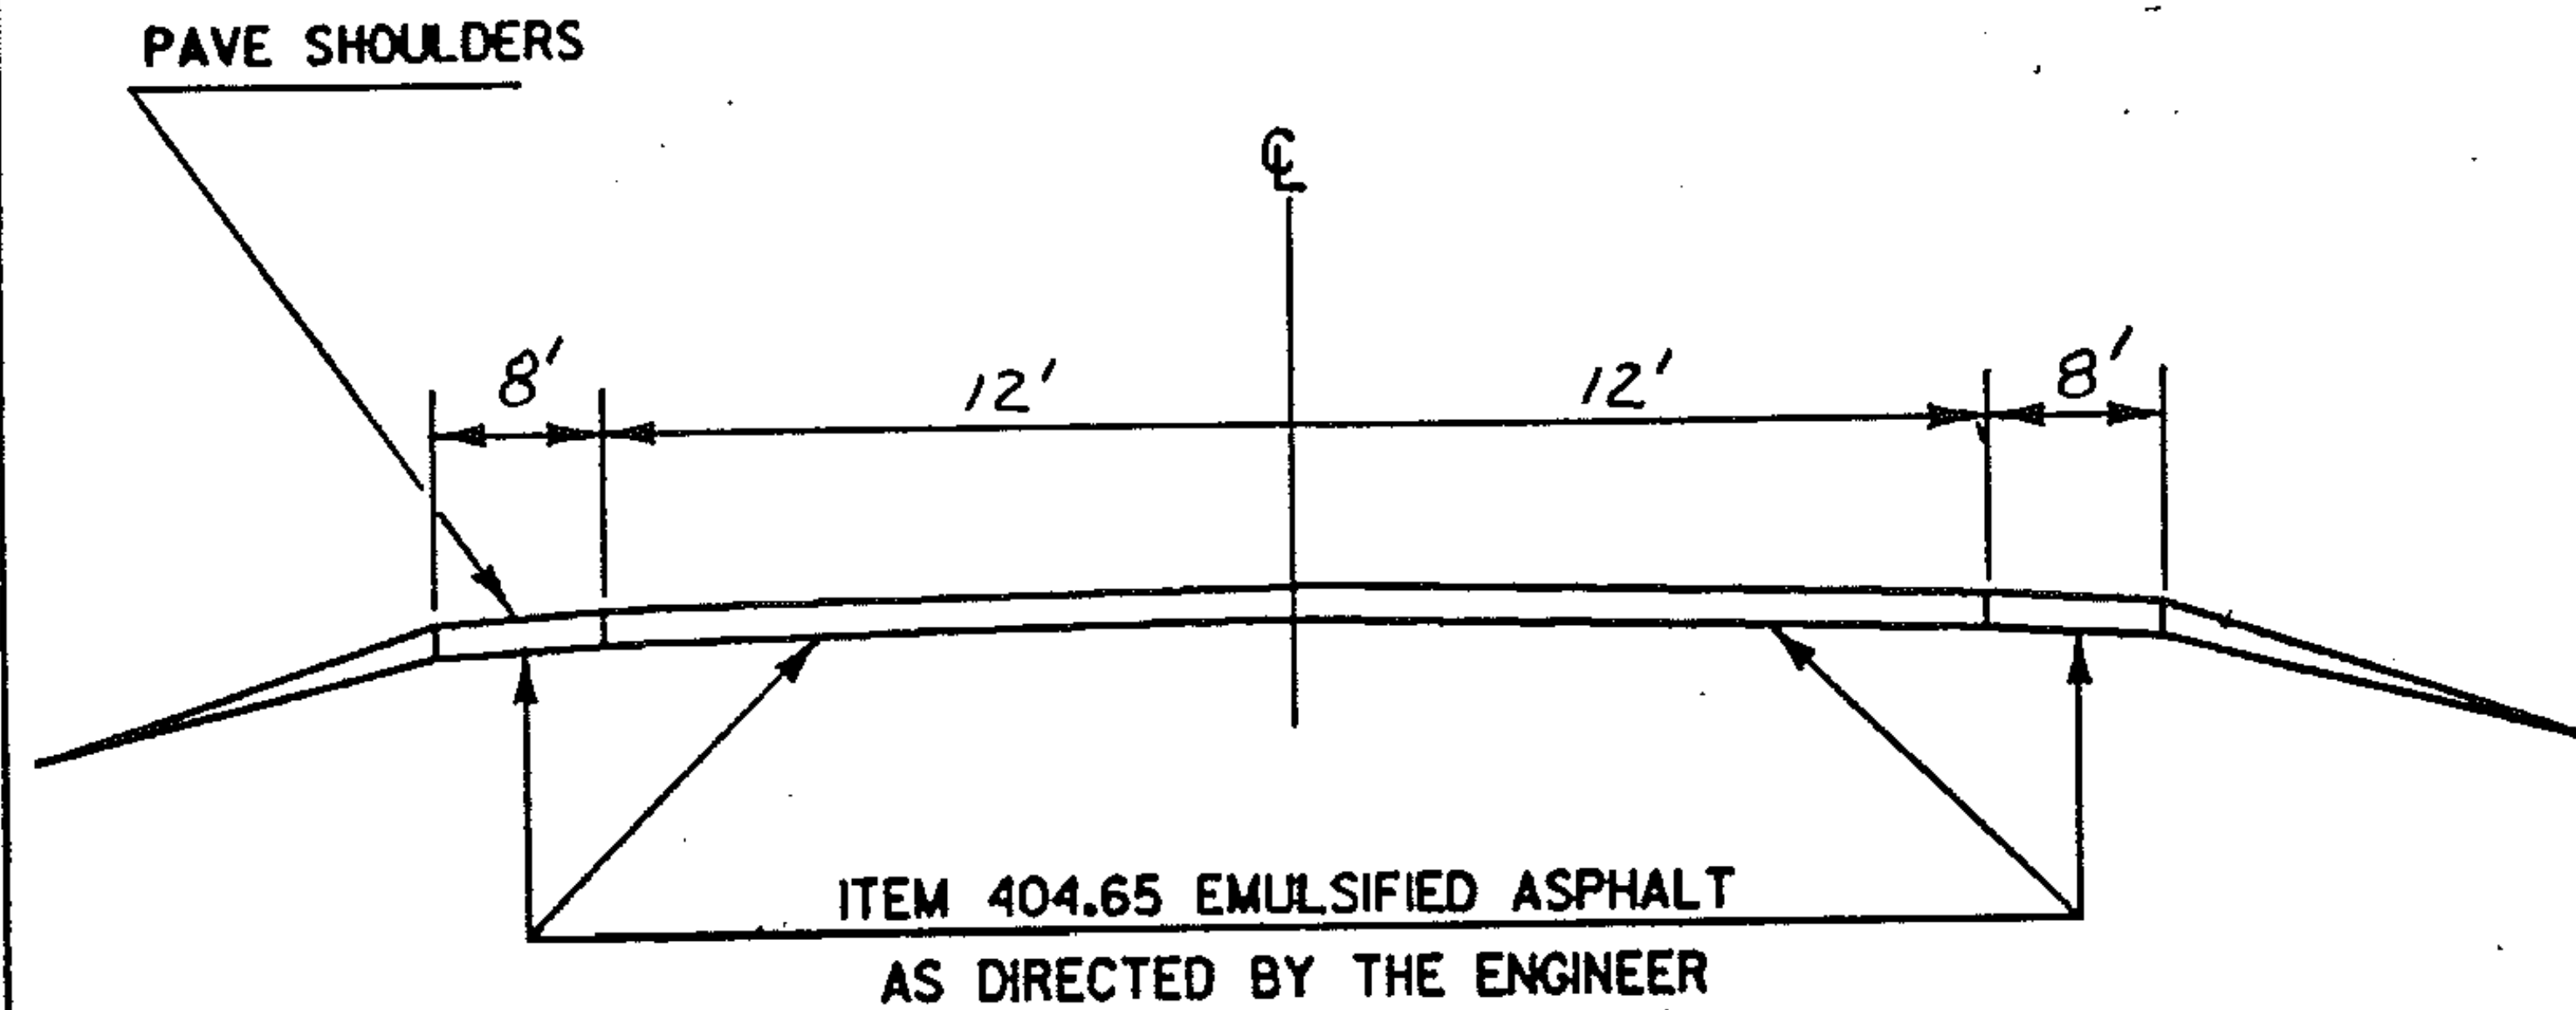

US 2 So. HERO MM 5.127 ~ MILTON MM 2.420

PROJECT So. HERO - MILTON

NO. HMA 2850

SHEET 32 OF 60 SHEETS