


DESCRIPTION AND LOCATION

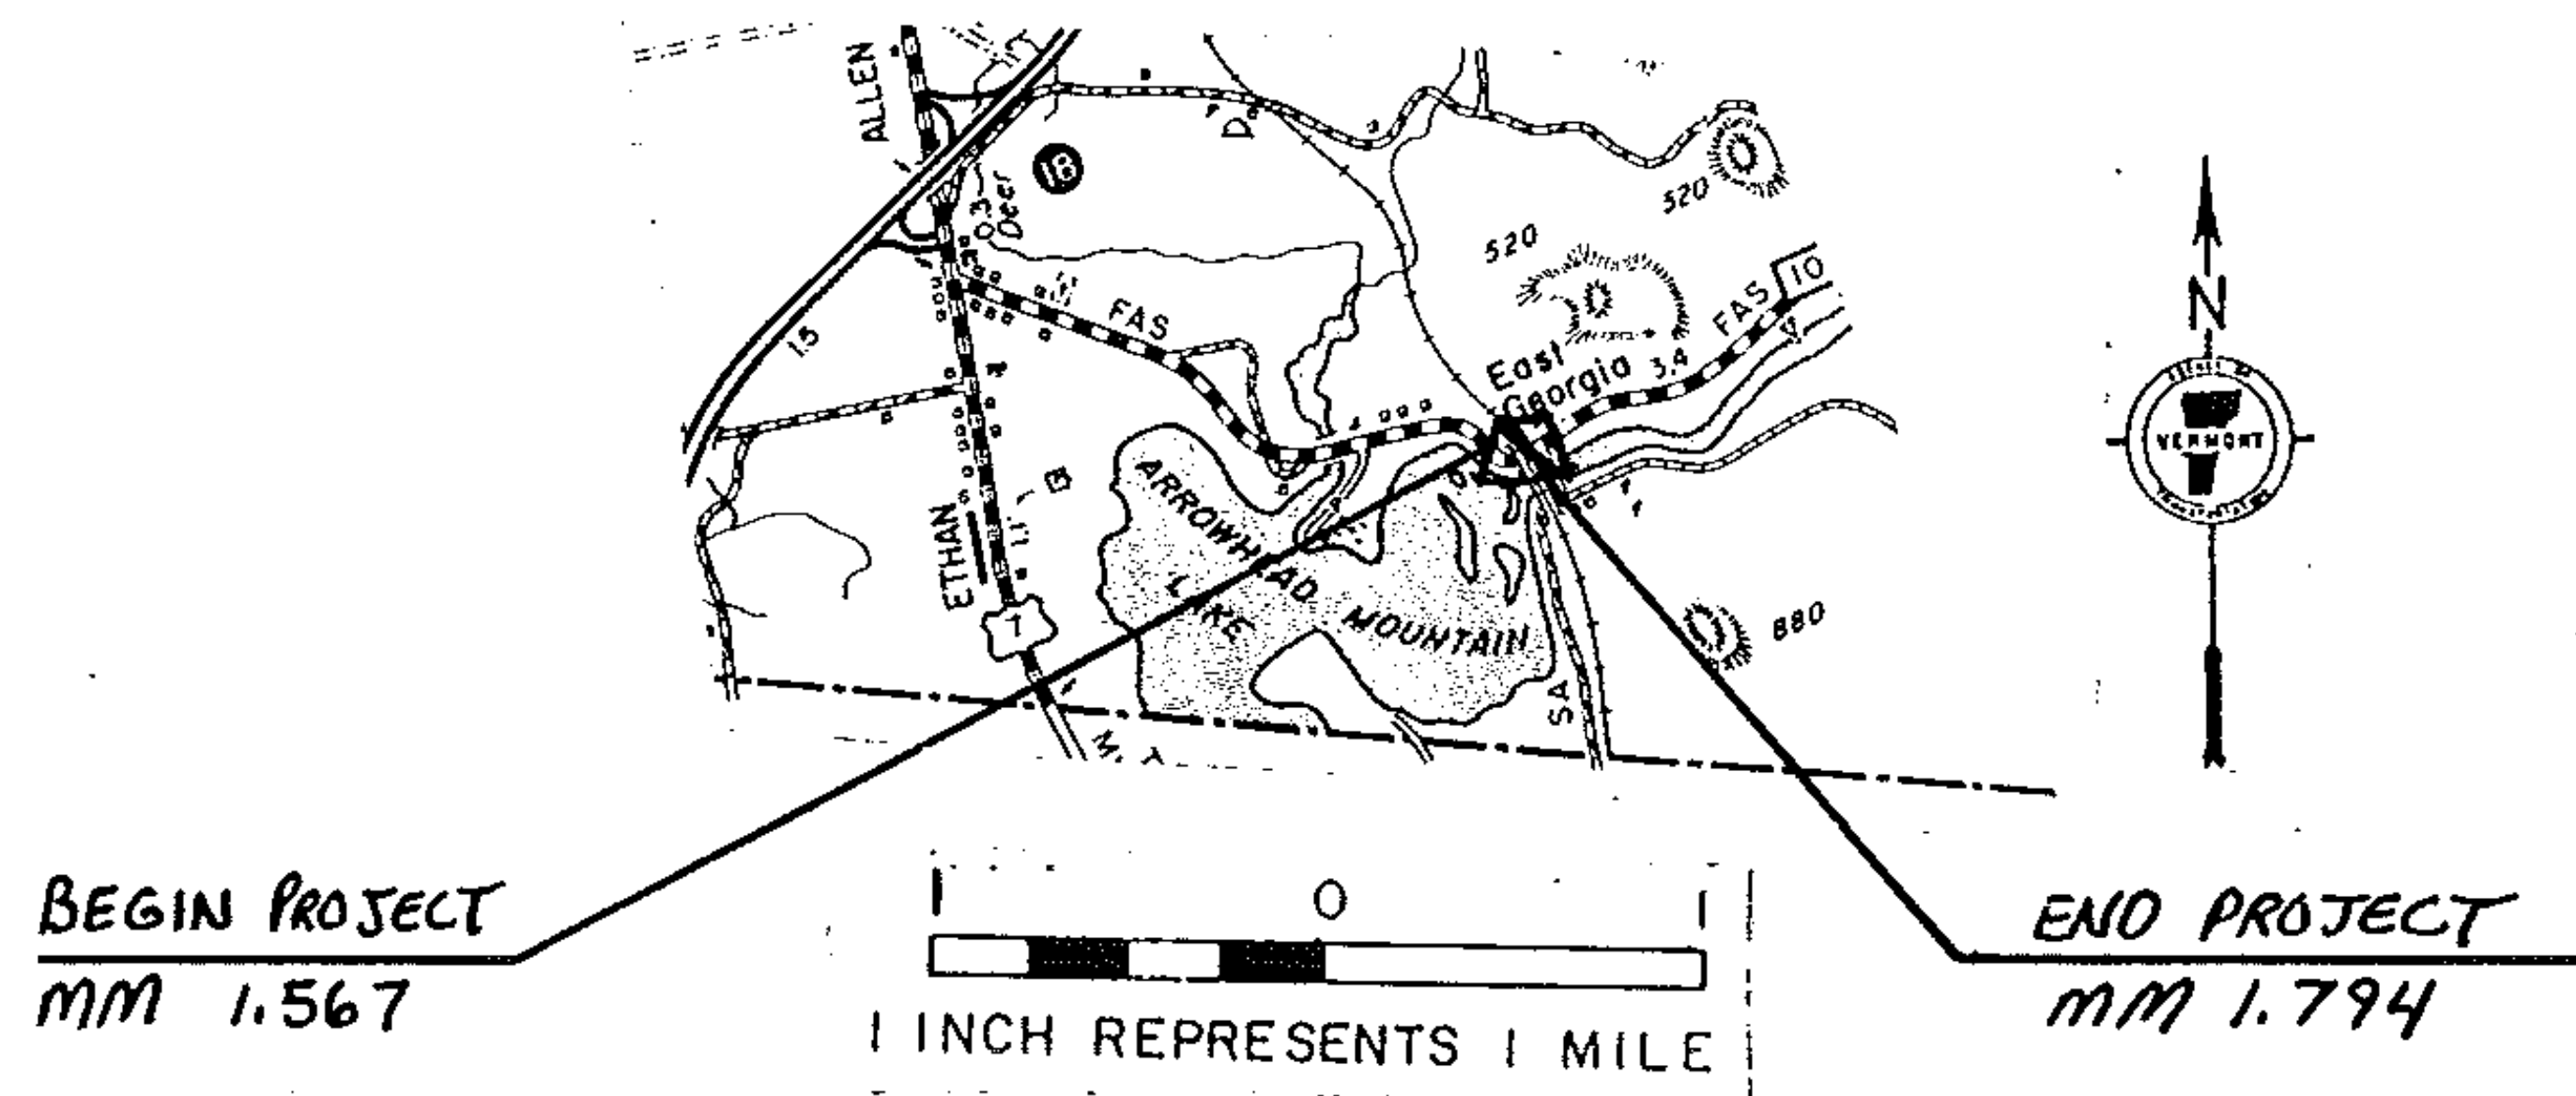

BEGINNING IN THE TOWN OF GEORGIA ON VT. RT.
104-A AT MM 1.567 AND EXTENDING EAST FOR 0.227 MILES TO
MM 1.794. RESURFACING AND NEW PAVEMENT MARKINGS.

LENGTH: 0.227 MILES
1199 FEET

1984 ADT: 1530

PROJECT GEORGIA

NO. HMA 2854

SHEET 35 OF 60 SHEETS