


DESCRIPTION AND LOCATION

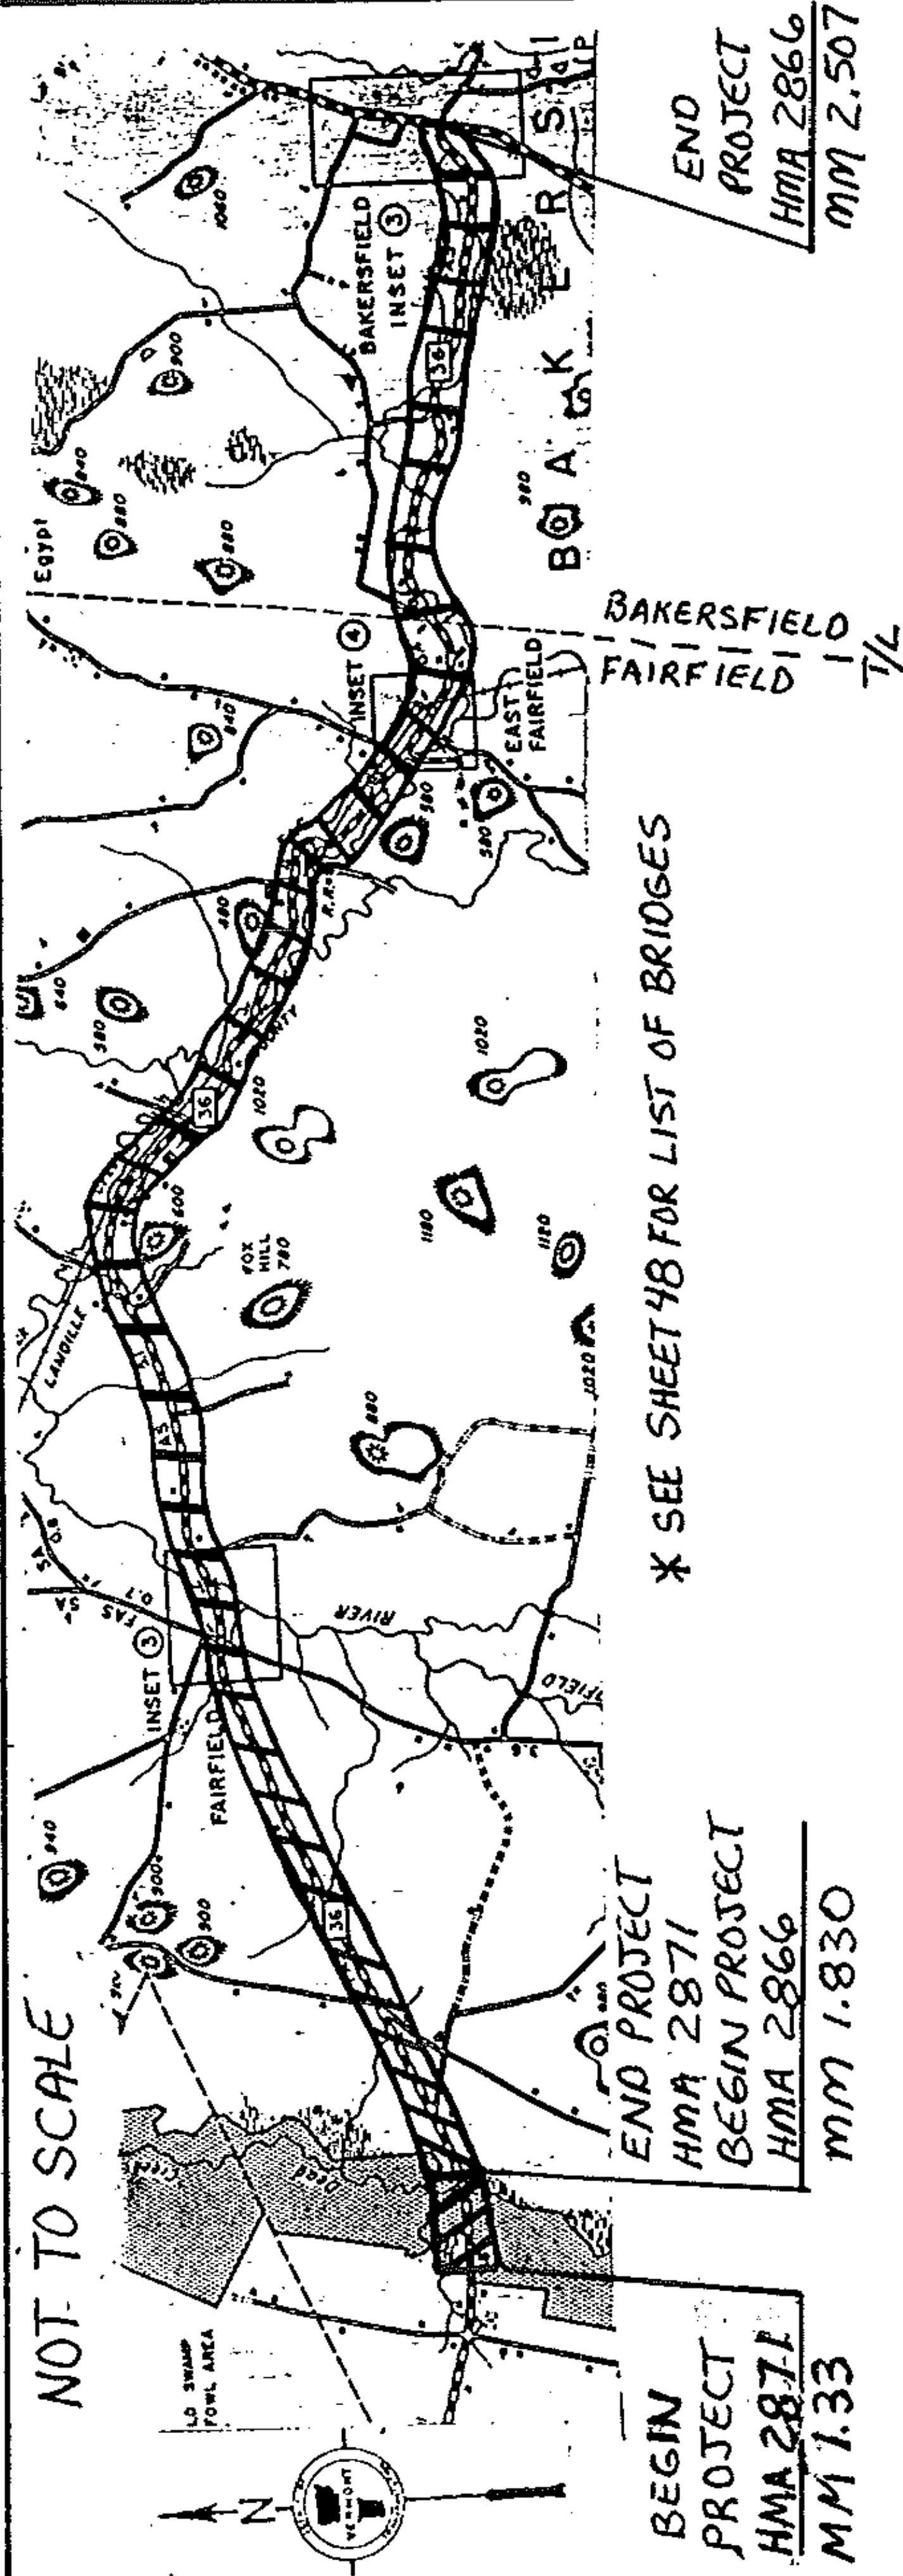

BEGINNING IN THE TOWN OF FAIRFIELD AT MM 1.33 ON Vt. Route 36
(HMA 2871) AND EXTENDING EAST 0.50 MILES TO MM 1.830. BEGINNING
IN THE TOWN OF FAIRFIELD AT MM 1.830 (HMA 2866) AND EXTENDING
EAST 10.667 MILES TO MM 2.507 IN THE TOWN OF BAKERSFIELD, ON Vt. Route 36.
RESURFACING AND NEW PAVEMENT MARKINGS.

HMA 2871 1984 ADT: 1480
LENGTH : 0.50 MILES
2640 FEET

HMA 2866 1984 ADT: 1280
LENGTH : 10.687 MILES
56,428 FEET

PROJECT FAIRFIELD - BAKERSFIELD

NO. HMA 2866, 2871
SHEET 39 OF 60 SHEETS