



TYPICAL SECTIONS & DESIGN DATA

ITEM 406.25 BITUMINOUS CONCRETE PAVEMENT
LEVELING COURSE TYPE IV (320 TONS/MILE)

1/4" WEARING COURSE TYPE III (±1/4")

AS DIRECTED BY THE ENGINEER

VT. 36 FAIRFIELD MM 1.830 ~ MM 7.958

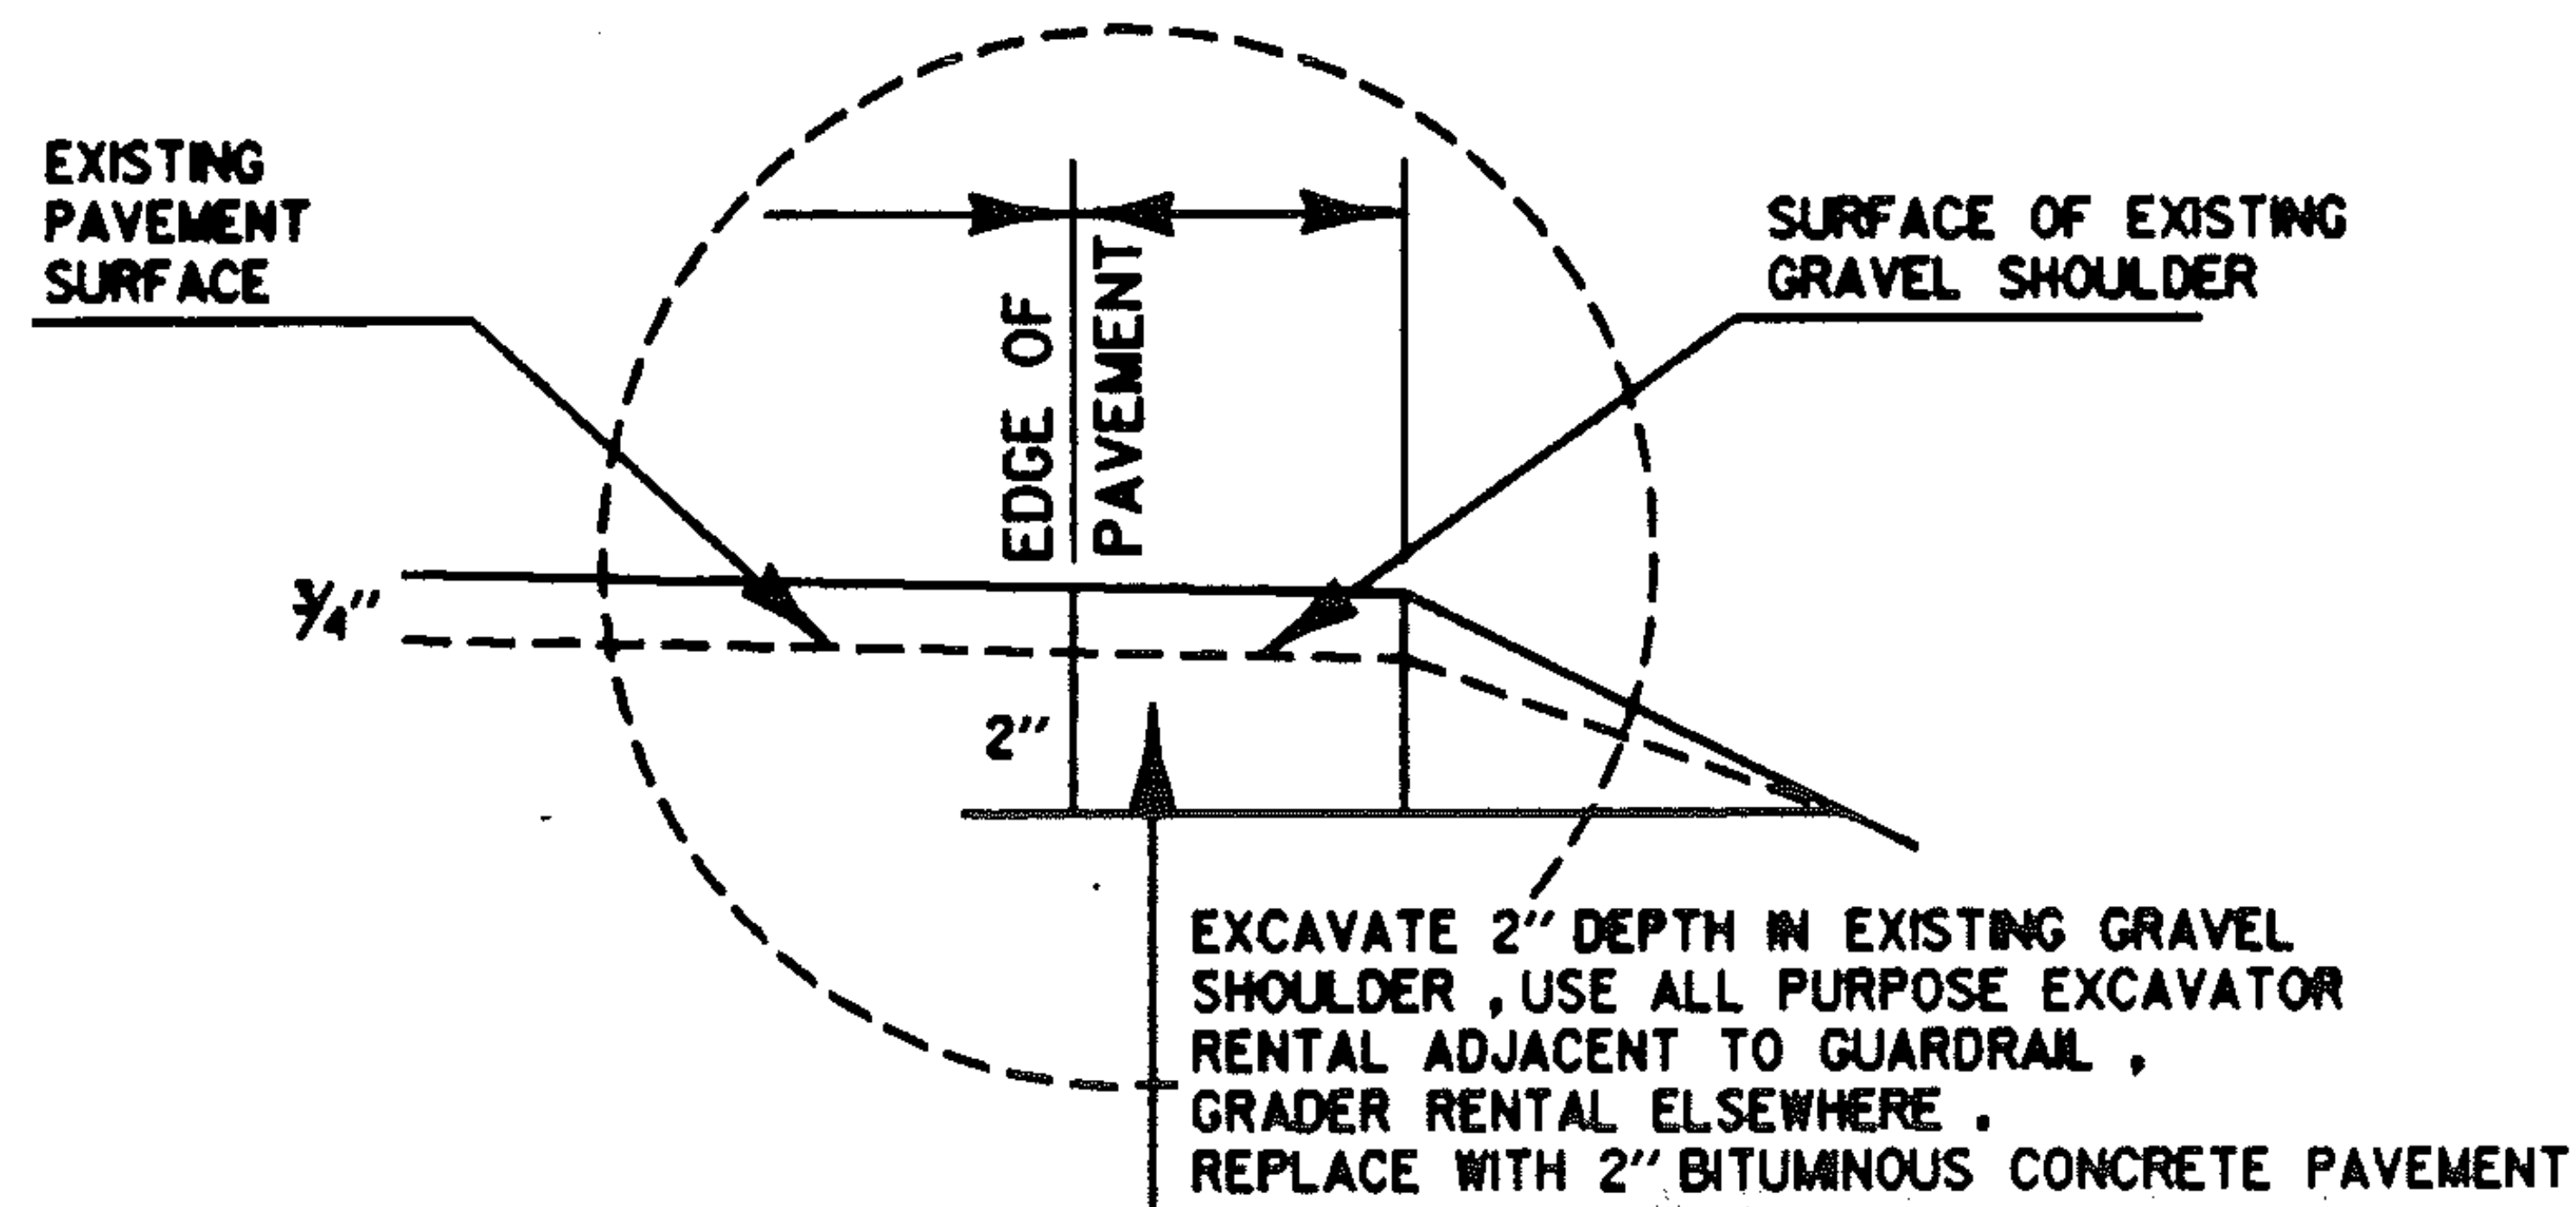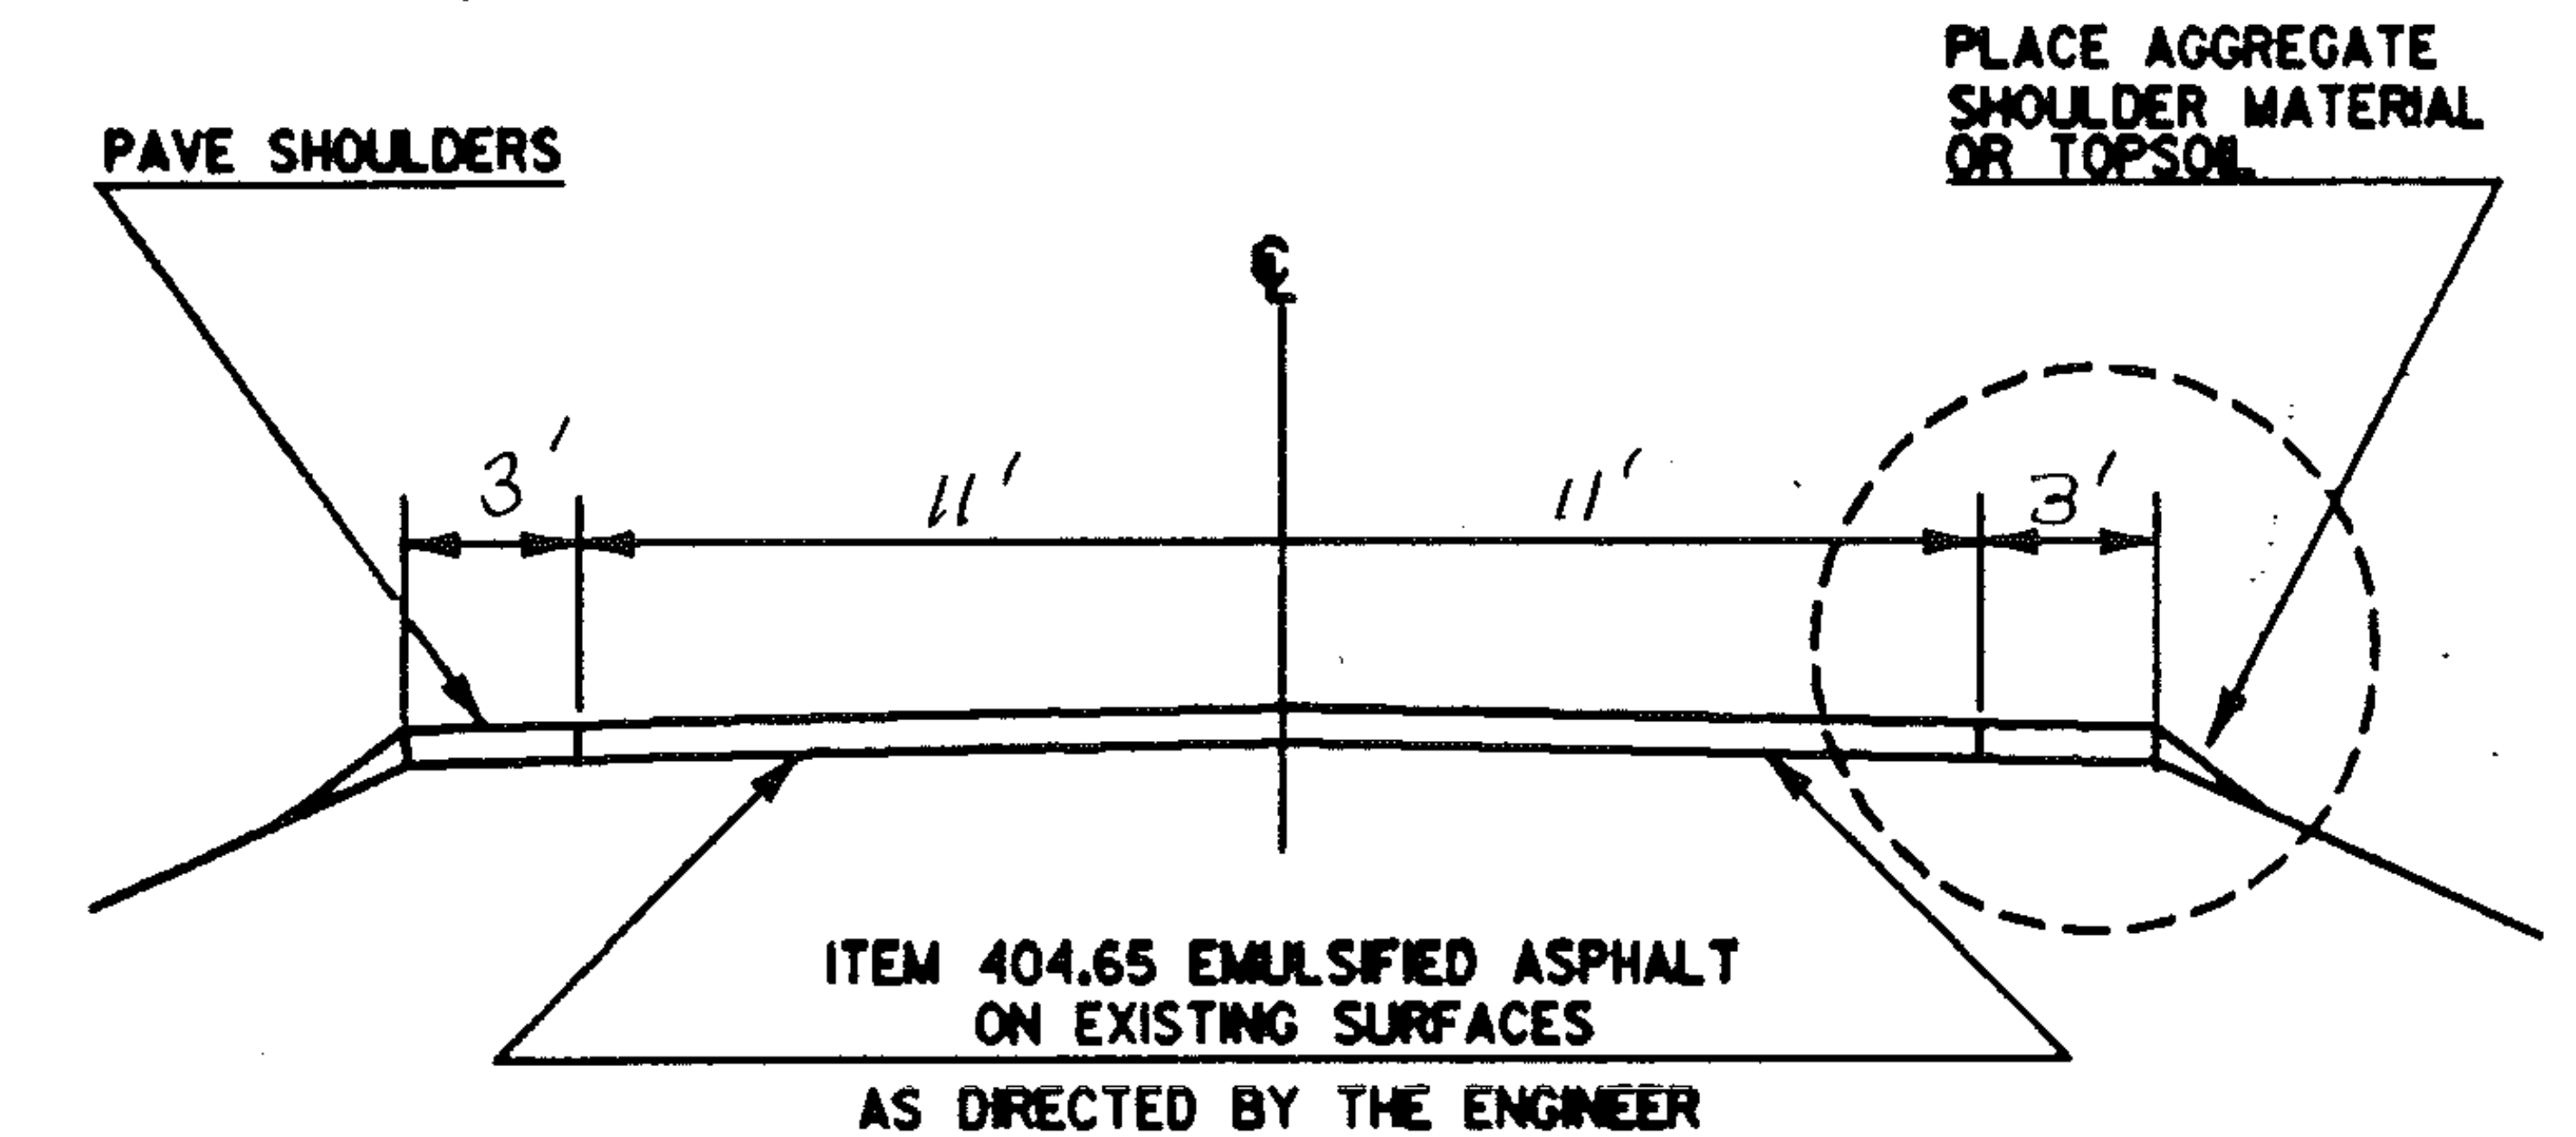

PROJECT FAIRFIELD-BAKERSFIELD

NO. HMA 2866

SHEET 41 OF 60 SHEETS