


PROJECT DESCRIPTION AND LOCATION

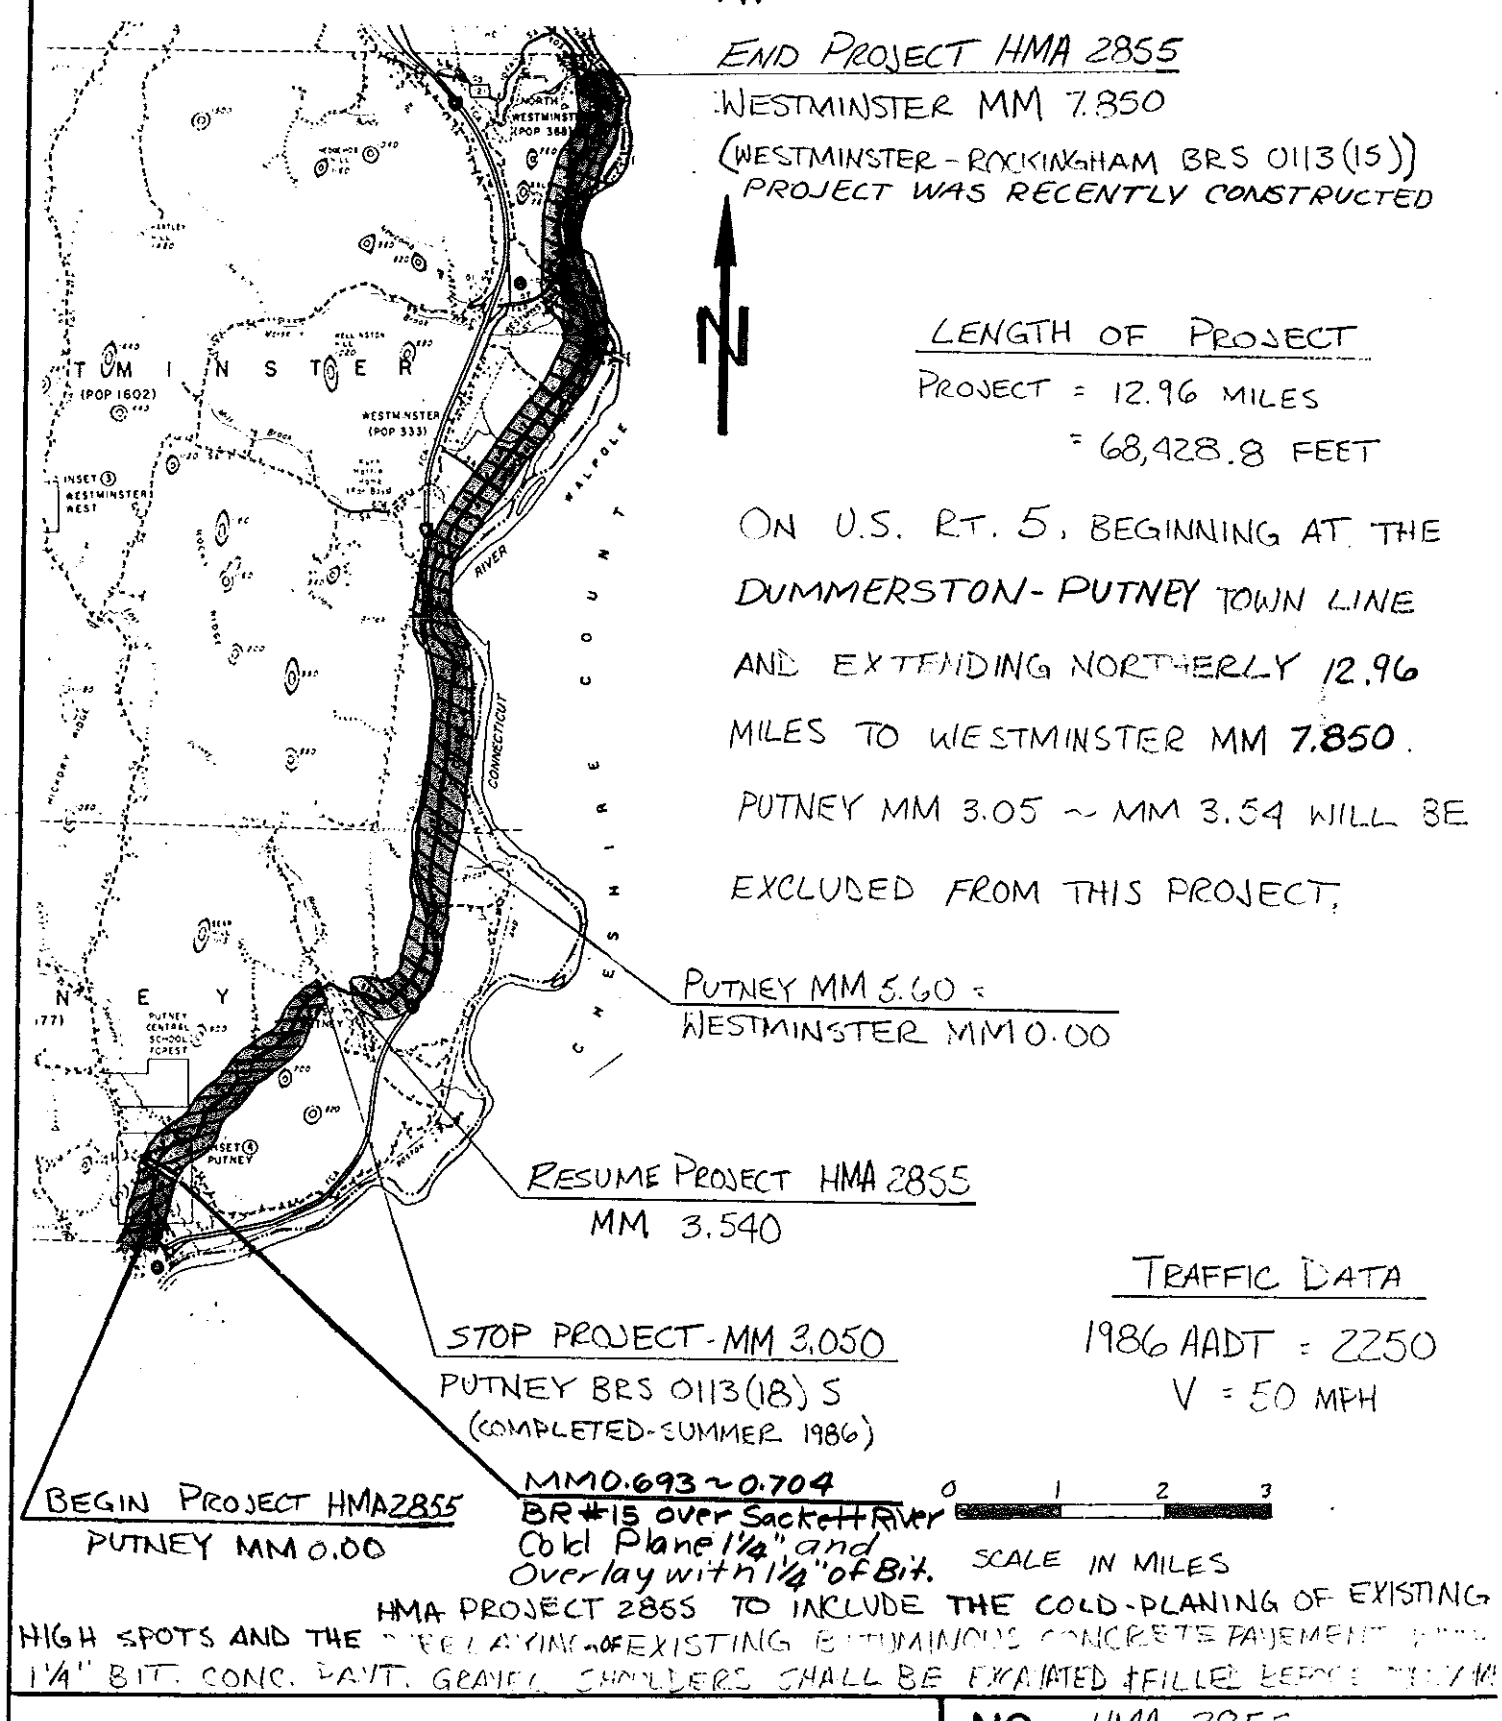

NO. HMA 2855