


TYPICAL SECTIONS & DESIGN DATA

ITEM 406.25 - BITUMINOUS CONCRETE PAVEMENT  
TYPE IV MIX WILL BE USED FOR LEVELING UNLESS  
OTHERWISE DETERMINED BY THE RESIDENT ENGINEER.

1 1/4" WEARING COURSE, TYPE III

TYPE IV LEVELING MIX, 38' WIDE @ 518 TONS/MI.

COLD PLANING AS DIRECTED BY THE ENGINEER.

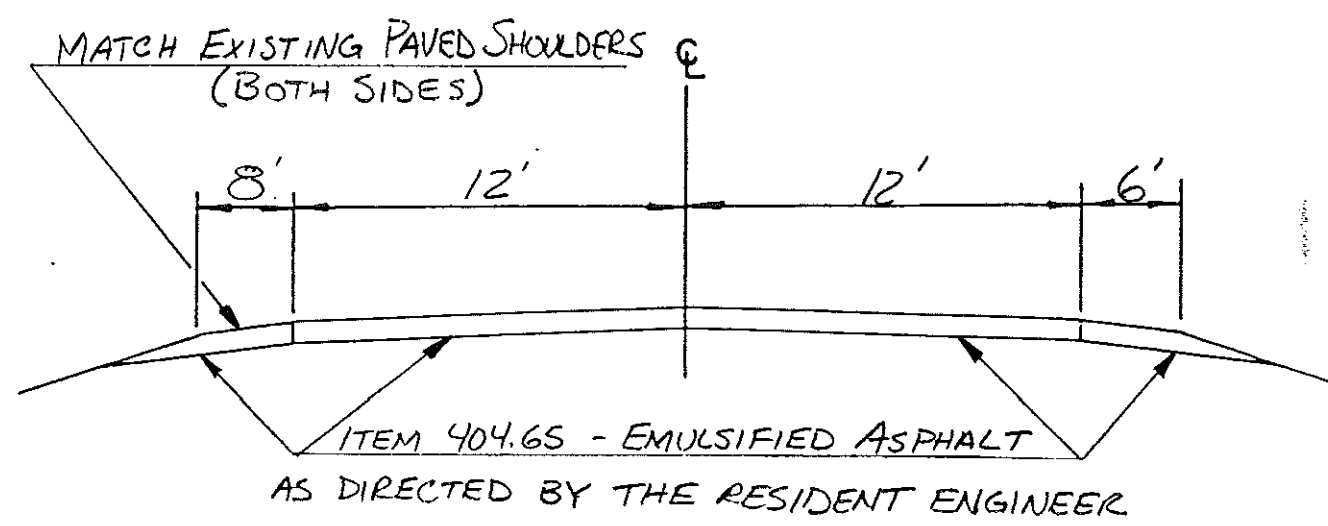

PUTNEY MM 0.00 ~ 0.160

MM 0.180 ~ 0.250