


TYPICAL SECTIONS & DESIGN DATA

ITEM 406.25 - BITUMINOUS CONCRETE PAVEMENT
TYPE II MIX WILL BE USED FOR LEVELING UNLESS OTHERWISE
DETERMINED BY THE RESIDENT ENGINEER.

1/4" WEARING COURSE, TYPE III
TYPE IV LEVELING MIX, 42' WIDE @ 572 TONS/MI.
COLD PLANING AS DIRECTED BY THE ENGINEER.

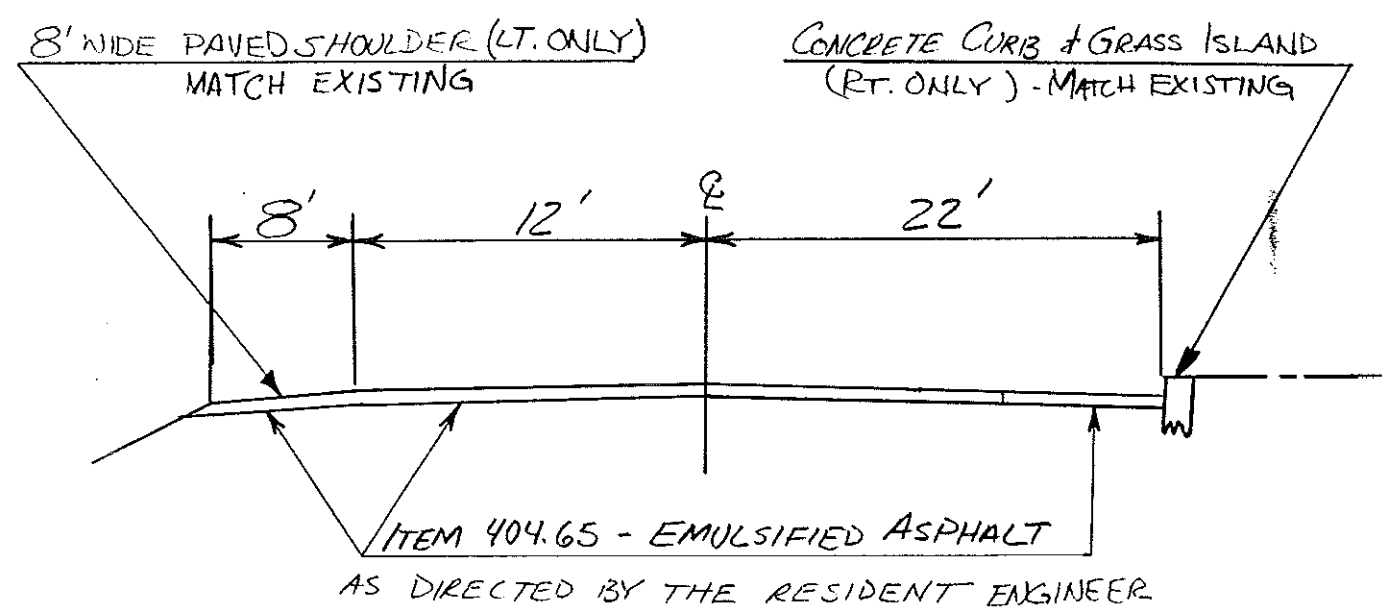

POTNEY MM 0.16 ~ MM 0.18

NO. HMA 2865

PROJECT POTNEY-WESTMINSTER

SHEET 5 OF 33 SHEETS