


**TYPICAL SECTIONS & DESIGN DATA**

ITEM 406.25 - BITUMINOUS CONCRETE PAVEMENT  
TYPE II MIX WILL BE USED FOR LEVELING UNLESS OTHERWISE DETERMINED BY THE RESIDENT ENGINEER.  
1 1/4" WEARING COURSE, TYPE III  
TYPE IV LEVELING MIX, 30' WIDE @ 518 TONS/MILE  
COLD PLANING AS DIRECTED BY THE ENGINEER.

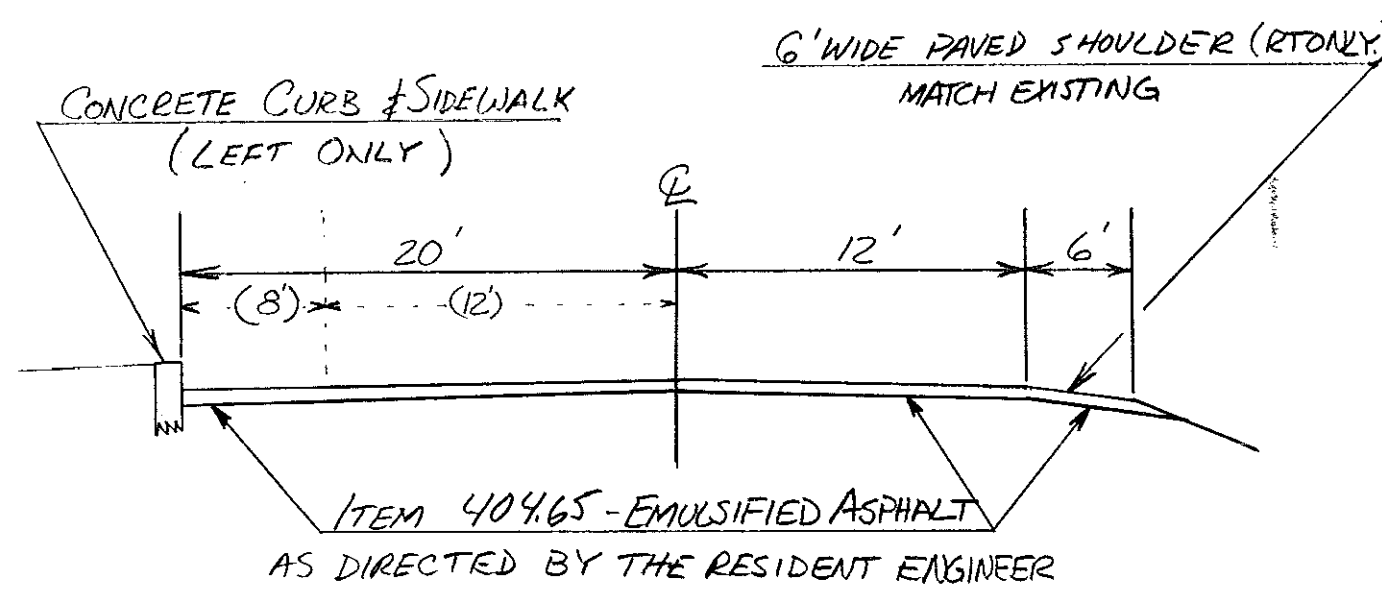

POTNEY MM 0.25 ~ MM 0.39