


TYPICAL SECTIONS & DESIGN DATA

ITEM 406.25 - BITUMINOUS CONCRETE PAVEMENT
 TYPE III MIX WILL BE USED FOR LEVELING UNLESS OTHERWISE DETERMINED BY THE RESIDENT ENGINEER.

1 1/4" WEARING COURSE, TYPE III

TYPE II LEVELING MIX, 40 CURB-CURBS @ 545 TONS/Mi.
 COLD PLANING AS DIRECTED BY THE ENGINEER

CONCRETE CURB & SIDEWALK
 (BOTH SIDES)

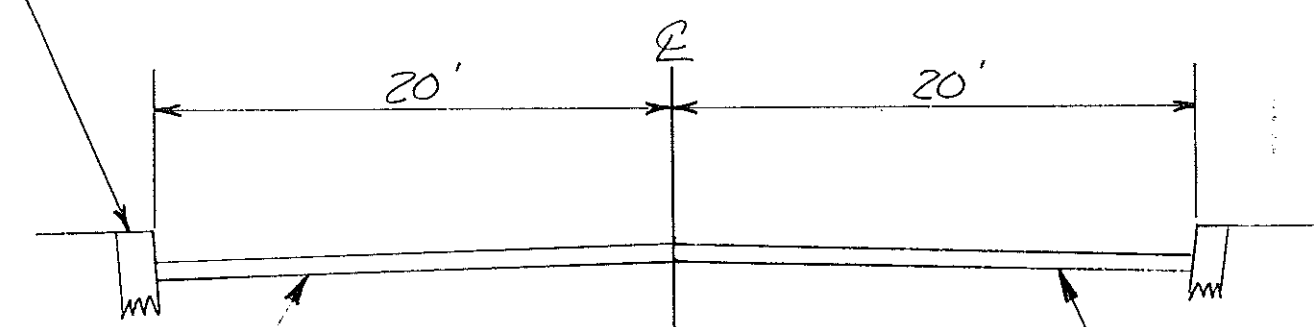

ITEM 404.65 - EMULSIFIED ASPHALT AS DIRECTED BY THE RESIDENT ENGINEER

Note:
 Putney MM 0.693 ~ 0.704
 Bridge No. 15 over Sackett's River
 Cold Plane 1 1/4" off the existing deck
 and Repave with 1 1/4" of Bit. Conc. Pave, TYPE III
 See Sht 22 of 33

Putney MM 0.39 ~ MM 0.70

NO. HMA 2855

PROJECT PUTNEY - WESTMINSTER

SHEET 7 OF 33 SHEETS