


TYPICAL SECTIONS & DESIGN DATA

ITEM 406.25 - BITUMINOUS CONCRETE PAVEMENT
TYPE IV MIX WILL BE USED FOR LEVELING UNLESS OTHERWISE DETERMINED BY THE RESIDENT ENGINEER.

1 1/4" WEARING COURSE, TYPE III
TYPE III LEVELING, 26" WIDE @ 354 TONS/IN.
COLD PLANING AS DIRECTED BY THE ENGINEER.

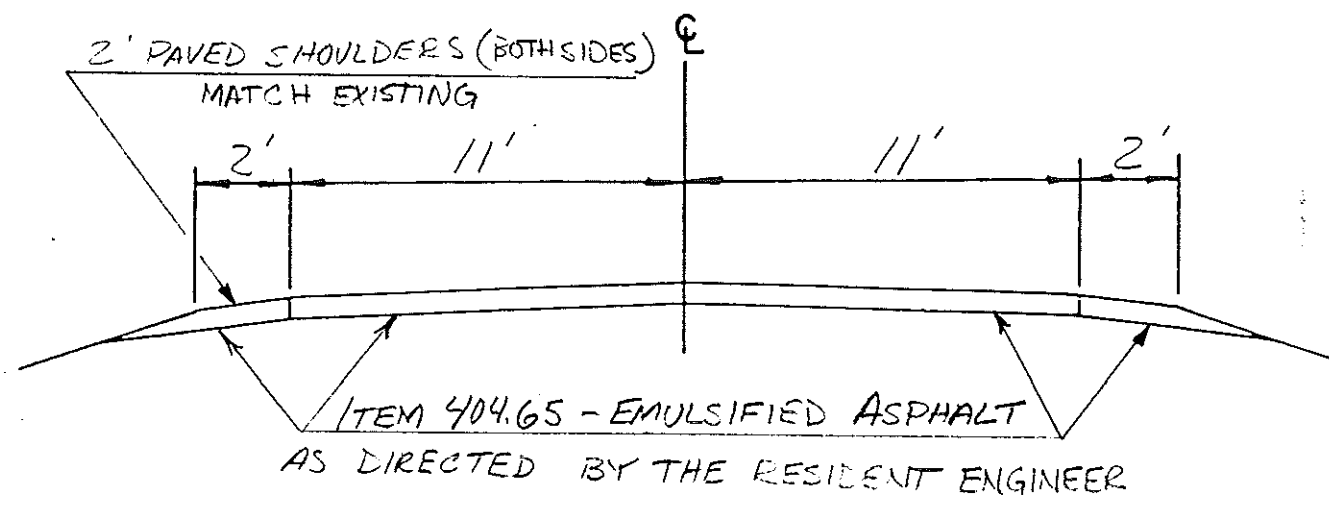

POTNEY MM 0.70 ~ MM 0.79