


**TYPICAL SECTIONS & DESIGN DATA**

ITEM 406.25 - BITUMINOUS CONCRETE PAVEMENT  
TYPE IV MIX WILL BE USED FOR LEVELING UNLESS OTHERWISE DETERMINED BY THE RESIDENT ENGINEER.

1 1/4" WEARING COURSE, TYPE III  
TYPE II LEVELING MIX, 26' WIDE @ 354 TONS/MI.  
COLD PLANING AS DIRECTED BY THE ENGINEER.

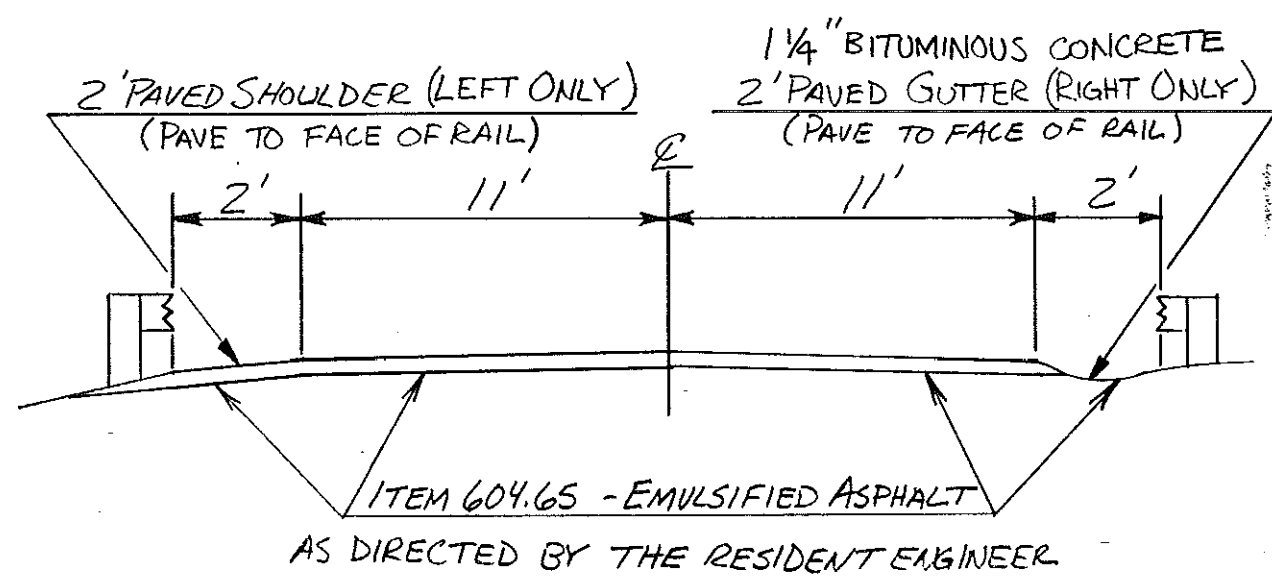

POTNEY MM 0.99 ~ 1.04

NO. HMA 2855

PROJECT POTNEY - WESTMINSTER

SHEET 9 OF 33 SHEETS