


TYPICAL SECTIONS & DESIGN DATA

COLD PLANING AS DIRECTED BY THE ENGINEER
 ITEM 406.25 BITUMINOUS CONCRETE PAVEMENT
 AGGREGATE SHOULDERS ($\pm 1/2"$)
 LEVELING COURSE TYPE IV (354 TONS/MILE)
 1 1/4" WEARING COURSE TYPE III ($\pm 1/4"$)
 AS DIRECTED BY THE ENGINEER

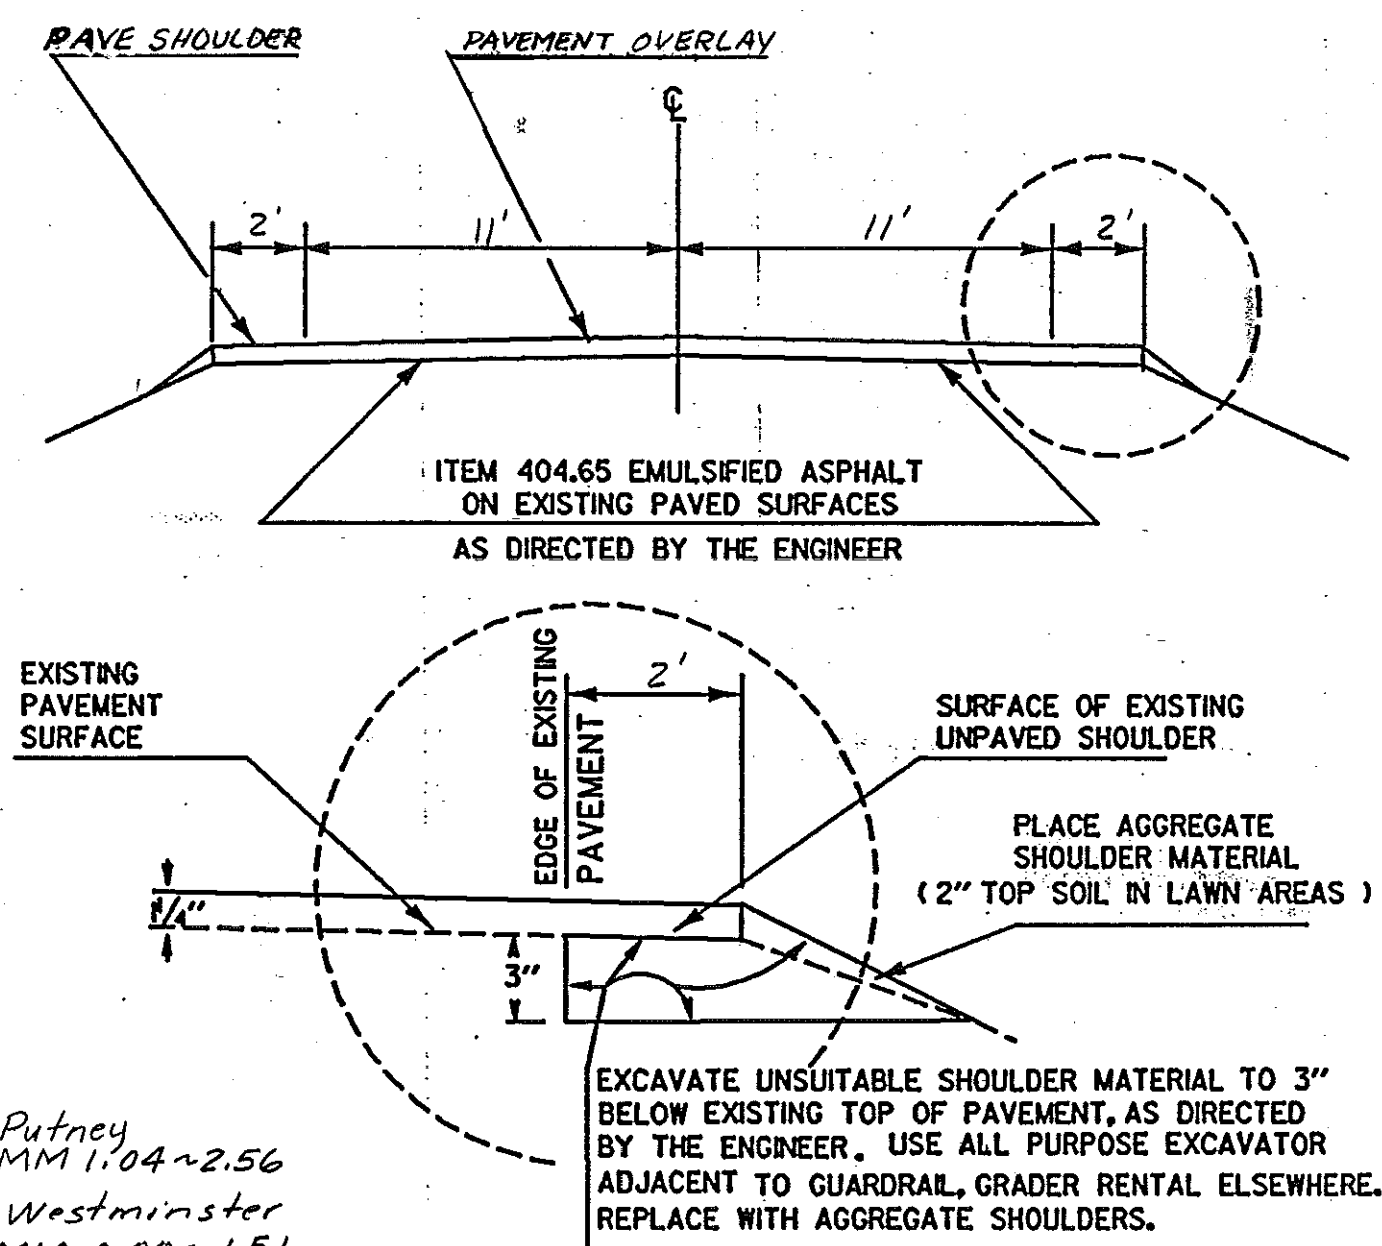

Putney
 MM 1.04 ~ 2.56
 Westminster
 MM 0.00 ~ 1.51

NO. HMA 2855

PROJECT PUTNEY - WESTMINSTER

SHEET 10 OF 33 SHEETS