
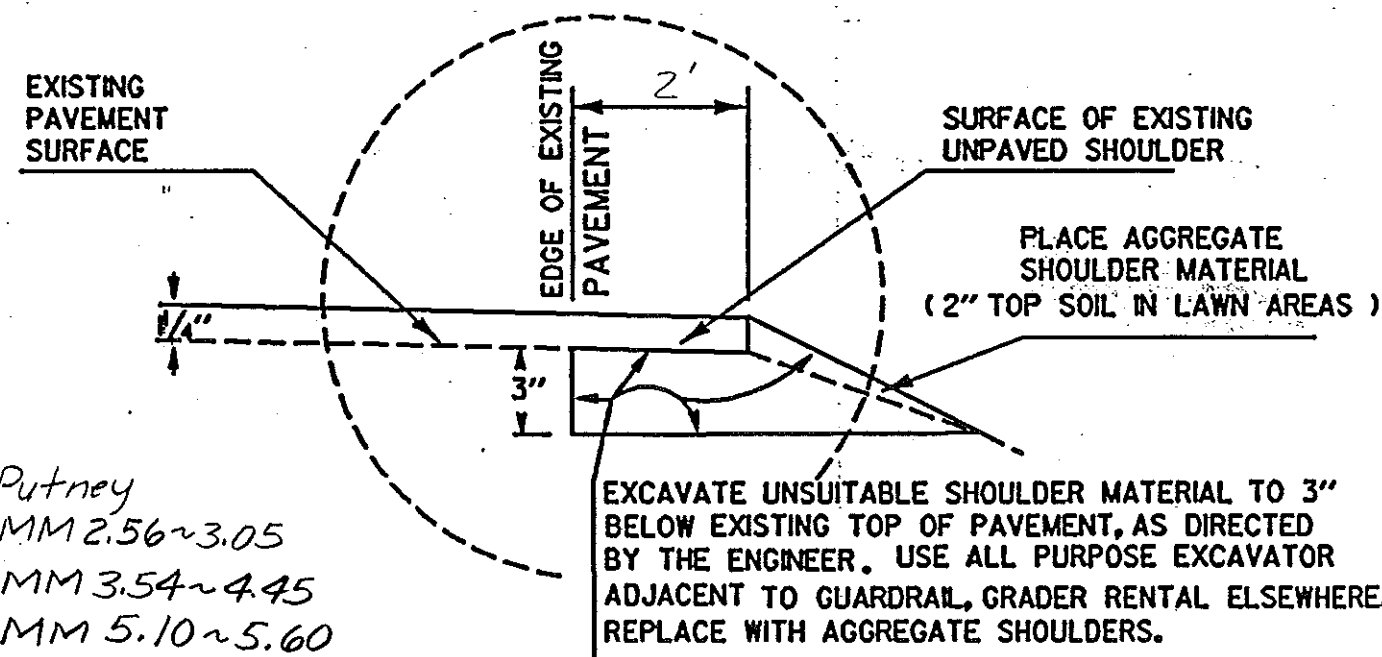


TYPICAL SECTIONS & DESIGN DATA

COLD PLANING AS DIRECTED BY THE ENGINEER
 ITEM 406.25 BITUMINOUS CONCRETE PAVEMENT
 AGGREGATE SHOULDERS ($\pm 1/2"$)
 LEVELING COURSE TYPE IV (382 TONS/MILE)
 1 1/4" WEARING COURSE TYPE III ($\pm 1/4"$)
 AS DIRECTED BY THE ENGINEER

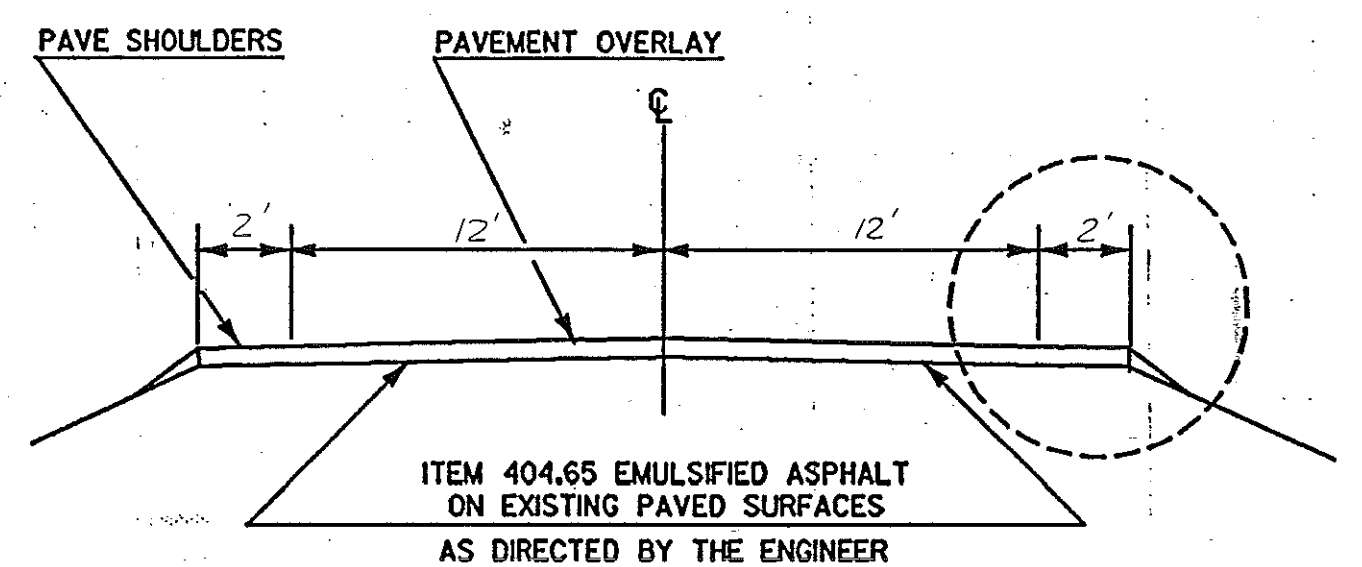

Putney
 MM 2.56 ~ 3.05
 MM 3.54 ~ 4.45
 MM 5.10 ~ 5.60