


TYPICAL SECTIONS & DESIGN DATA

ITEM 406.25 - BITUMINOUS CONCRETE PAVEMENT
TYPE IV MIX WILL BE USED FOR LEVELING UNLESS
OTHERWISE DETERMINED BY THE RESIDENT ENGINEER.
COLD PLANING AS DIRECTED BY THE ENGINEER.
1/4" WEARING COURSE, TYPE III
TYPE IV LEVELING MIX, 28' WIDE @ 382 TONS/MI.

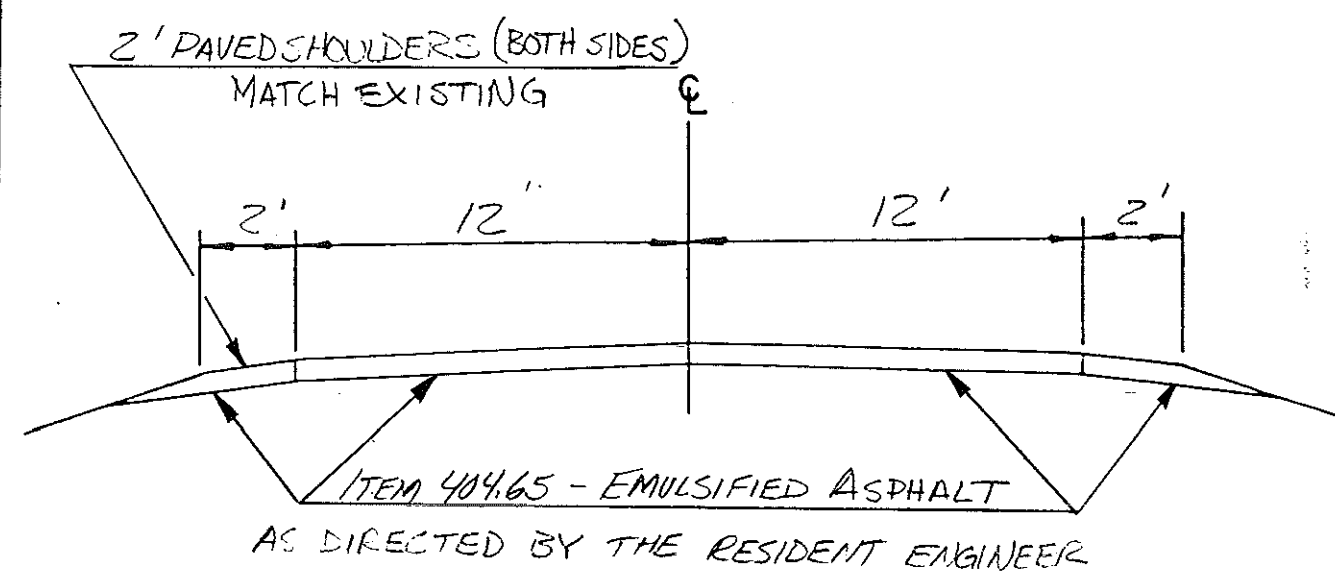

PUTNEY MM 4.45 ~ MM 5.10
WESTMINSTER MM 1.51 ~ MM 7.85