


PARKING AREA DETAIL SHEET

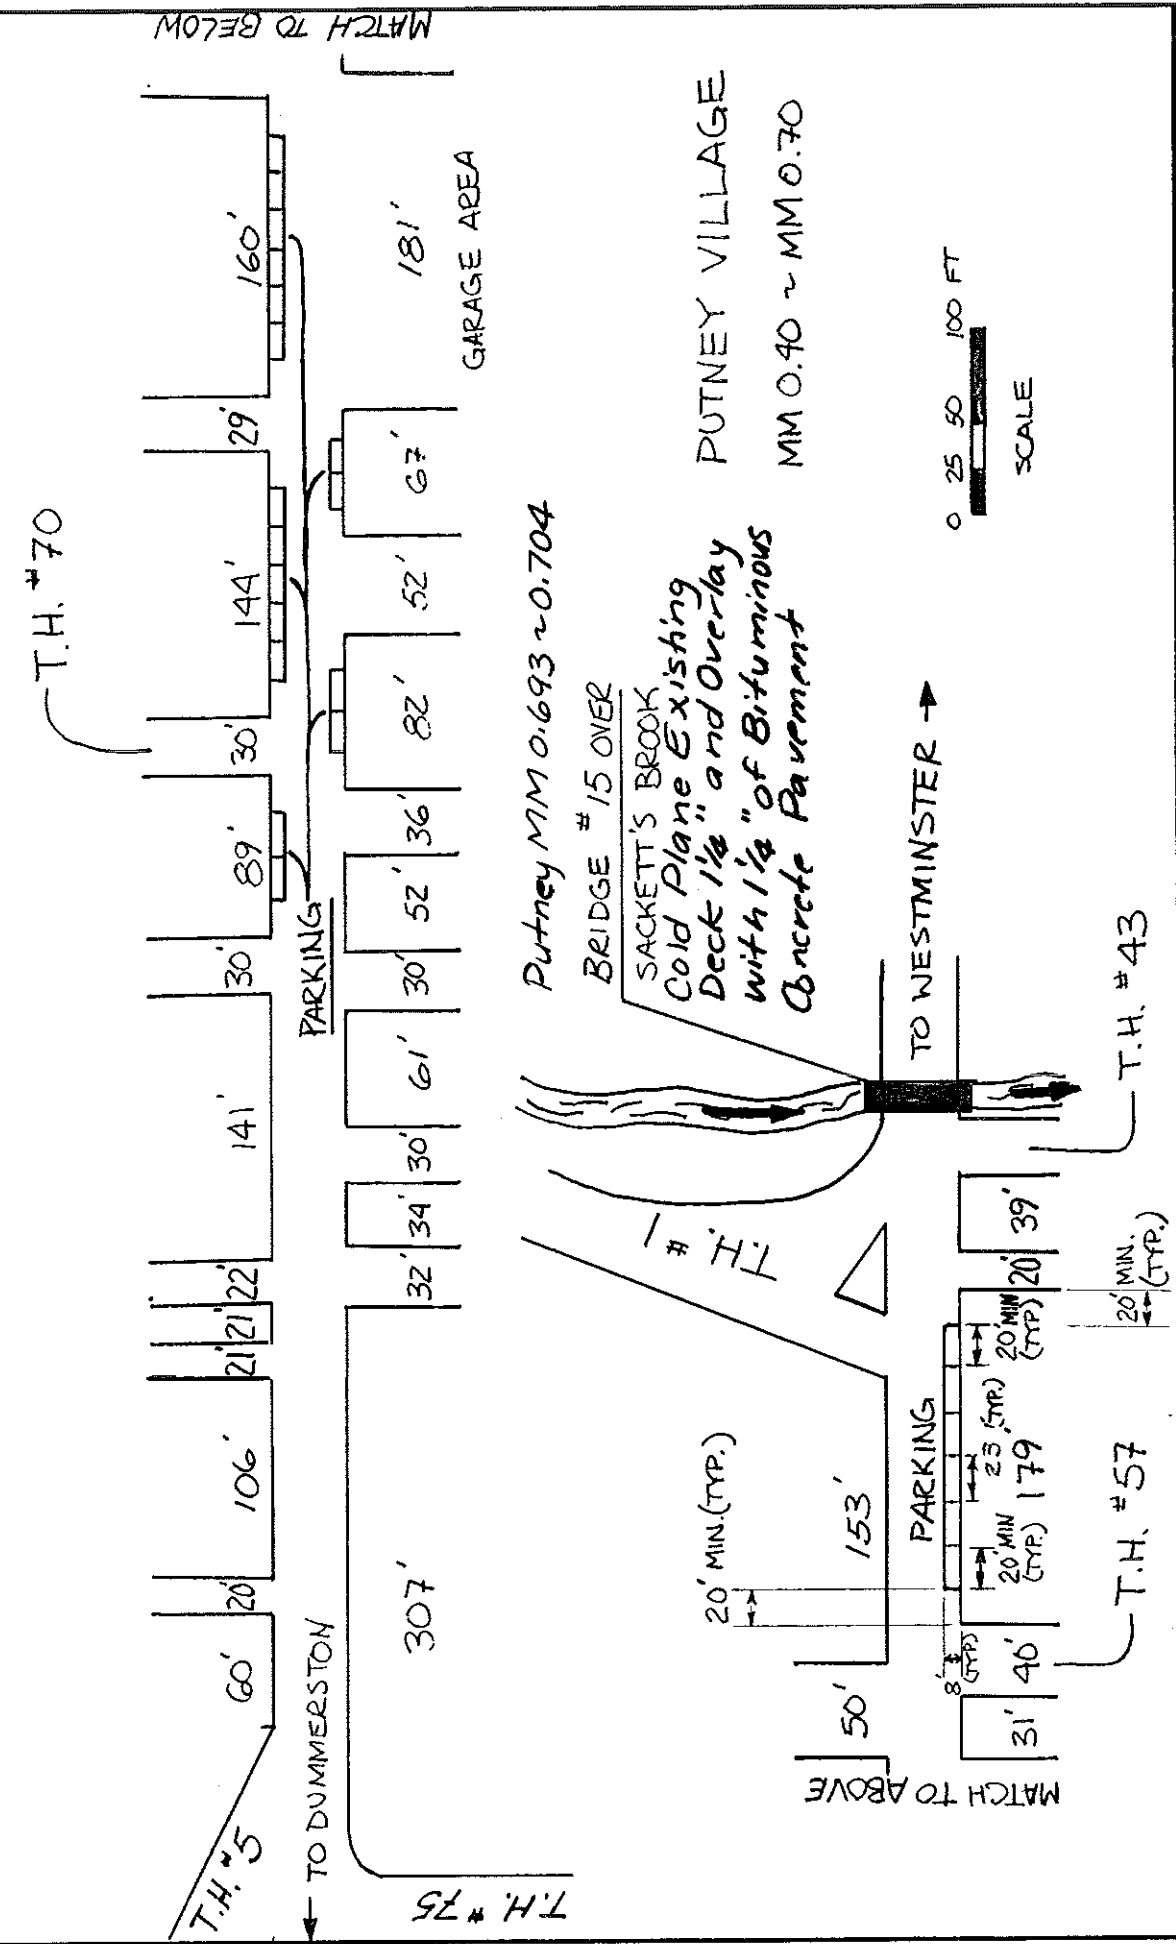

0 25 50 100 FT  
SCALE

PROJECT PUTNEY - WESTMINSTER NO. HMM 2855 SHT. 22 OF 33 SHTS.