


PROJECT DESCRIPTION AND LOCATION

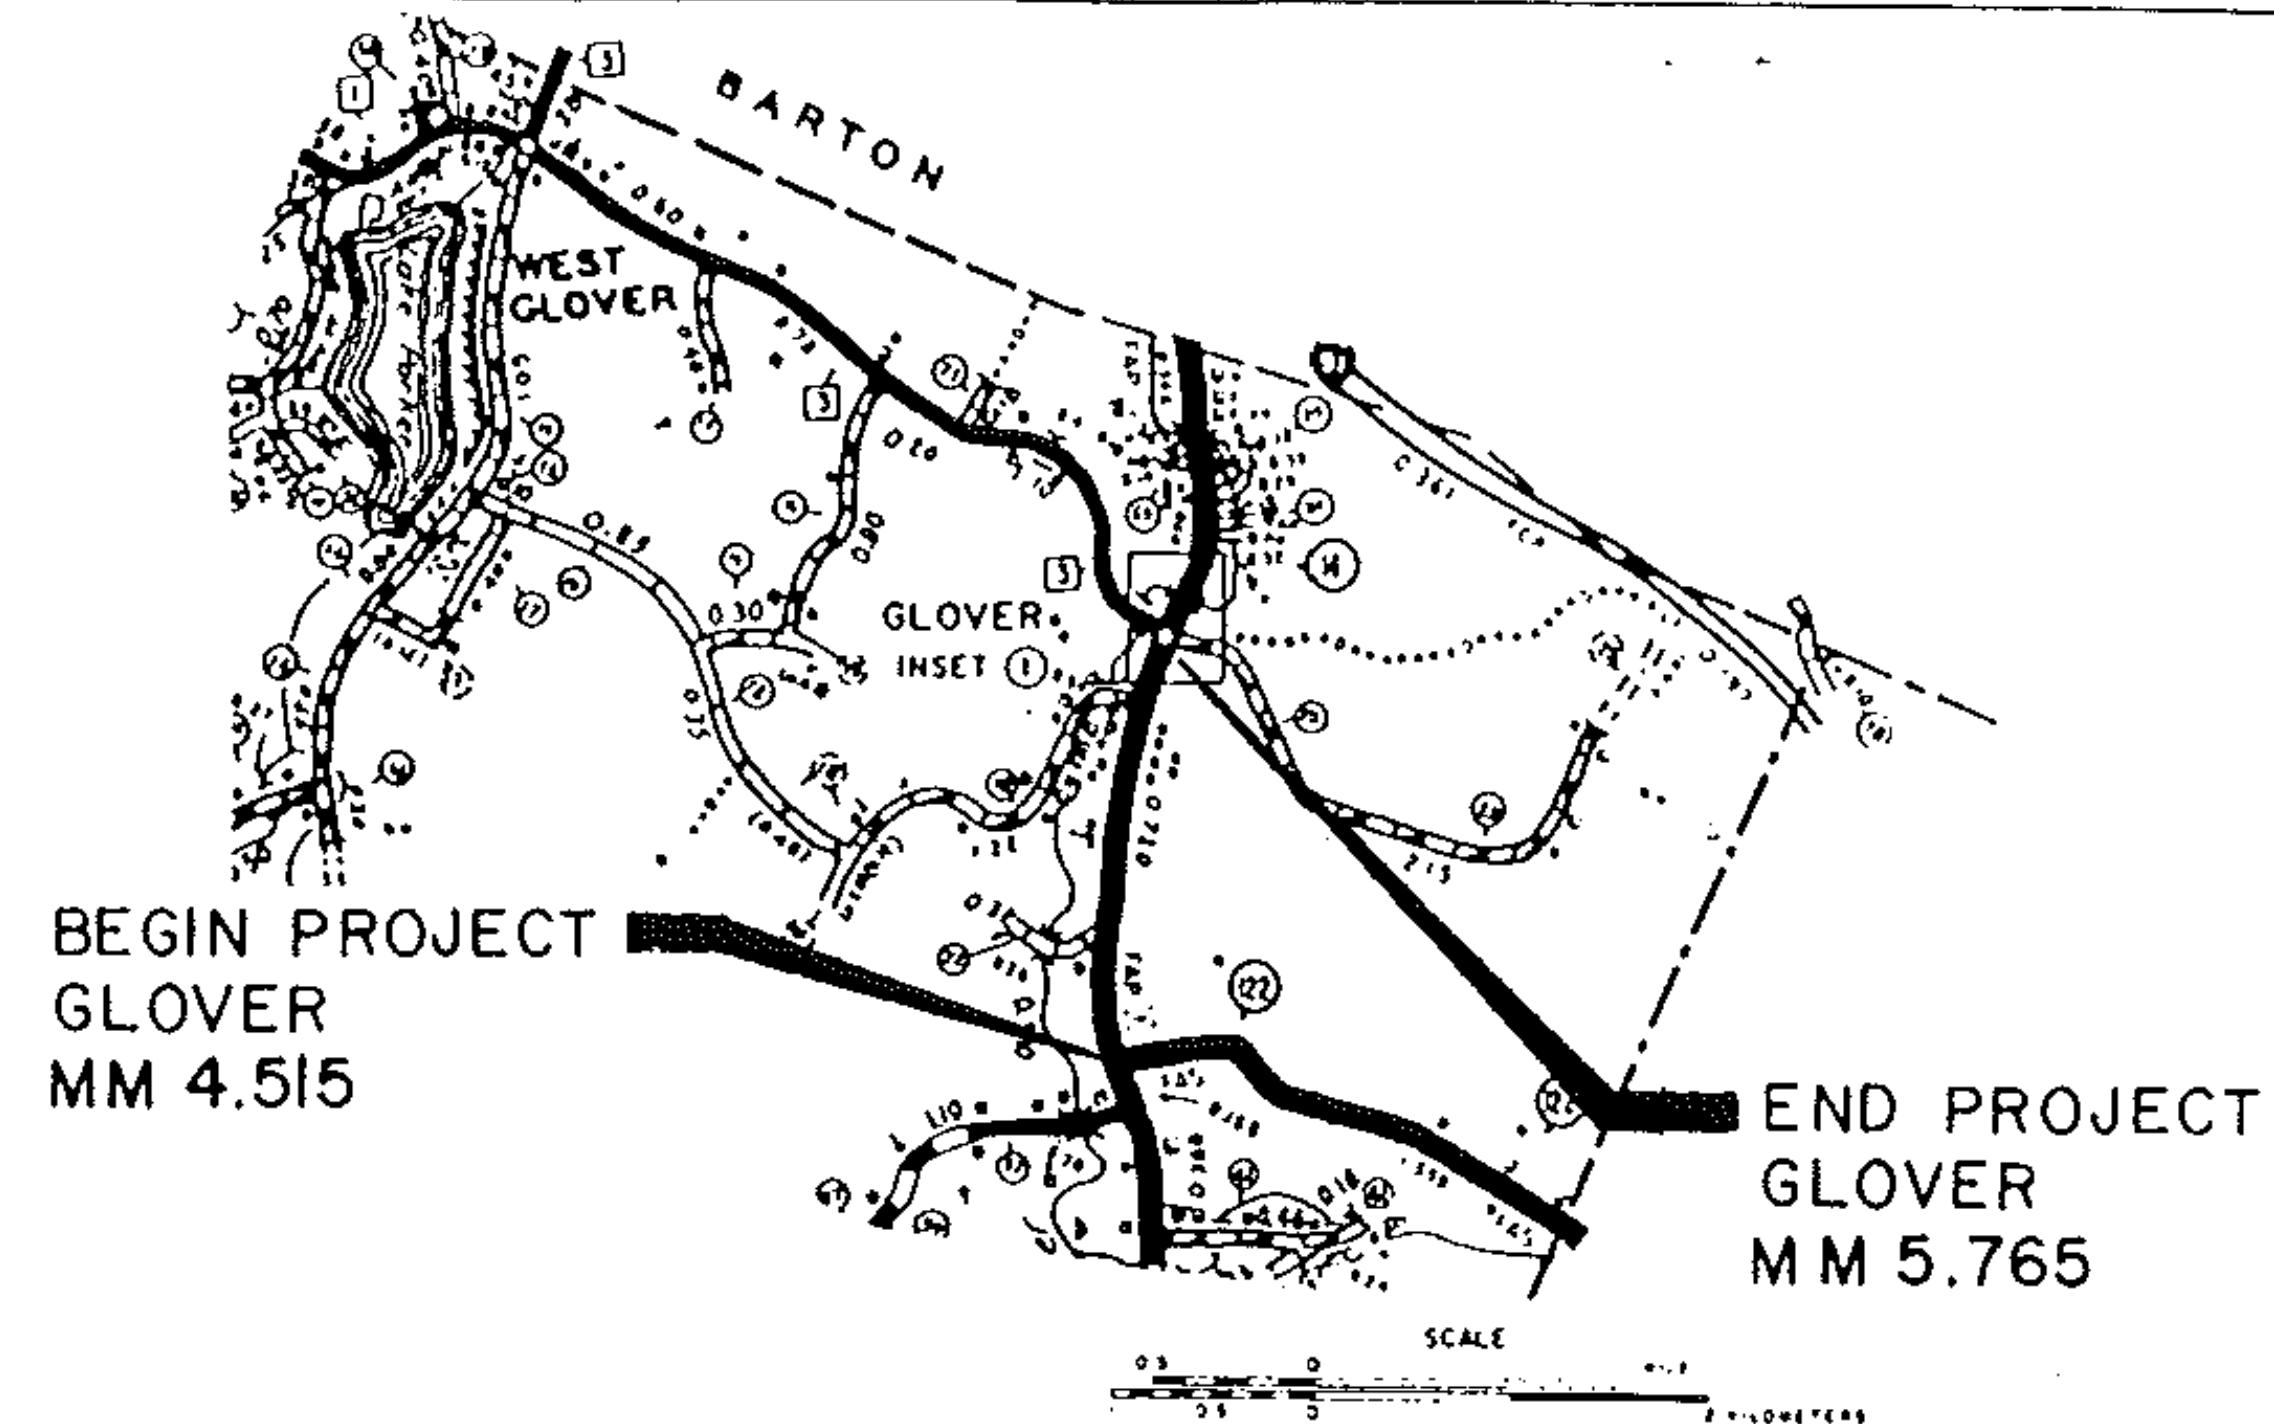

PROJECT LOCATION

BEGINNING IN THE TOWN OF GLOVER AT MM 4.515, THE INTERSECTION WITH VT 122, AND EXTENDING NORTHERLY ALONG VT 16 FOR 1.250 MILES TO MM 5.765

PROJECT LENGTH

1.250 MILES (6,600 FEET)

PROJECT DESCRIPTION

RESURFACE WITH A LEVELING COURSE AND $1\frac{1}{4}$ " BITUMINOUS OVERLAY, PROVIDE PAVED SHOULDERS AND NEW PAVEMENT MARKINGS AS INDICATED ON THE PLANS OR AS DIRECTED BY THE ENGINEER.

TRAFFIC DATA

AADT 1680
V 50 MPH

PROJECT GLOVER

NO. HMA 2856

SHEET 23 OF 26 SHEETS