


DESCRIPTION AND LOCATION

PROJECT LENGTH: 6.075 MILES; 32,076 FEET

1986 ADT: 2880

BEGINNING IN THE TOWN OF SHAFTSBURY ON VT ROUTE 7A M.M. 1.214 AND EXTENDING NORTHERLY 6.075 MILES TO M.M. 0.394 IN THE TOWN OF ARLINGTON. RESURFACING OF THE HIGHWAY AND NEW PAVEMENT MARKINGS.

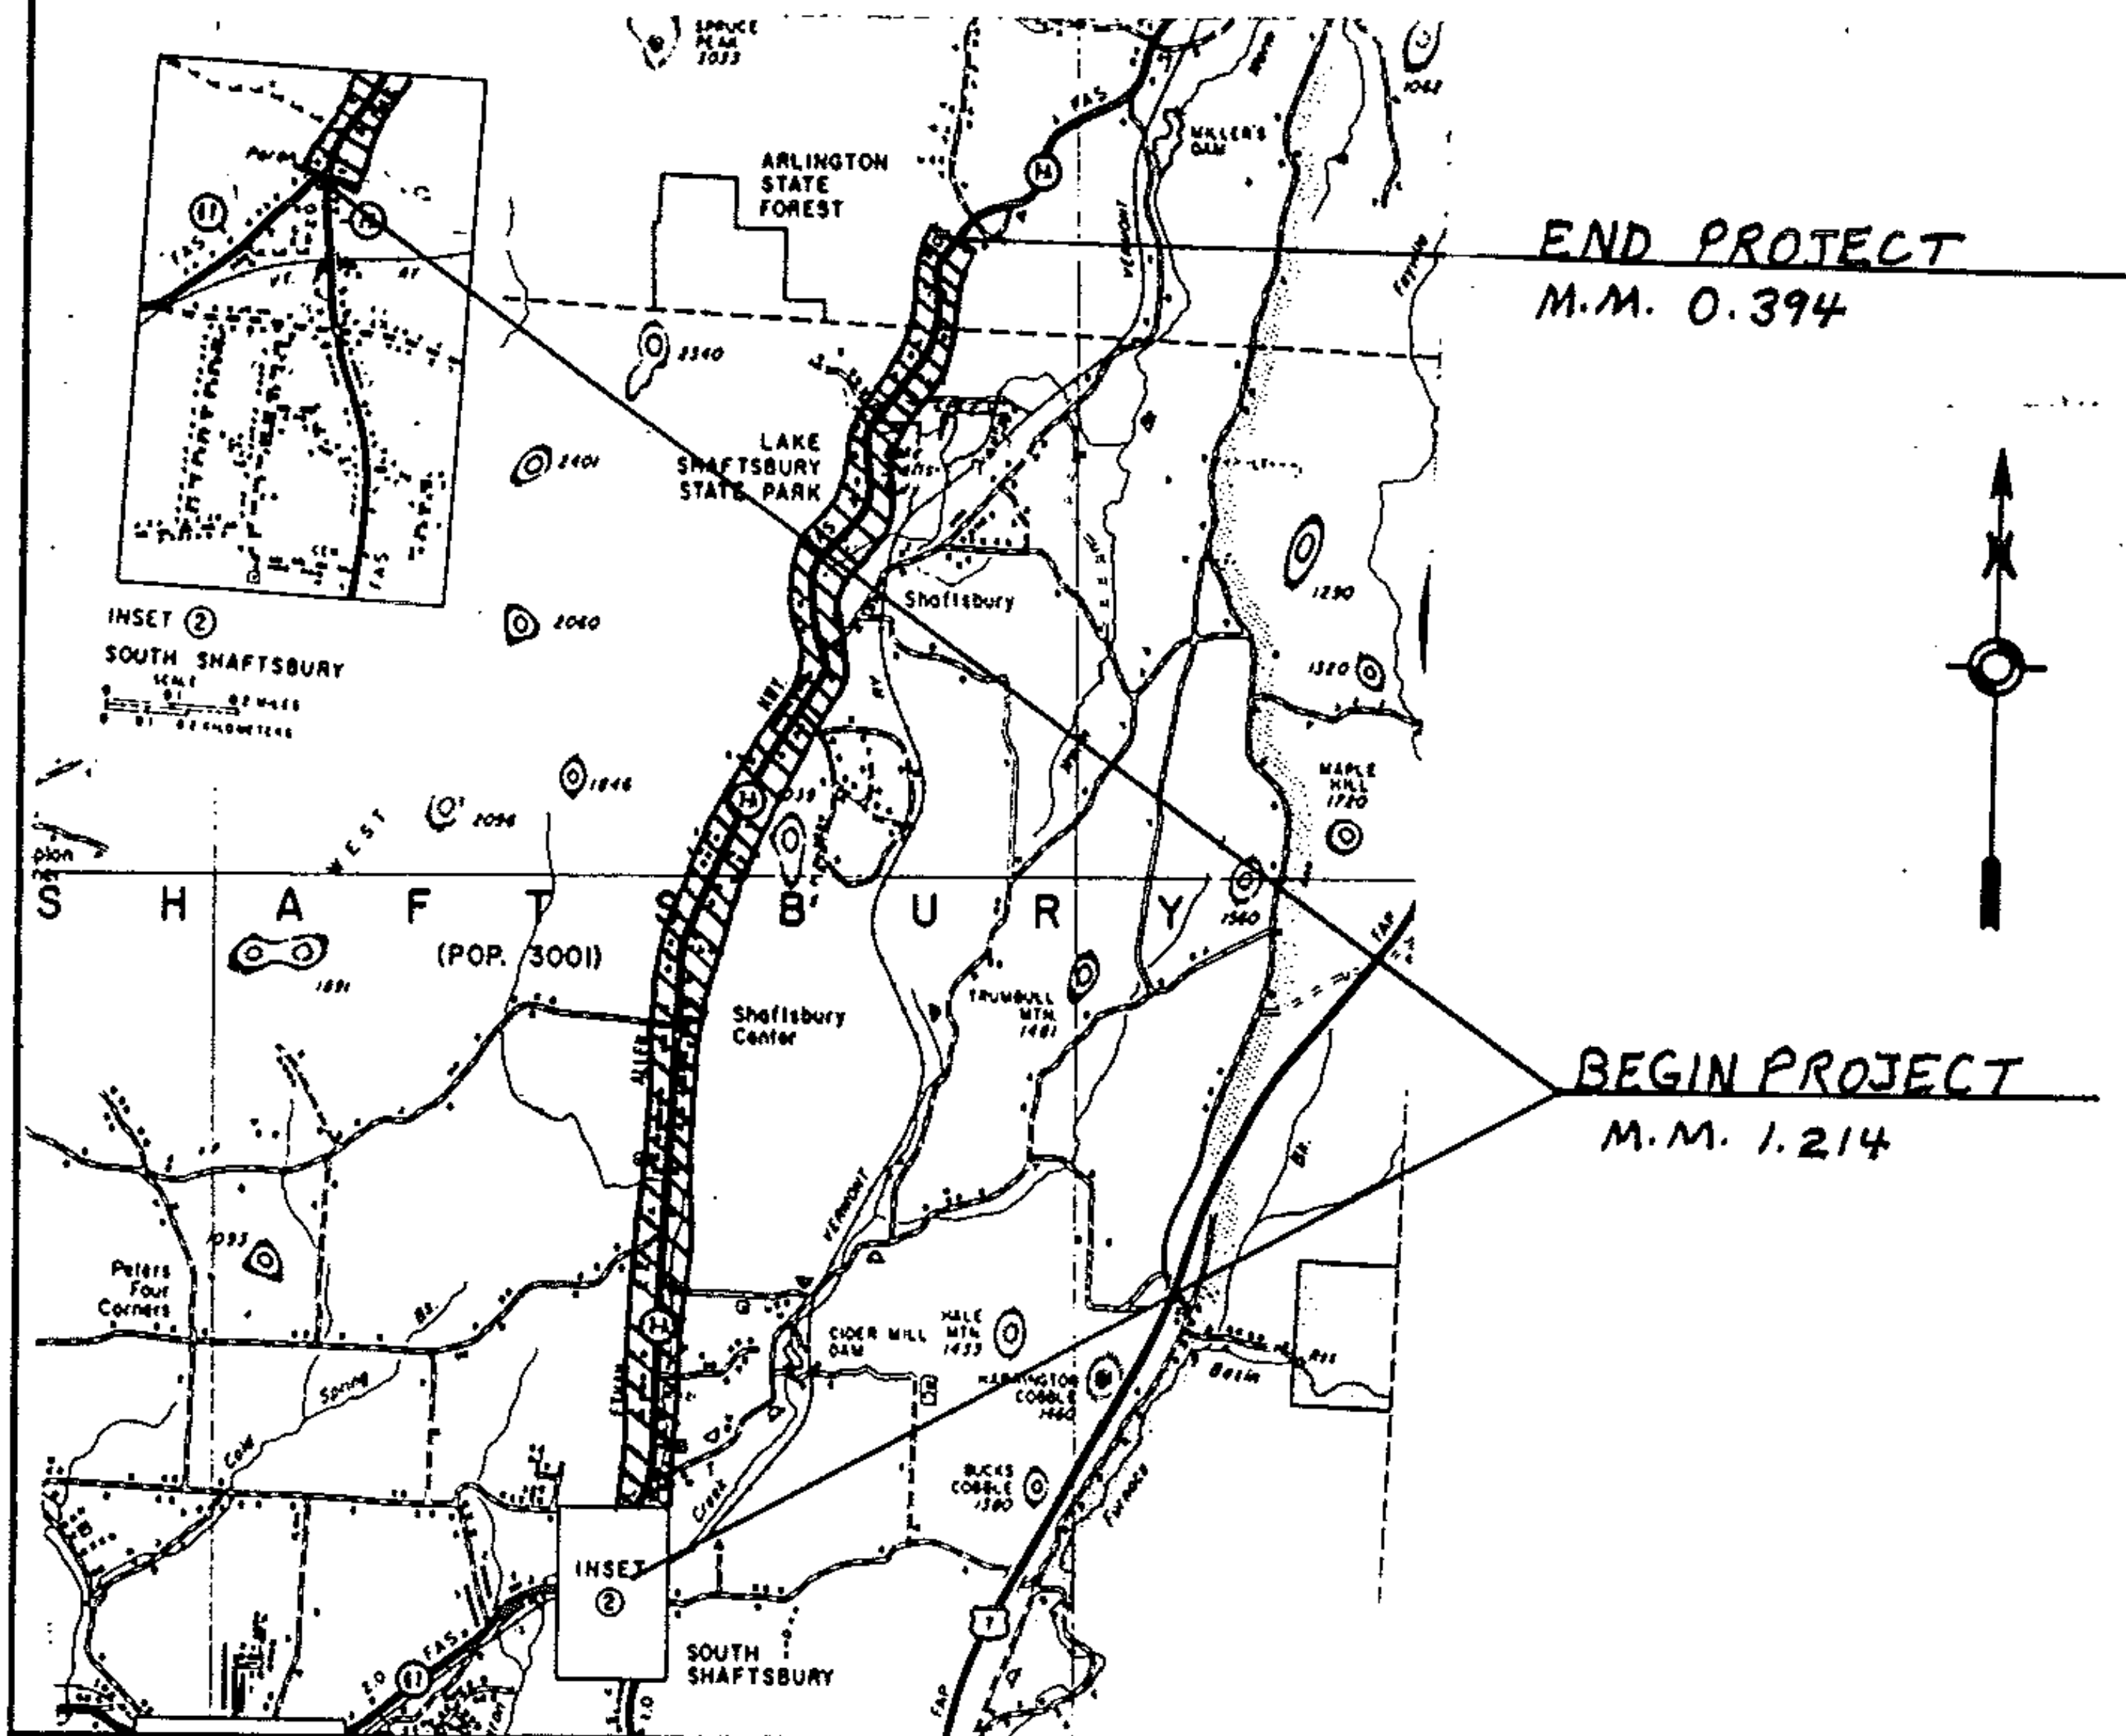

END PROJECT
M.M. 0.394

BEGIN PROJECT
M.M. 1.214

PROJECT SHAFTSBURY-ARLINGTON

NO. HMA 2824

SHEET 6 OF 34 SHEETS