
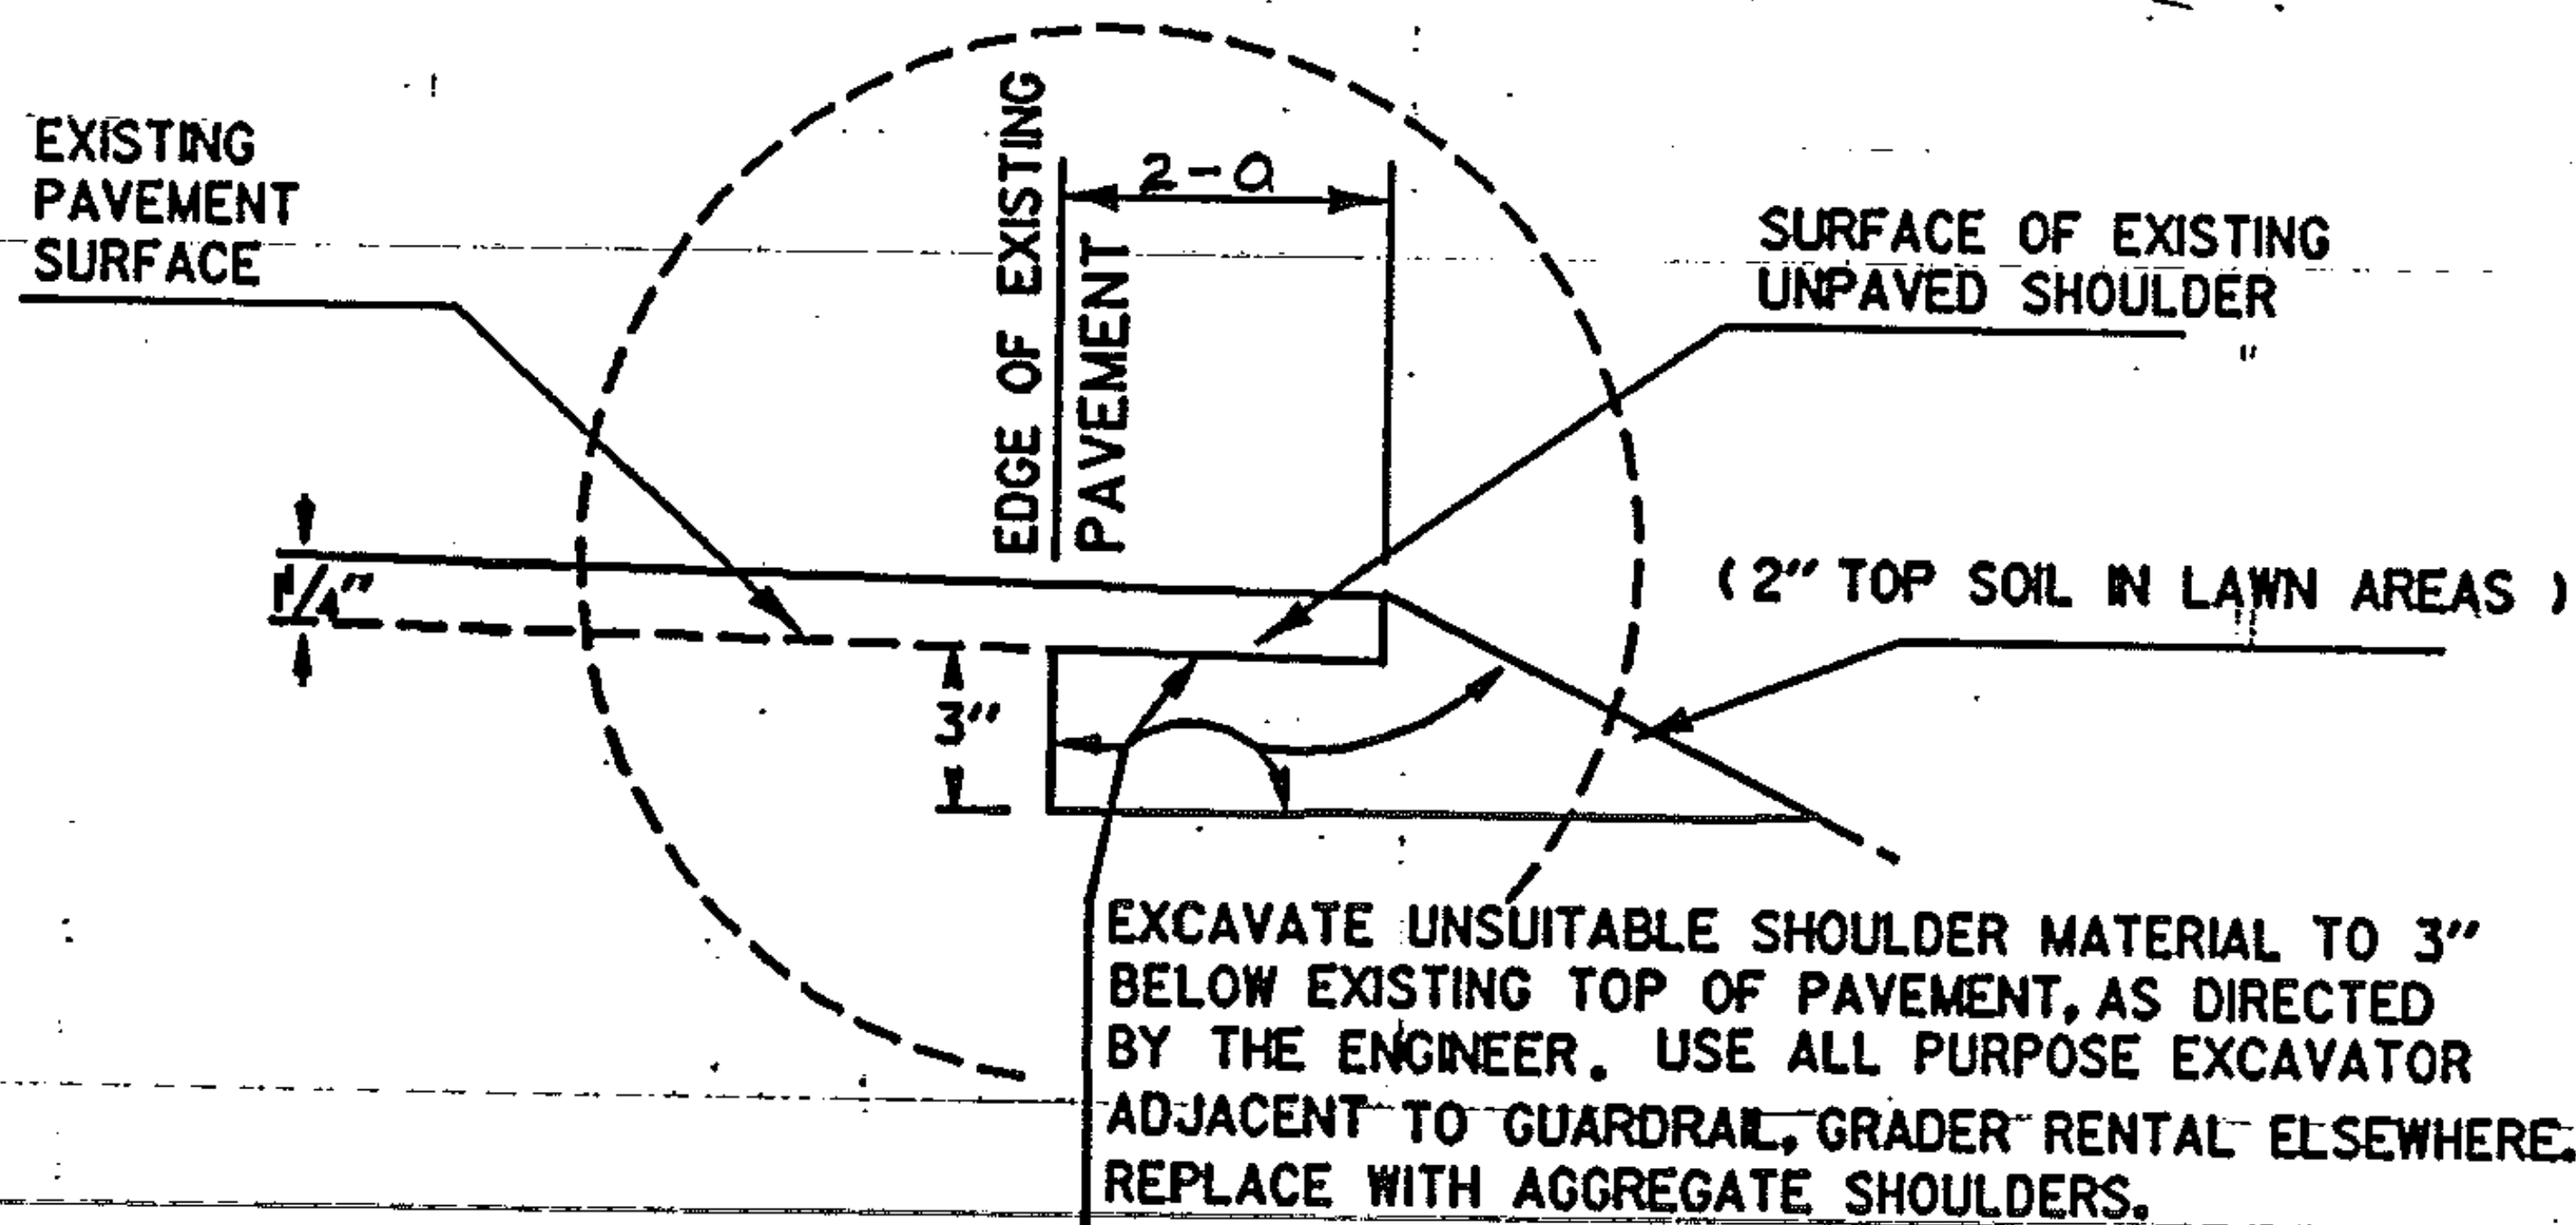


TYPICAL SECTIONS & DESIGN DATA

ITEM 406.25 BITUMINOUS CONCRETE PAVEMENT
 AGGREGATE SHOULDERS ($\pm 1/2"$)
 LEVELING COURSE TYPE IV (VARIES FROM 300/350 TONS/MILE)
 1 1/4" WEARING COURSE TYPE III ($\pm 1/4"$)
 AS DIRECTED BY THE ENGINEER

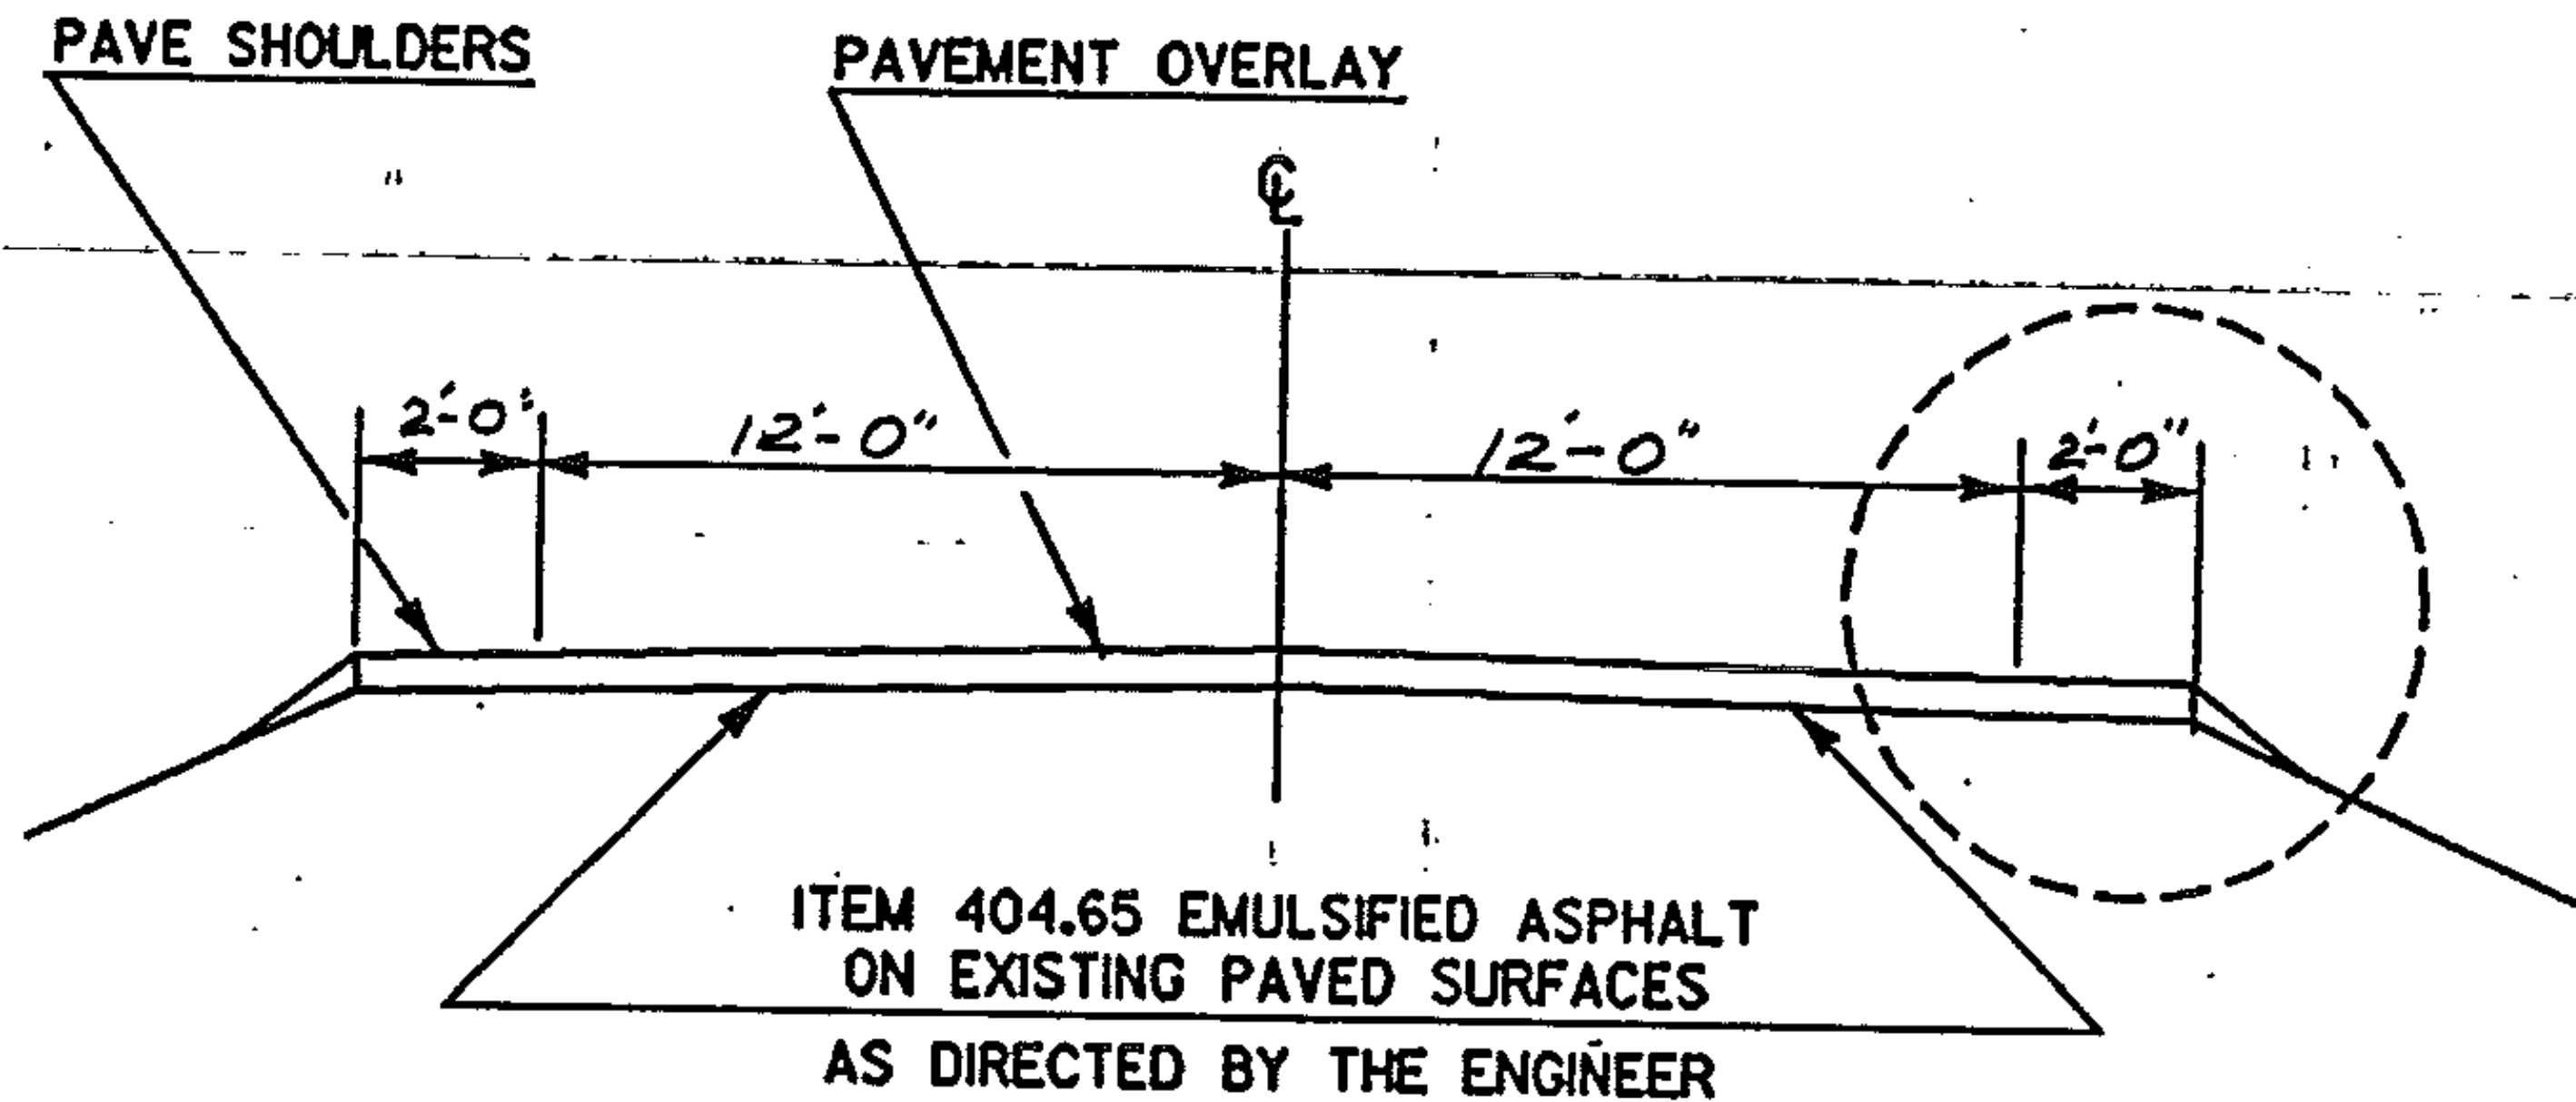

PROJECT SHAFTSBURY - ARLINGTON

NO. HMA 2824

SHEET 8 OF 34 SHEETS

Handwritten signature