


NOT TO SCALE

HISTORIC TA

Location of Stop Bars to Be Determined By Resident Engineer.
 Signs Not Shown To Be Retained.

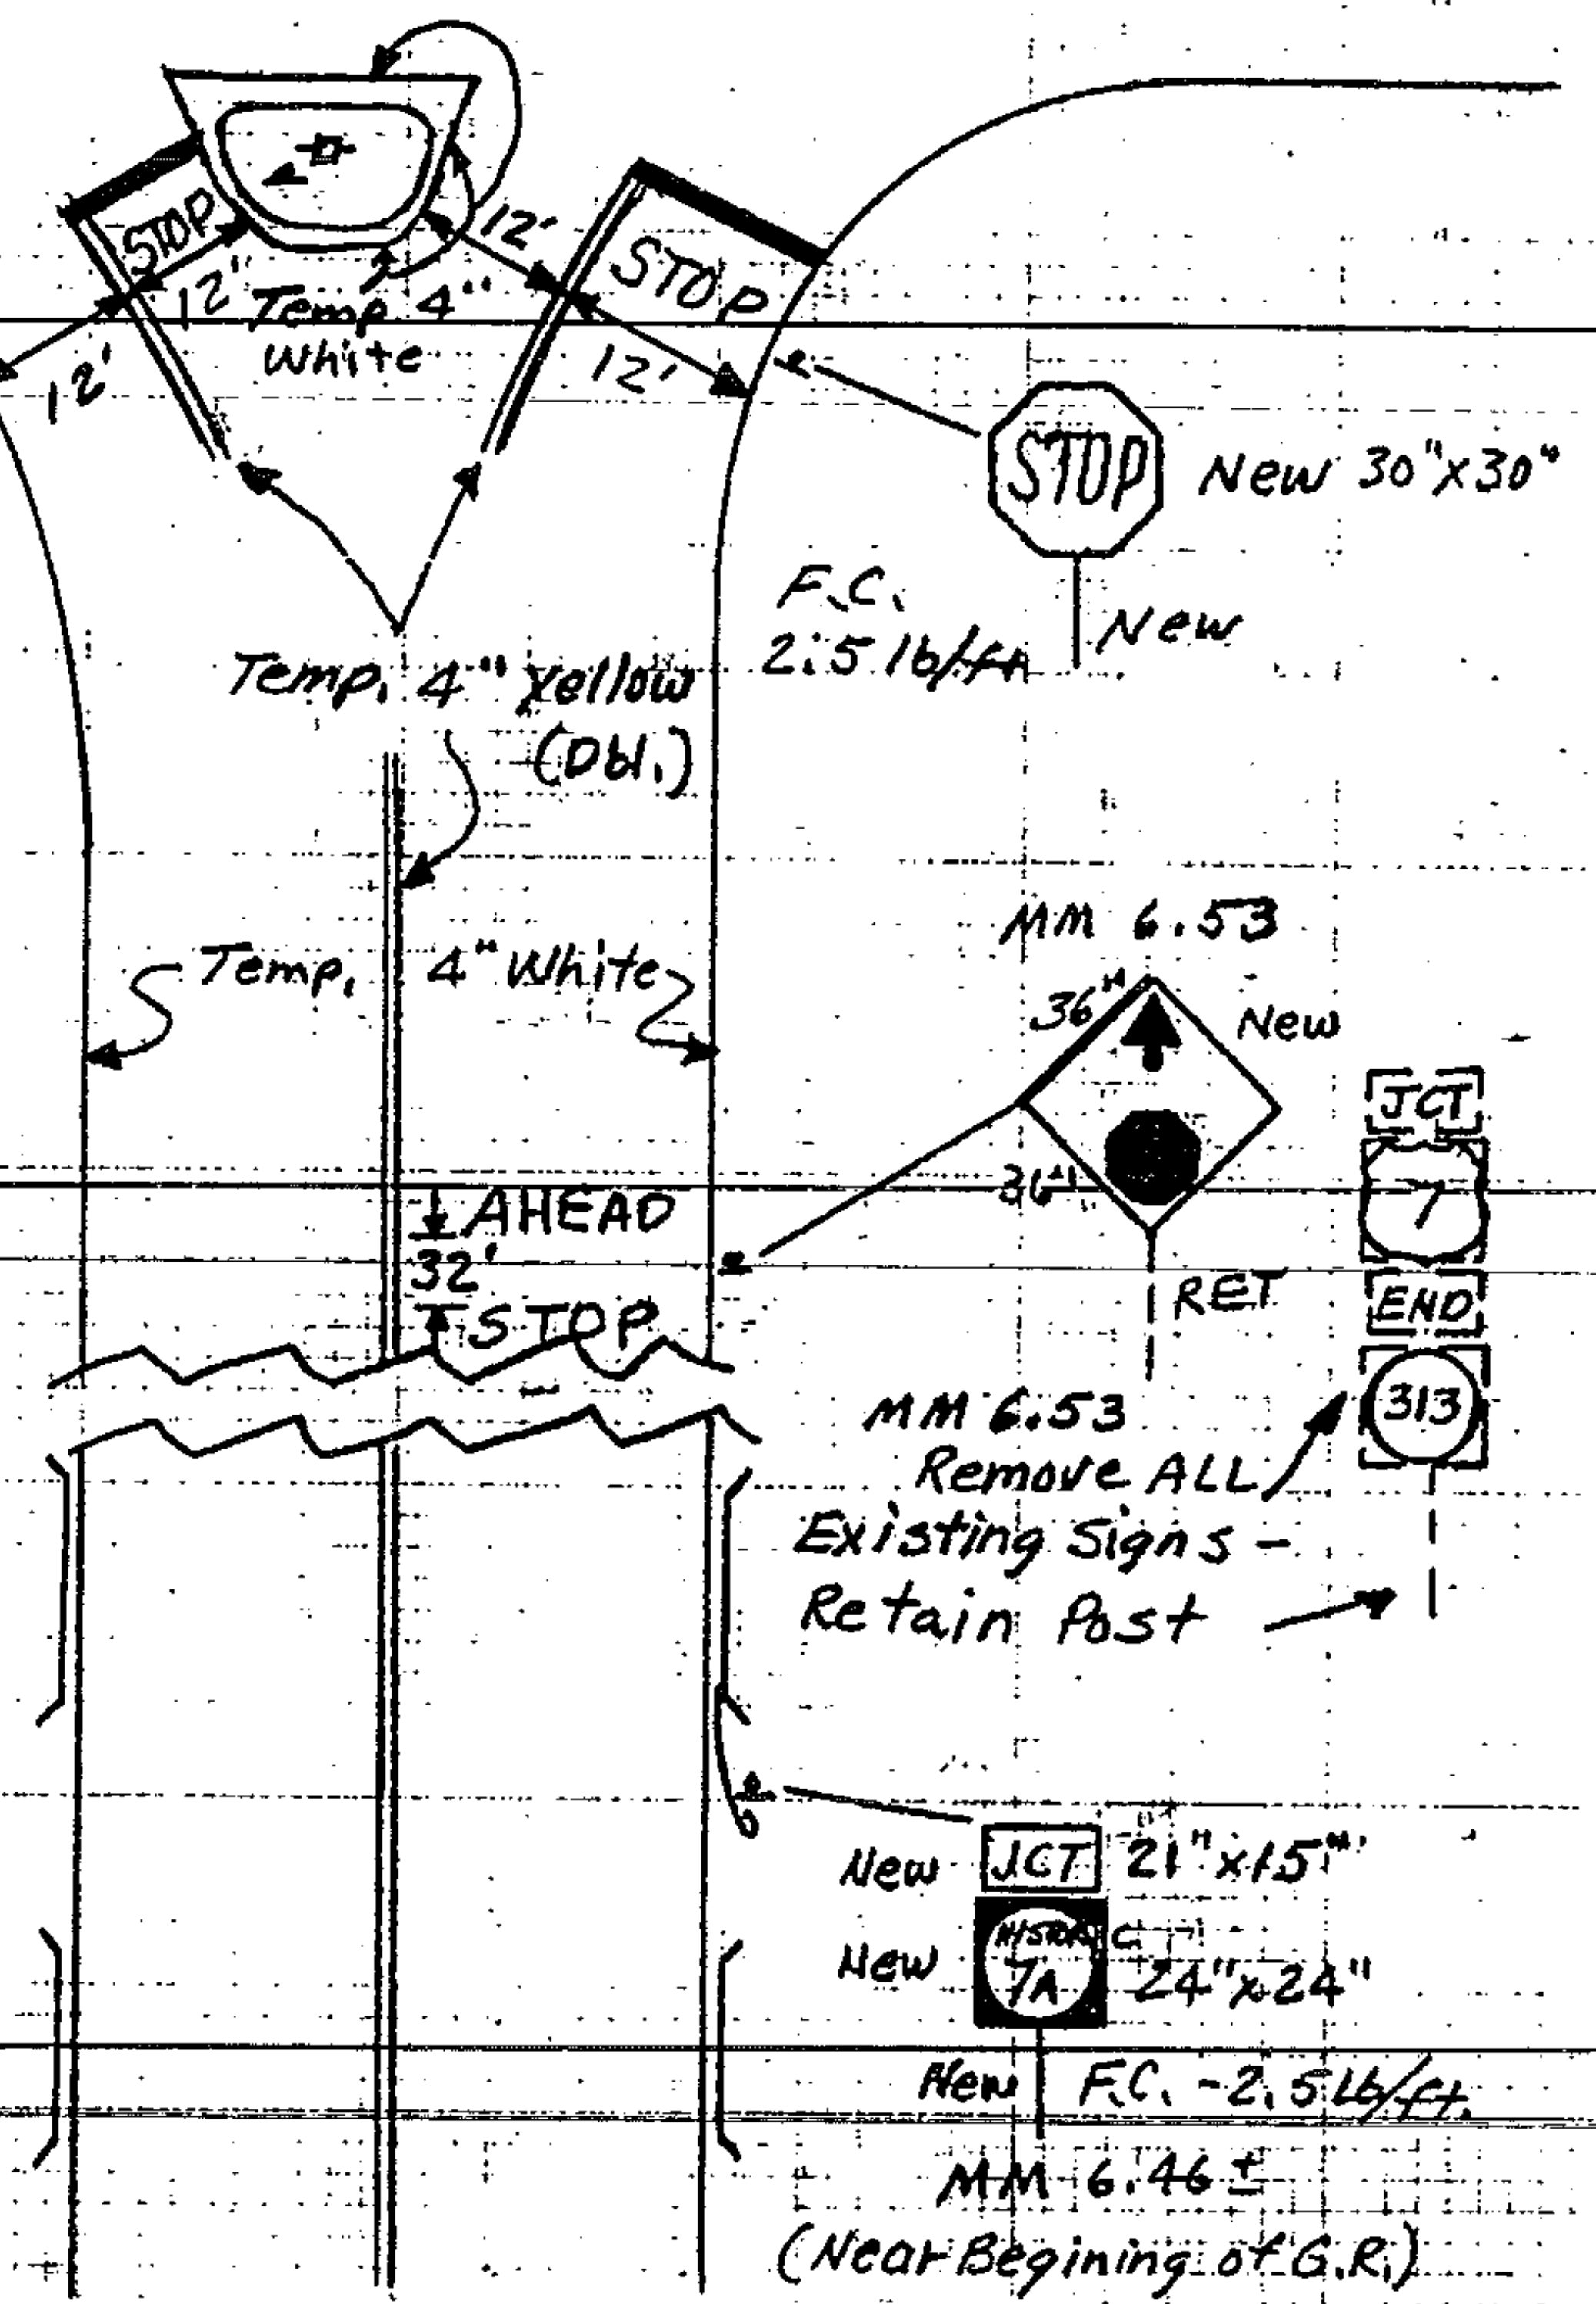

MM 6.53
 Remove ALL Existing Signs - Retain Post

New JCT 21" x 15"
 New MISTRAL 7A 24" x 24"

New F.C. - 2.5 lb/ft.

MM 6.46 ±
 (Near Beginning of G.R.)