


DESCRIPTION AND LOCATION

PROJECT LENGTH: 6.370 MILES, 33,633.60 FEET
1986 A.D.T.: 1690

BEGINNING IN THE TOWN OF ARLINGTON AT THE NEW YORK STATE LINE ON VT. 313 AT M.M. 0.000 AND EXTENDING EASTERLY 6.370 MILES TO M.M. 6.370. RESURFACING OF THE HIGHWAY AND ITS APPROACHES, NEW PAVEMENT MARKINGS.

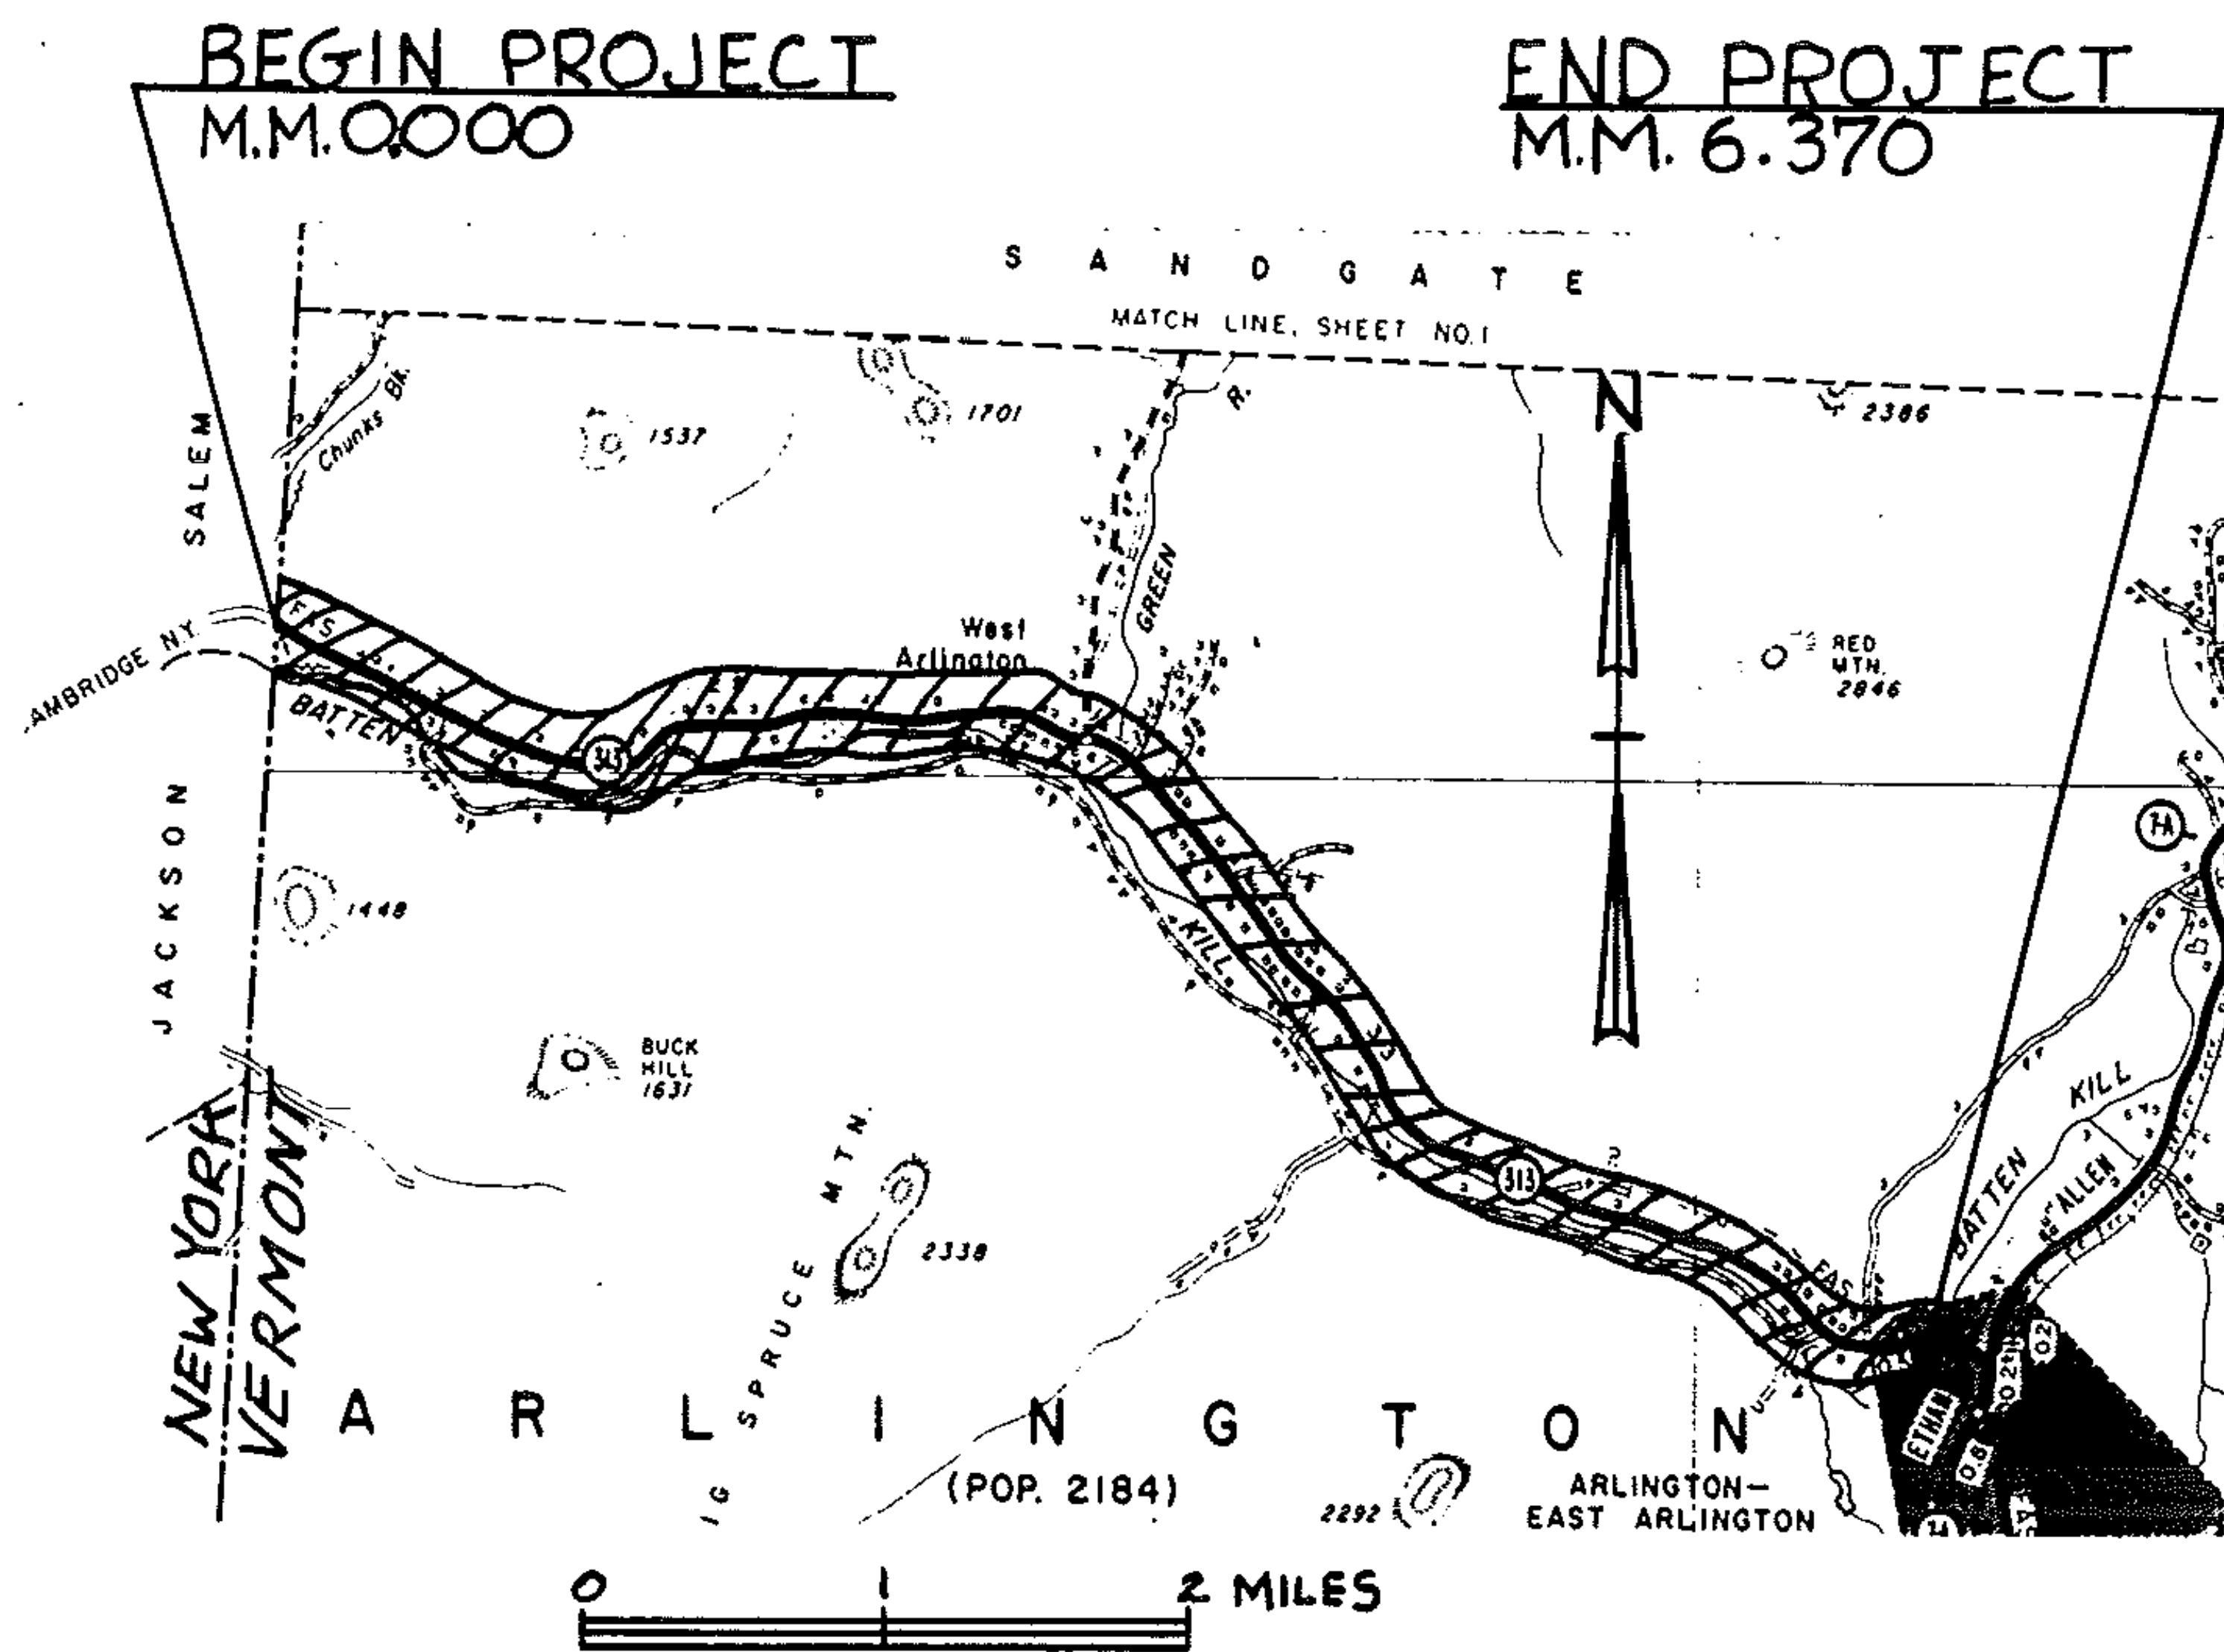

PROJECT ARLINGTON

NO. HMA 2858

SHEET 28 OF 34 SHEETS