


# TYPICAL SECTIONS & DESIGN DATA


BITUMINOUS CONCRETE PAVEMENT  
 LEVELING COURSE TYPE IV (295\* & 455\*\* TONS/MILE)  
 AS DIRECTED BY THE ENGINEER.  
 1 1/4" WEARING COURSE TYPE III (±1/4" THICKNESS TOLERANCE)

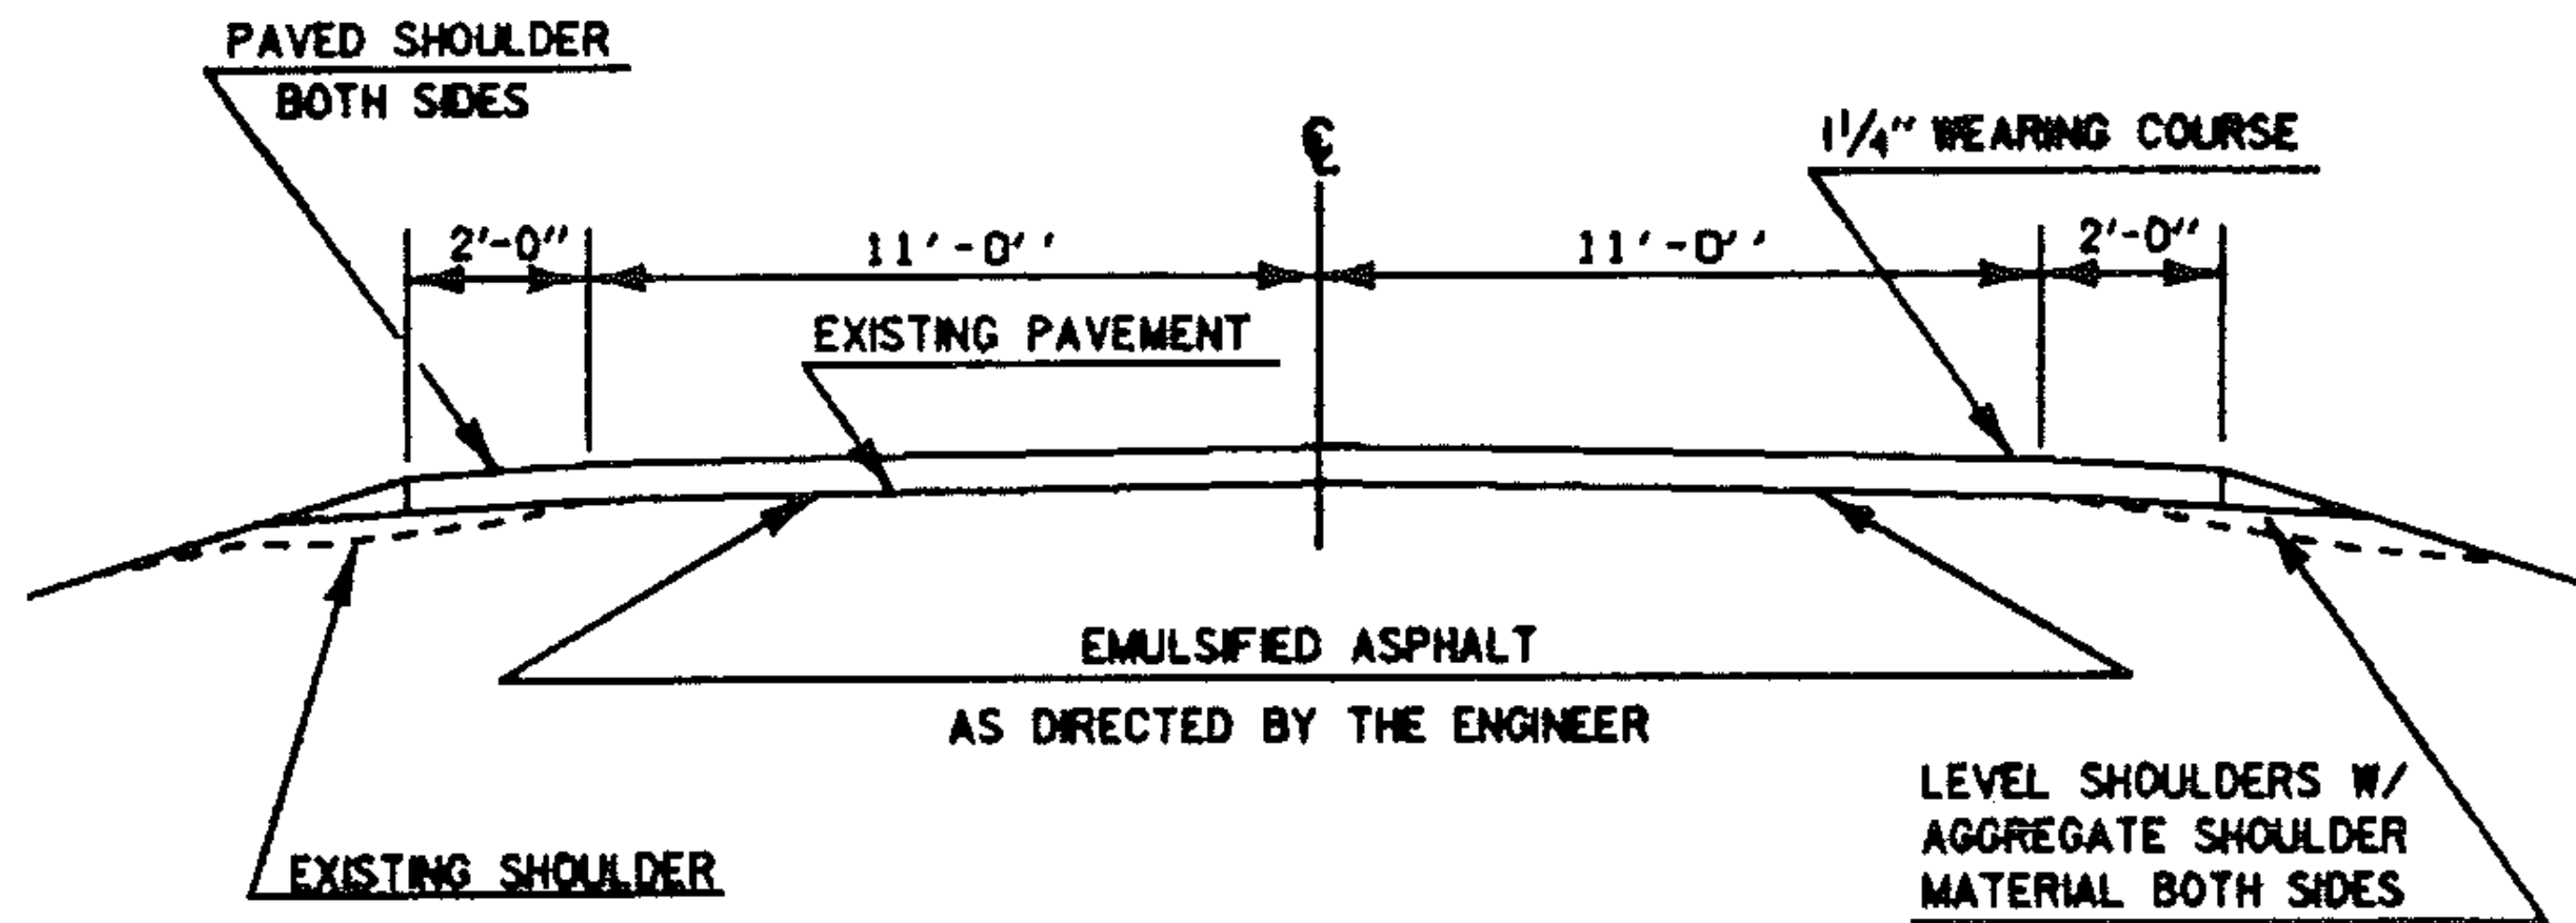

NOTE : WHEN ENCOUNTERING VEGETATION OR POOR MATERIAL IN THE SHOULDER AREA, REMOVE 2" BELOW EXISTING PAVEMENT LEVEL AND REPLACE WITH AGGREGATE SHOULDER MATERIAL. REMOVAL OF THIS MATERIAL WILL BE PAID FOR UNDER THE ITEM 'ALL PURPOSE EXCAVATOR RENTAL' OR 'GRADER RENTAL'.

NOTE : BRIDGE AT MM 6.109 IS NOT TO BE PAVED.

VT.17 MM 2.624 ~ MM 3.220\*  
 VT.17 MM 3.883 ~ MM 8.365\*

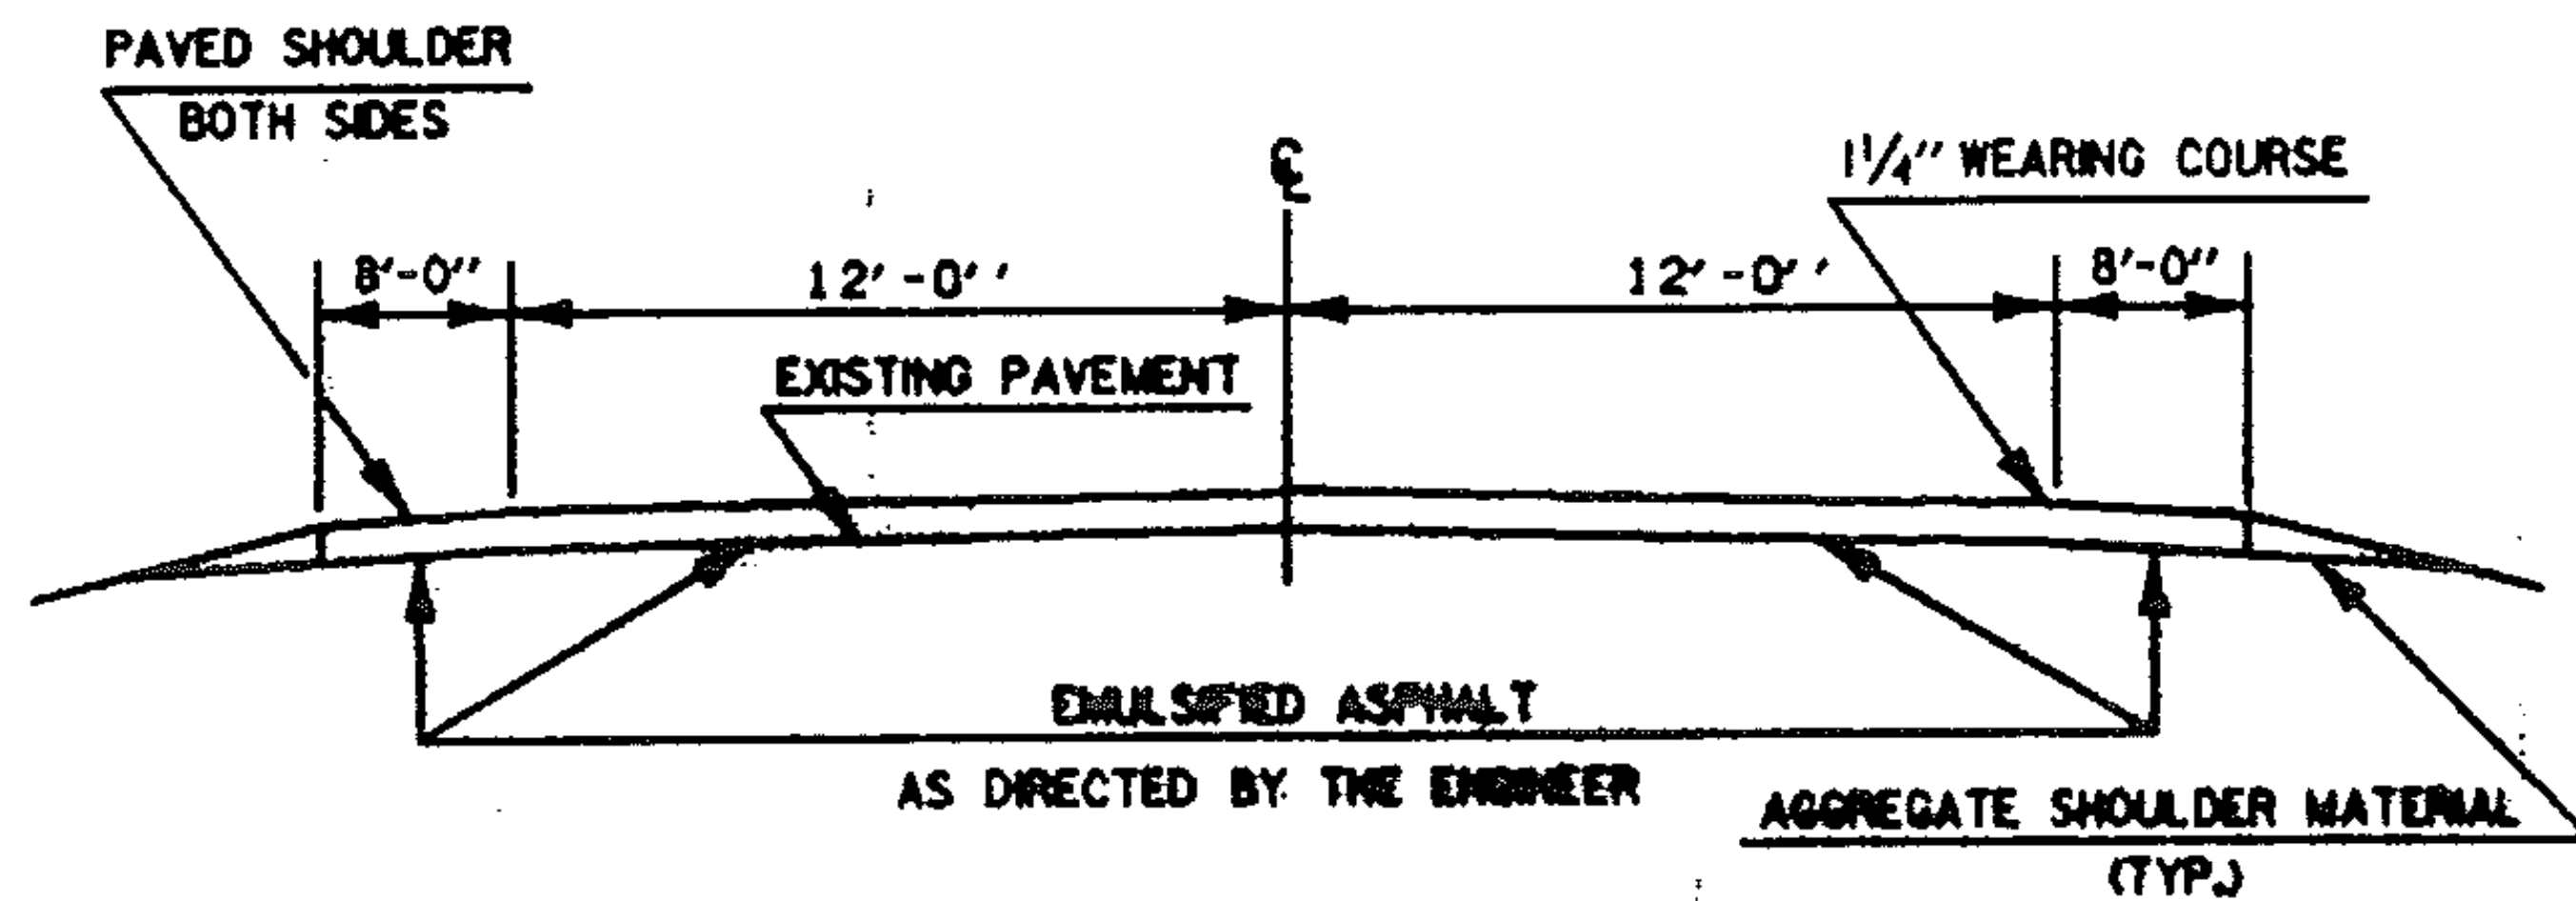

VT.17 MM 3.220 ~ MM 3.883\*\*

PROJECT ADDISON

NO. HMA 284I  
 SHEET 4 OF 8 SHEETS  
 SHEET 9 OF 75 SHEETS