

STATE OF VERMONT
 AGENCY OF TRANSPORTATION




PROPOSED IMPROVEMENT

TOWN OF Rutland-Mendon


COUNTY OF Rutland

ROUTE NO. US 4

ROUTE CLASS FAP

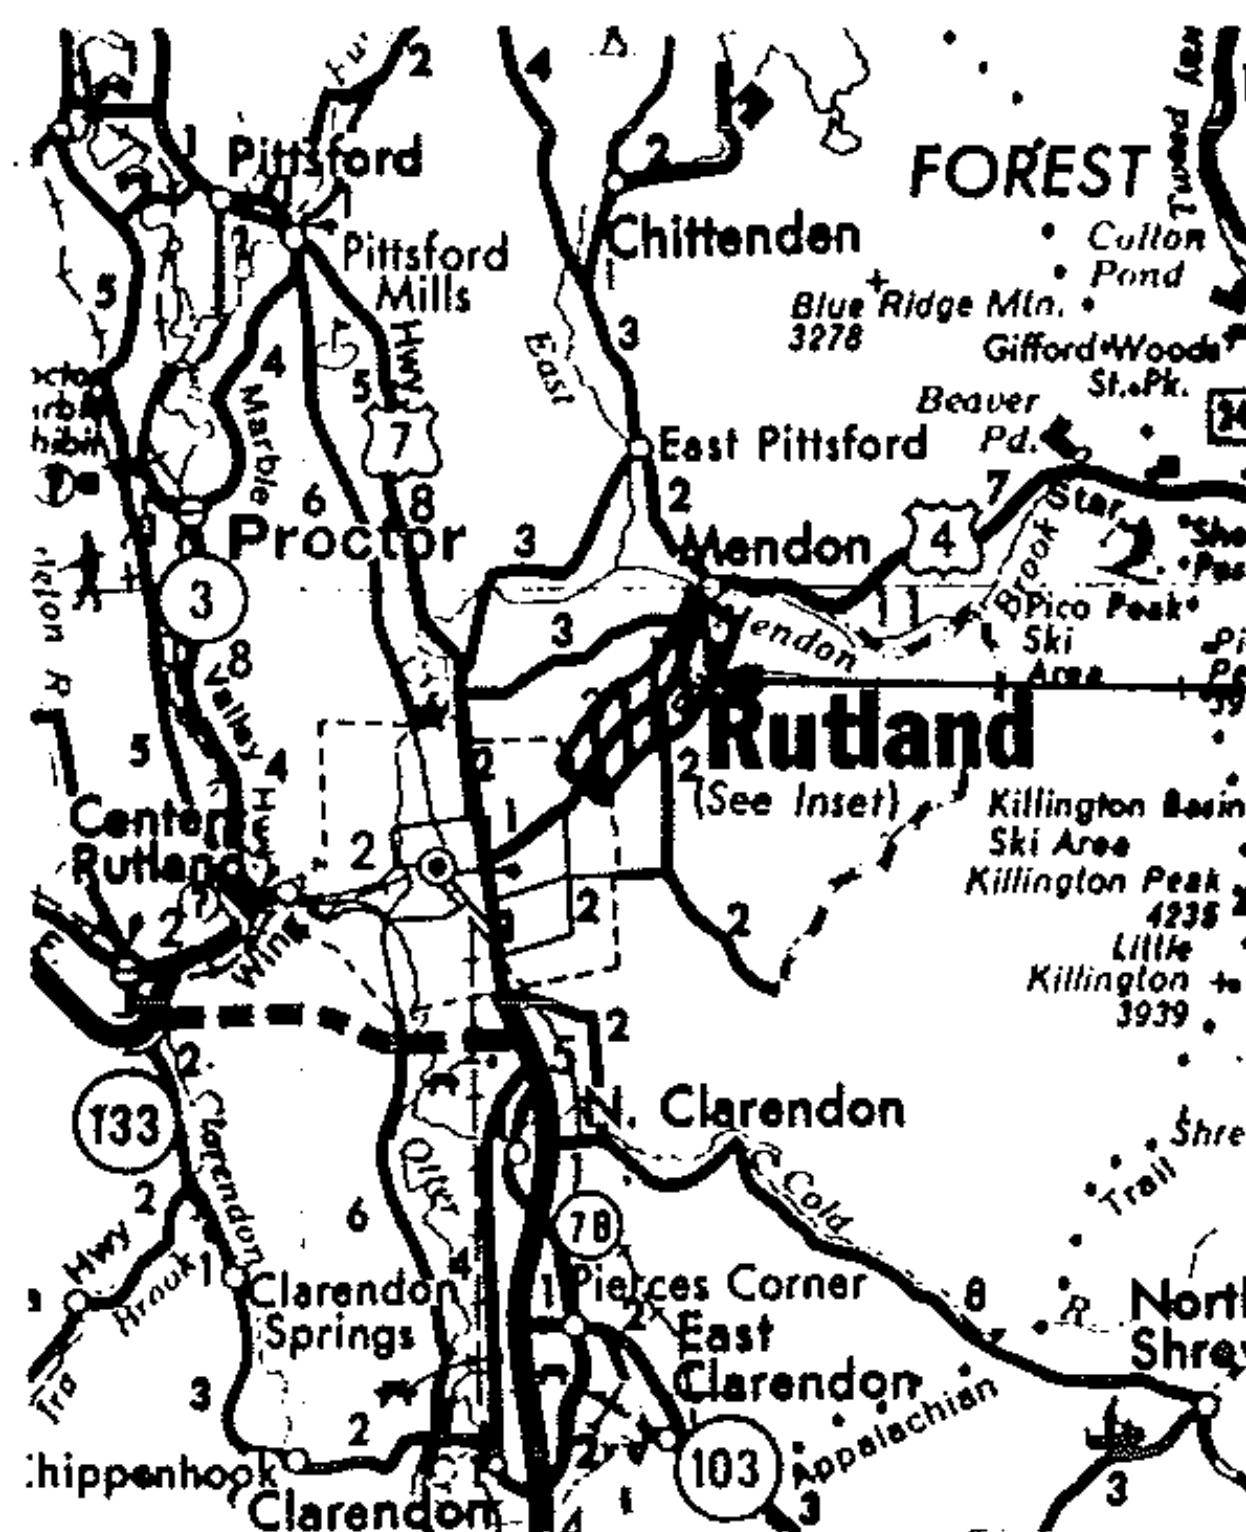

PROJECT
 HMA 2847

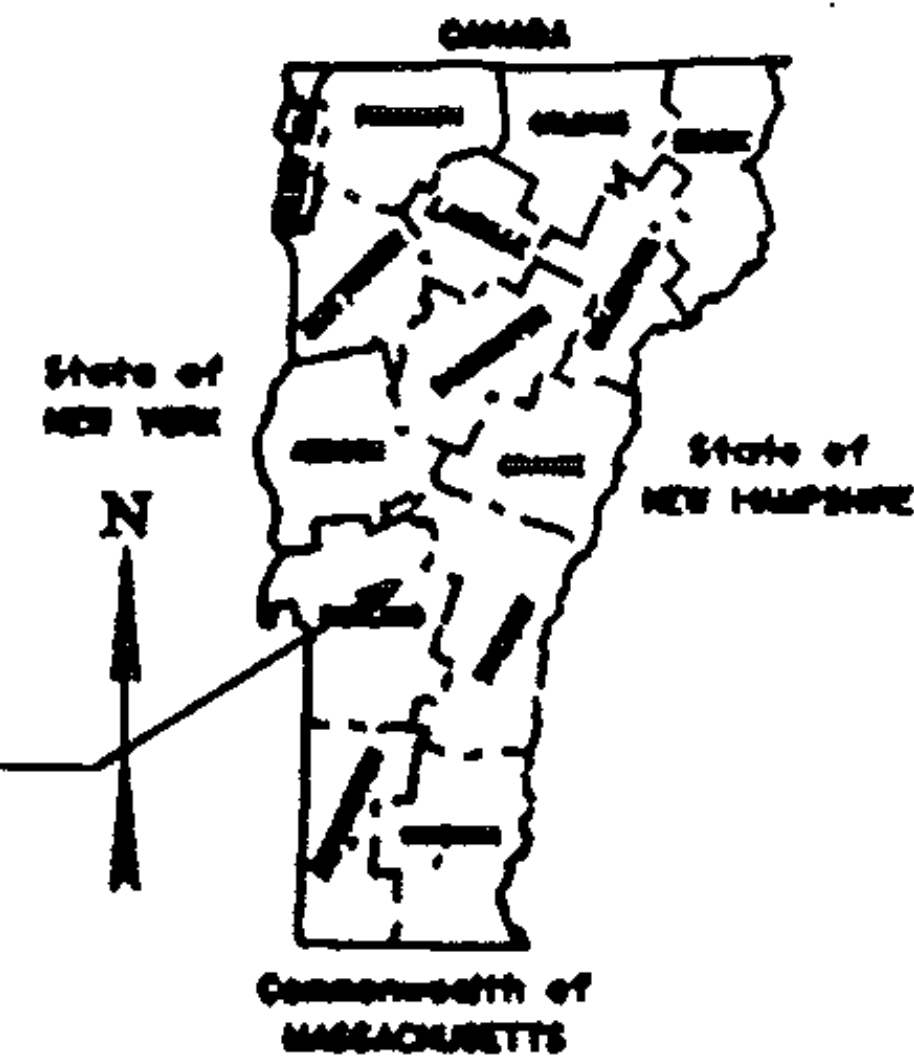

THESE PLANS ARE SUBJECT TO SUCH ENGINEERING CHANGES AS MAY BE REQUIRED BY THE FEDERAL HIGHWAY ADMINISTRATION OR THE CHIEF ENGINEER. CONSTRUCTION IS TO BE CARRIED ON IN ACCORDANCE WITH THESE PLANS AND THE STANDARD SPECIFICATIONS FOR CONSTRUCTION DATED 1996, AS APPROVED BY THE FEDERAL HIGHWAY ADMINISTRATION ON NOVEMBER 8, 1996 FOR USE ON THIS PROJECT, INCLUDING ALL SUBSEQUENT REVISIONS AND SUCH REVISED SPECIFICATIONS AND SPECIAL PROVISIONS AS ARE INCORPORATED IN THESE PLANS.

SUBMITTED BY ORDER OF THE STATE TRANSPORTATION BOARD	
APPROVED _____	DATE _____
CHIEF ENGINEER	
DEPARTMENT OF TRANSPORTATION FEDERAL HIGHWAY ADMINISTRATION	
APPROVED _____	DATE _____
DIVISION ADMINISTRATOR	
Rutland-Mendon PROJECT HMA # 2847	
SHEET 1 OF 12 SHEETS	

See Sheet 1 For Index