



TYPICAL SECTIONS & DESIGN DATA

BITUMINOUS CONCRETE PAVEMENT
 LEVELING COURSE TYPE IV (523* & 432** TONS/MILE)
 AS DIRECTED BY THE ENGINEER.
 1 1/2" WEARING COURSE TYPE III (± 1/4" THICKNESS TOLERANCE)

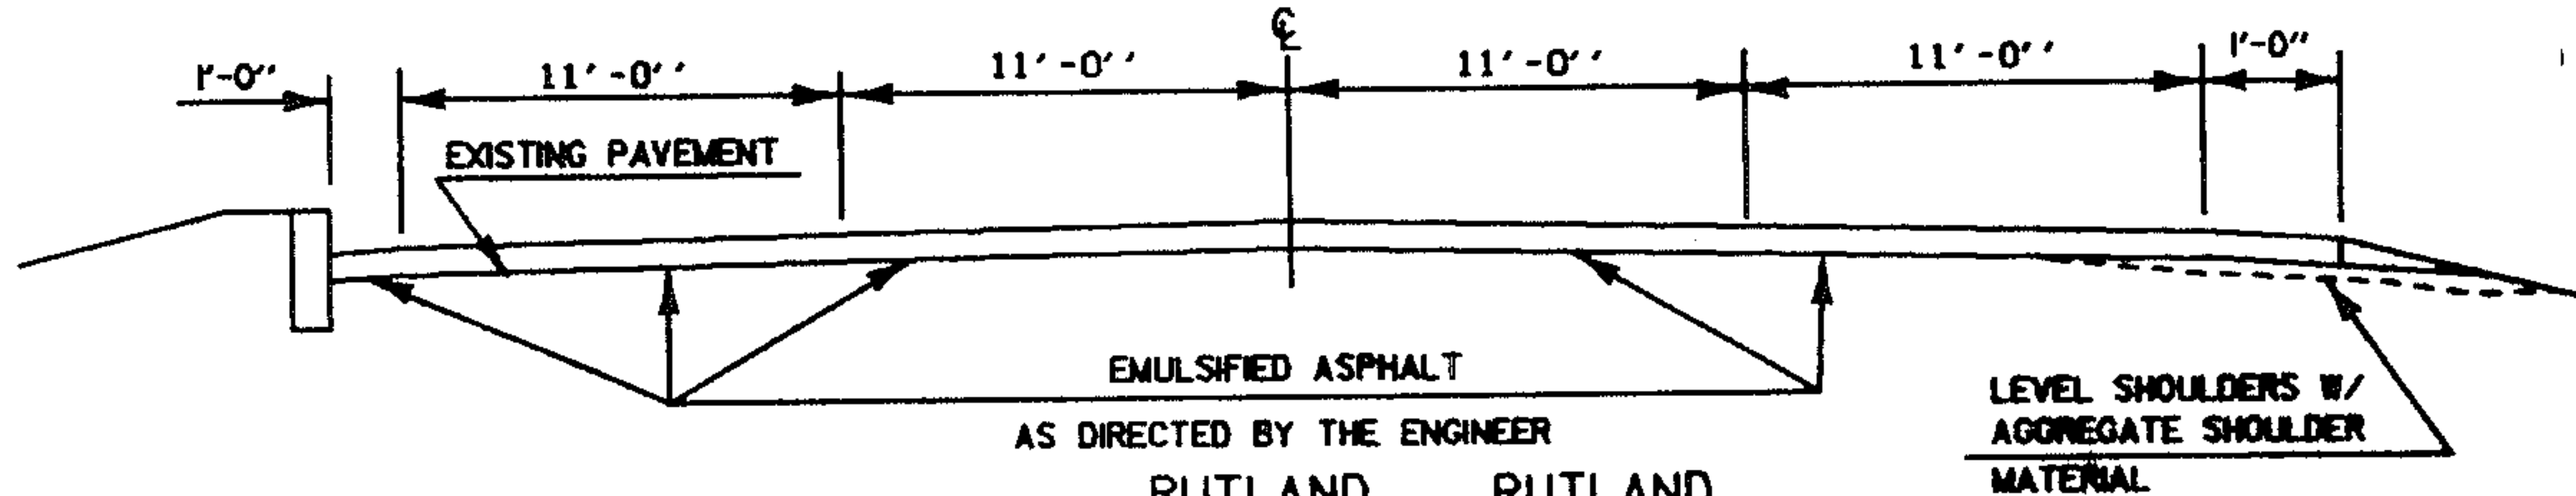

AS DIRECTED BY THE ENGINEER
 RUTLAND RUTLAND
 U.S. 4 MM 0.997 ~ MM 1.116*

RUTLAND RUTLAND
 U.S. 4 MM 1.116 ~ MM 1.286 (SEE SHEET 12 OF 12)

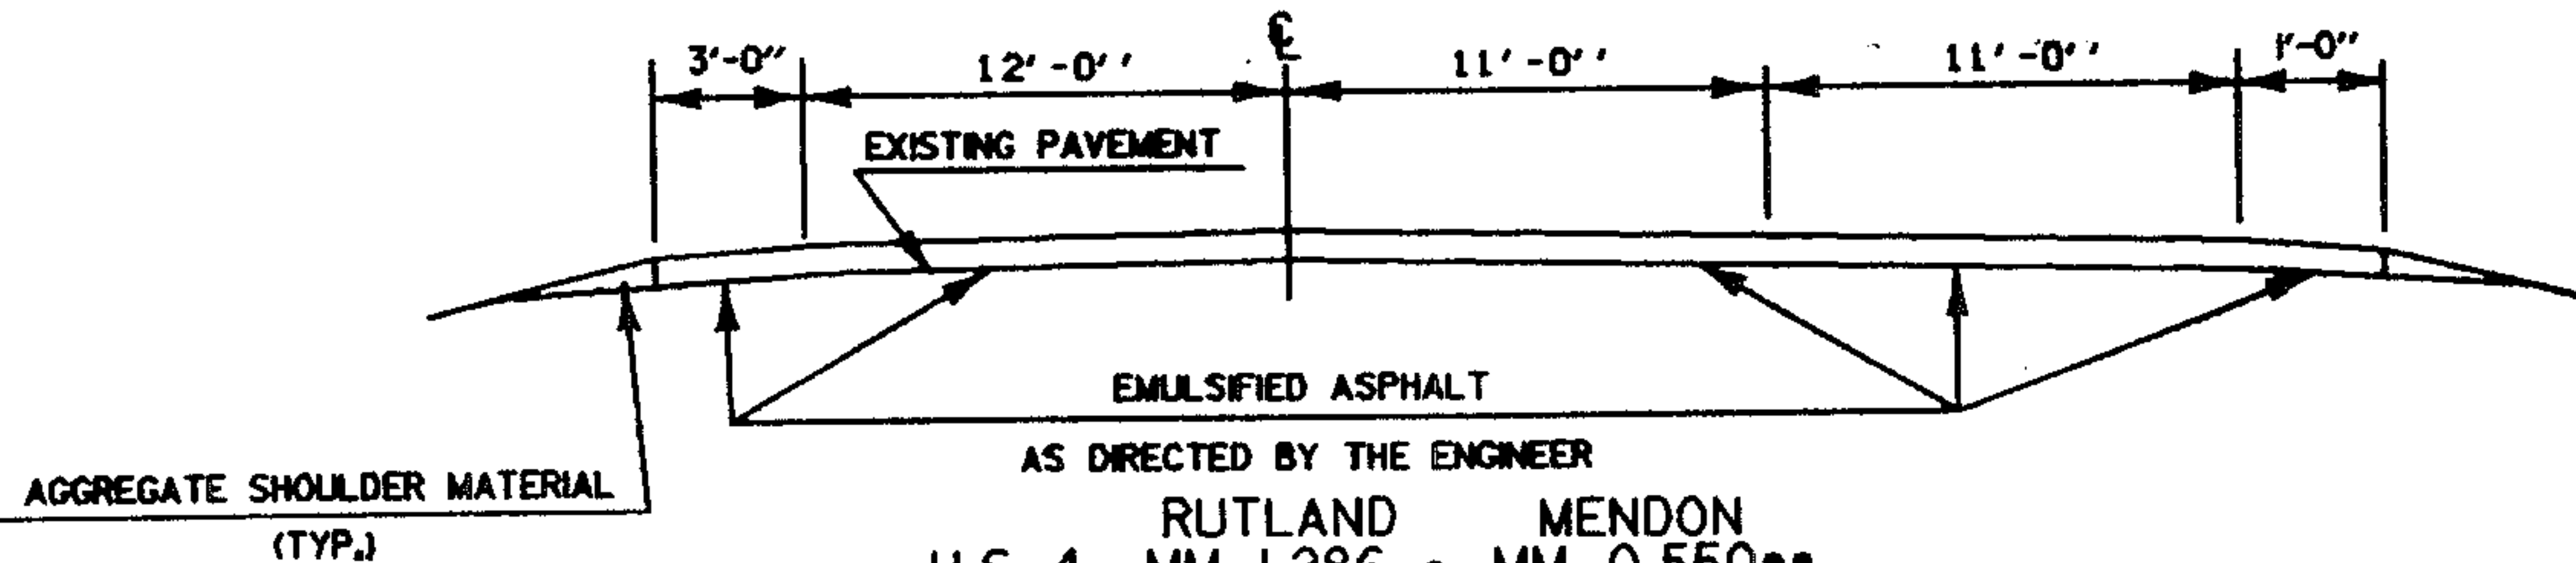

AS DIRECTED BY THE ENGINEER
 RUTLAND MENDON
 U.S. 4 MM 1.286 ~ MM 0.550**

NOTE : WHEN ENCOUNTERING VEGETATION OR POOR MATERIAL IN THE SHOULDER AREA,
 REMOVE 2" BELOW EXISTING PAVEMENT LEVEL AND REPLACE WITH AGGREGATE
 SHOULDER MATERIAL. REMOVAL OF THIS MATERIAL WILL BE PAID FOR UNDER
 THE ITEM 'ALL PURPOSE EXCAVATOR RENTAL' OR 'GRADER RENTAL'.

PROJECT RUTLAND-MENDON

NO. HMA 2847
 SHEET 4 OF 12 SHEETS
 SHEET 60 OF 75 SHEETS