


# TYPICAL SECTIONS & DESIGN DATA

BITUMINOUS CONCRETE PAVEMENT  
 LEVELING COURSE TYPE IV (414 TONS/MILE)  
 AS DIRECTED BY THE ENGINEER.  
 1 1/4" WEARING COURSE TYPE III (±1/4" THICKNESS TOLERANCE)

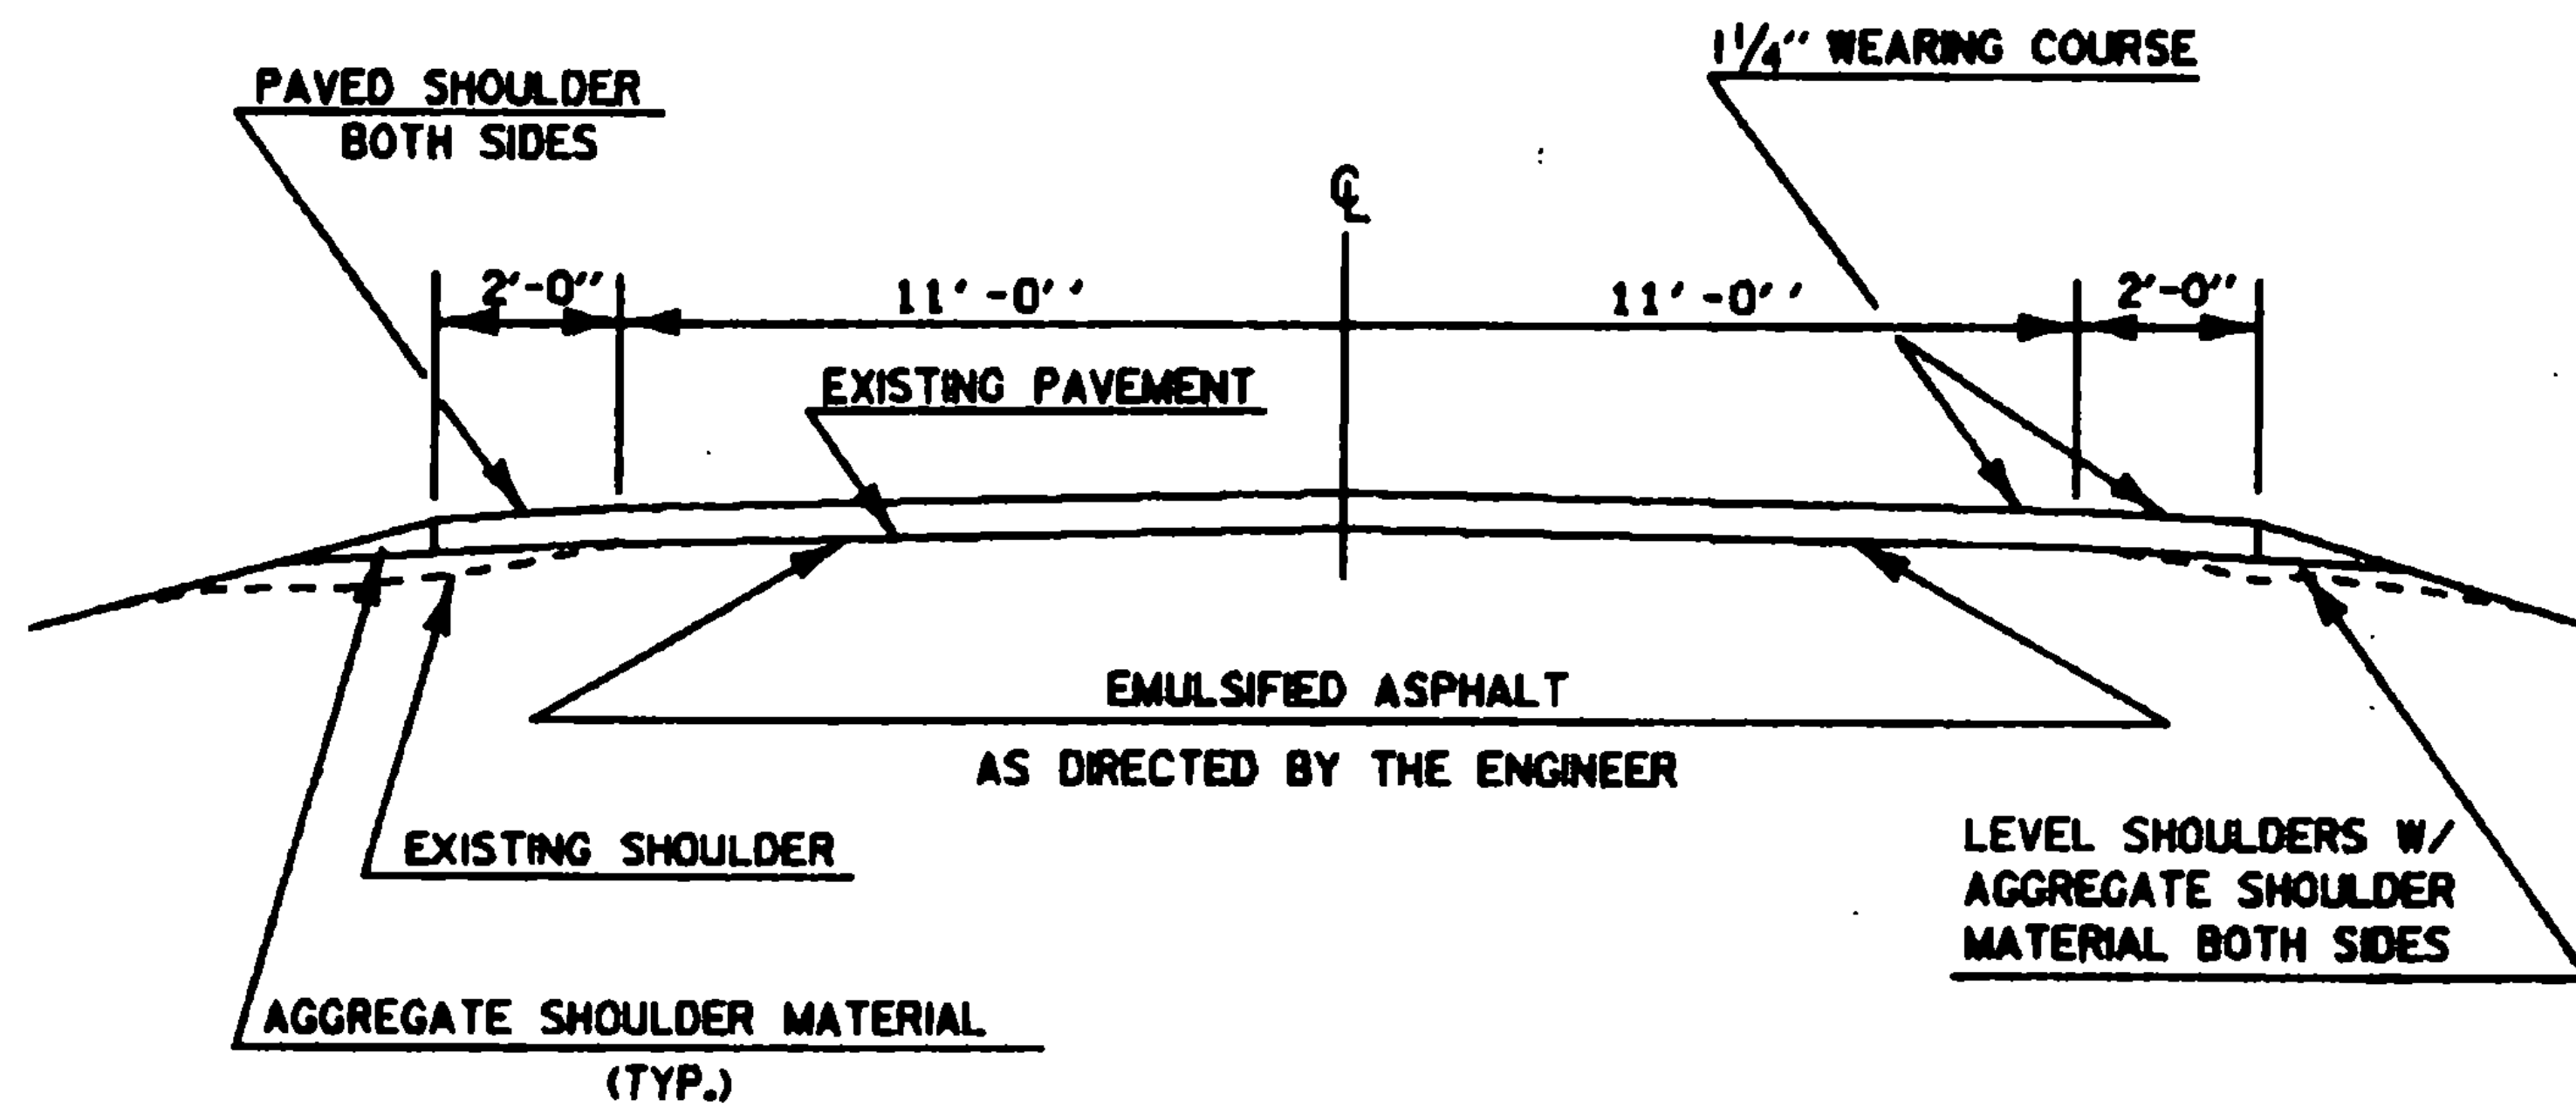

VT. 100 MM 0.570 ~ MM 2.971

NOTE : BRIDGES AT MM 2.07 AND MM 2.74 ARE NOT TO BE PAVED.

NOTE : WHEN ENCOUNTERING VEGETATION OR POOR MATERIAL IN THE SHOULDER AREA, REMOVE 2" BELOW EXISTING PAVEMENT LEVEL AND REPLACE WITH AGGREGATE SHOULDER MATERIAL. REMOVAL OF THIS MATERIAL WILL BE PAID FOR UNDER THE ITEM 'ALL PURPOSE EXCAVATOR RENTAL' OR 'GRADER RENTAL'.

PROJECT GRANVILLE

NO. HMA 2860  
 SHEET 4 OF 10 SHEETS  
 SHEET 6 OF 38 SHEETS