



PAVING LIMITS FOR DRIVES & TOWN ROADS

PAVING LIMITS FOR TOWN ROADS

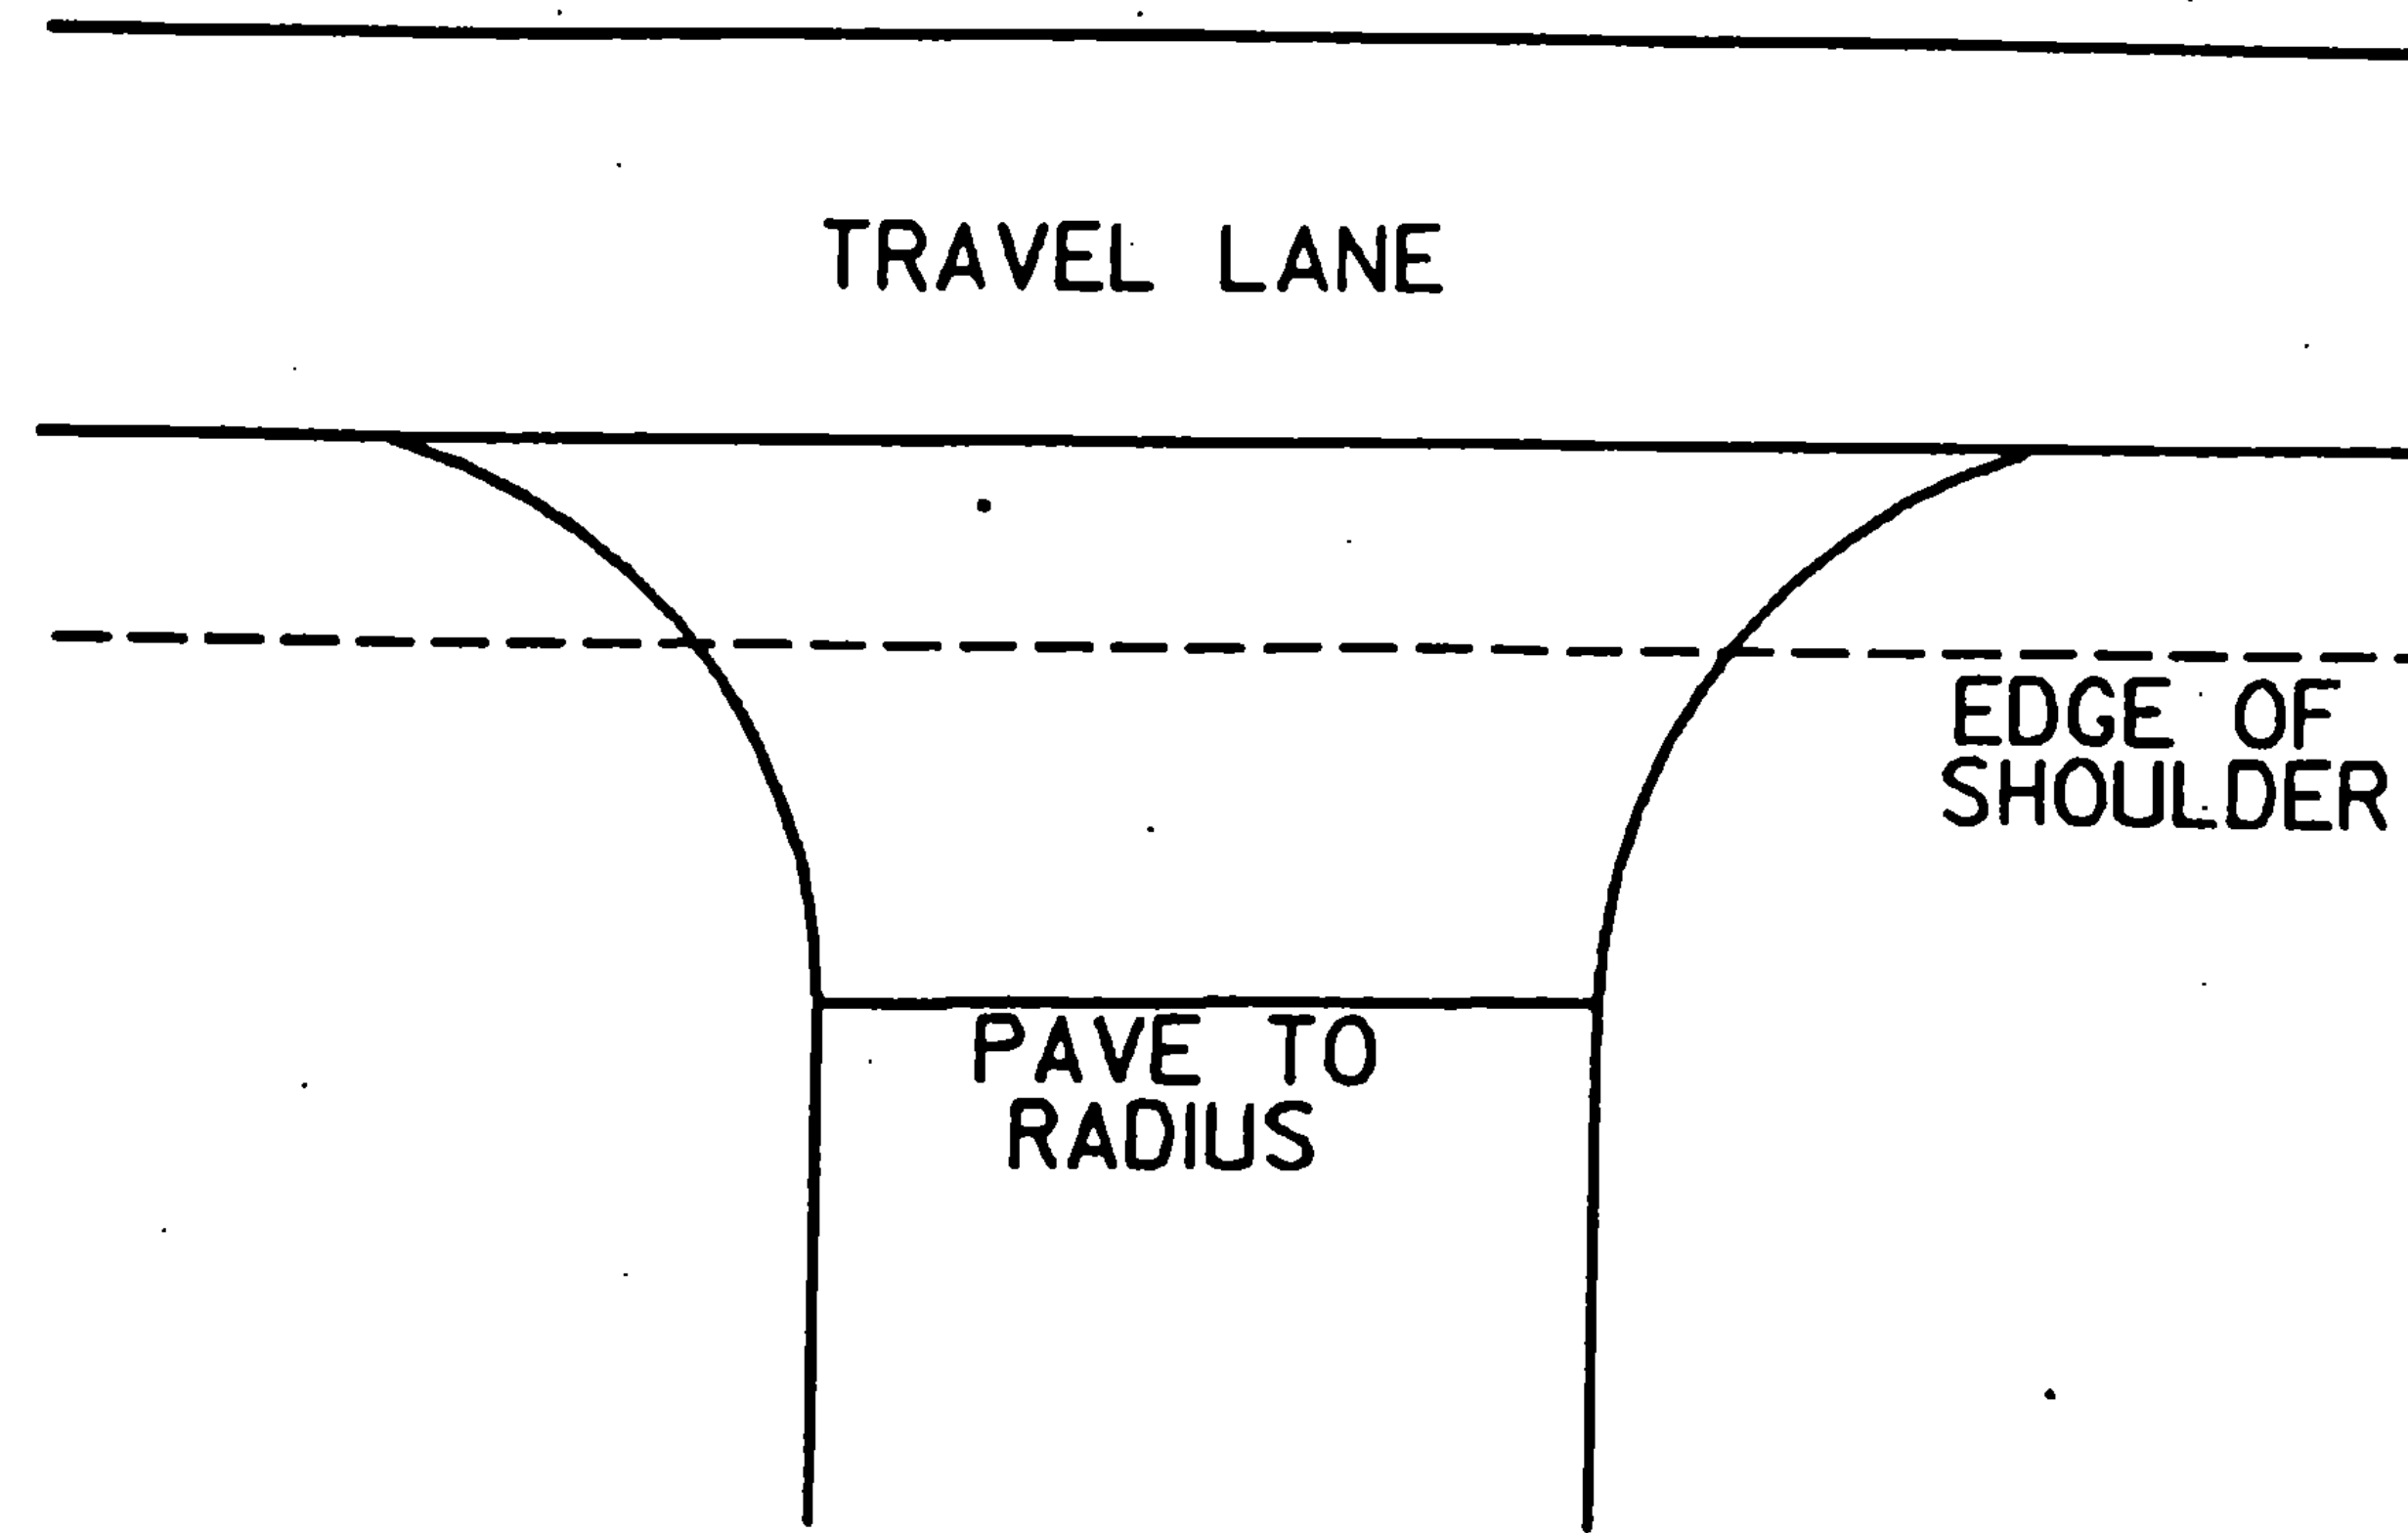

PAVING LIMITS FOR DRIVES

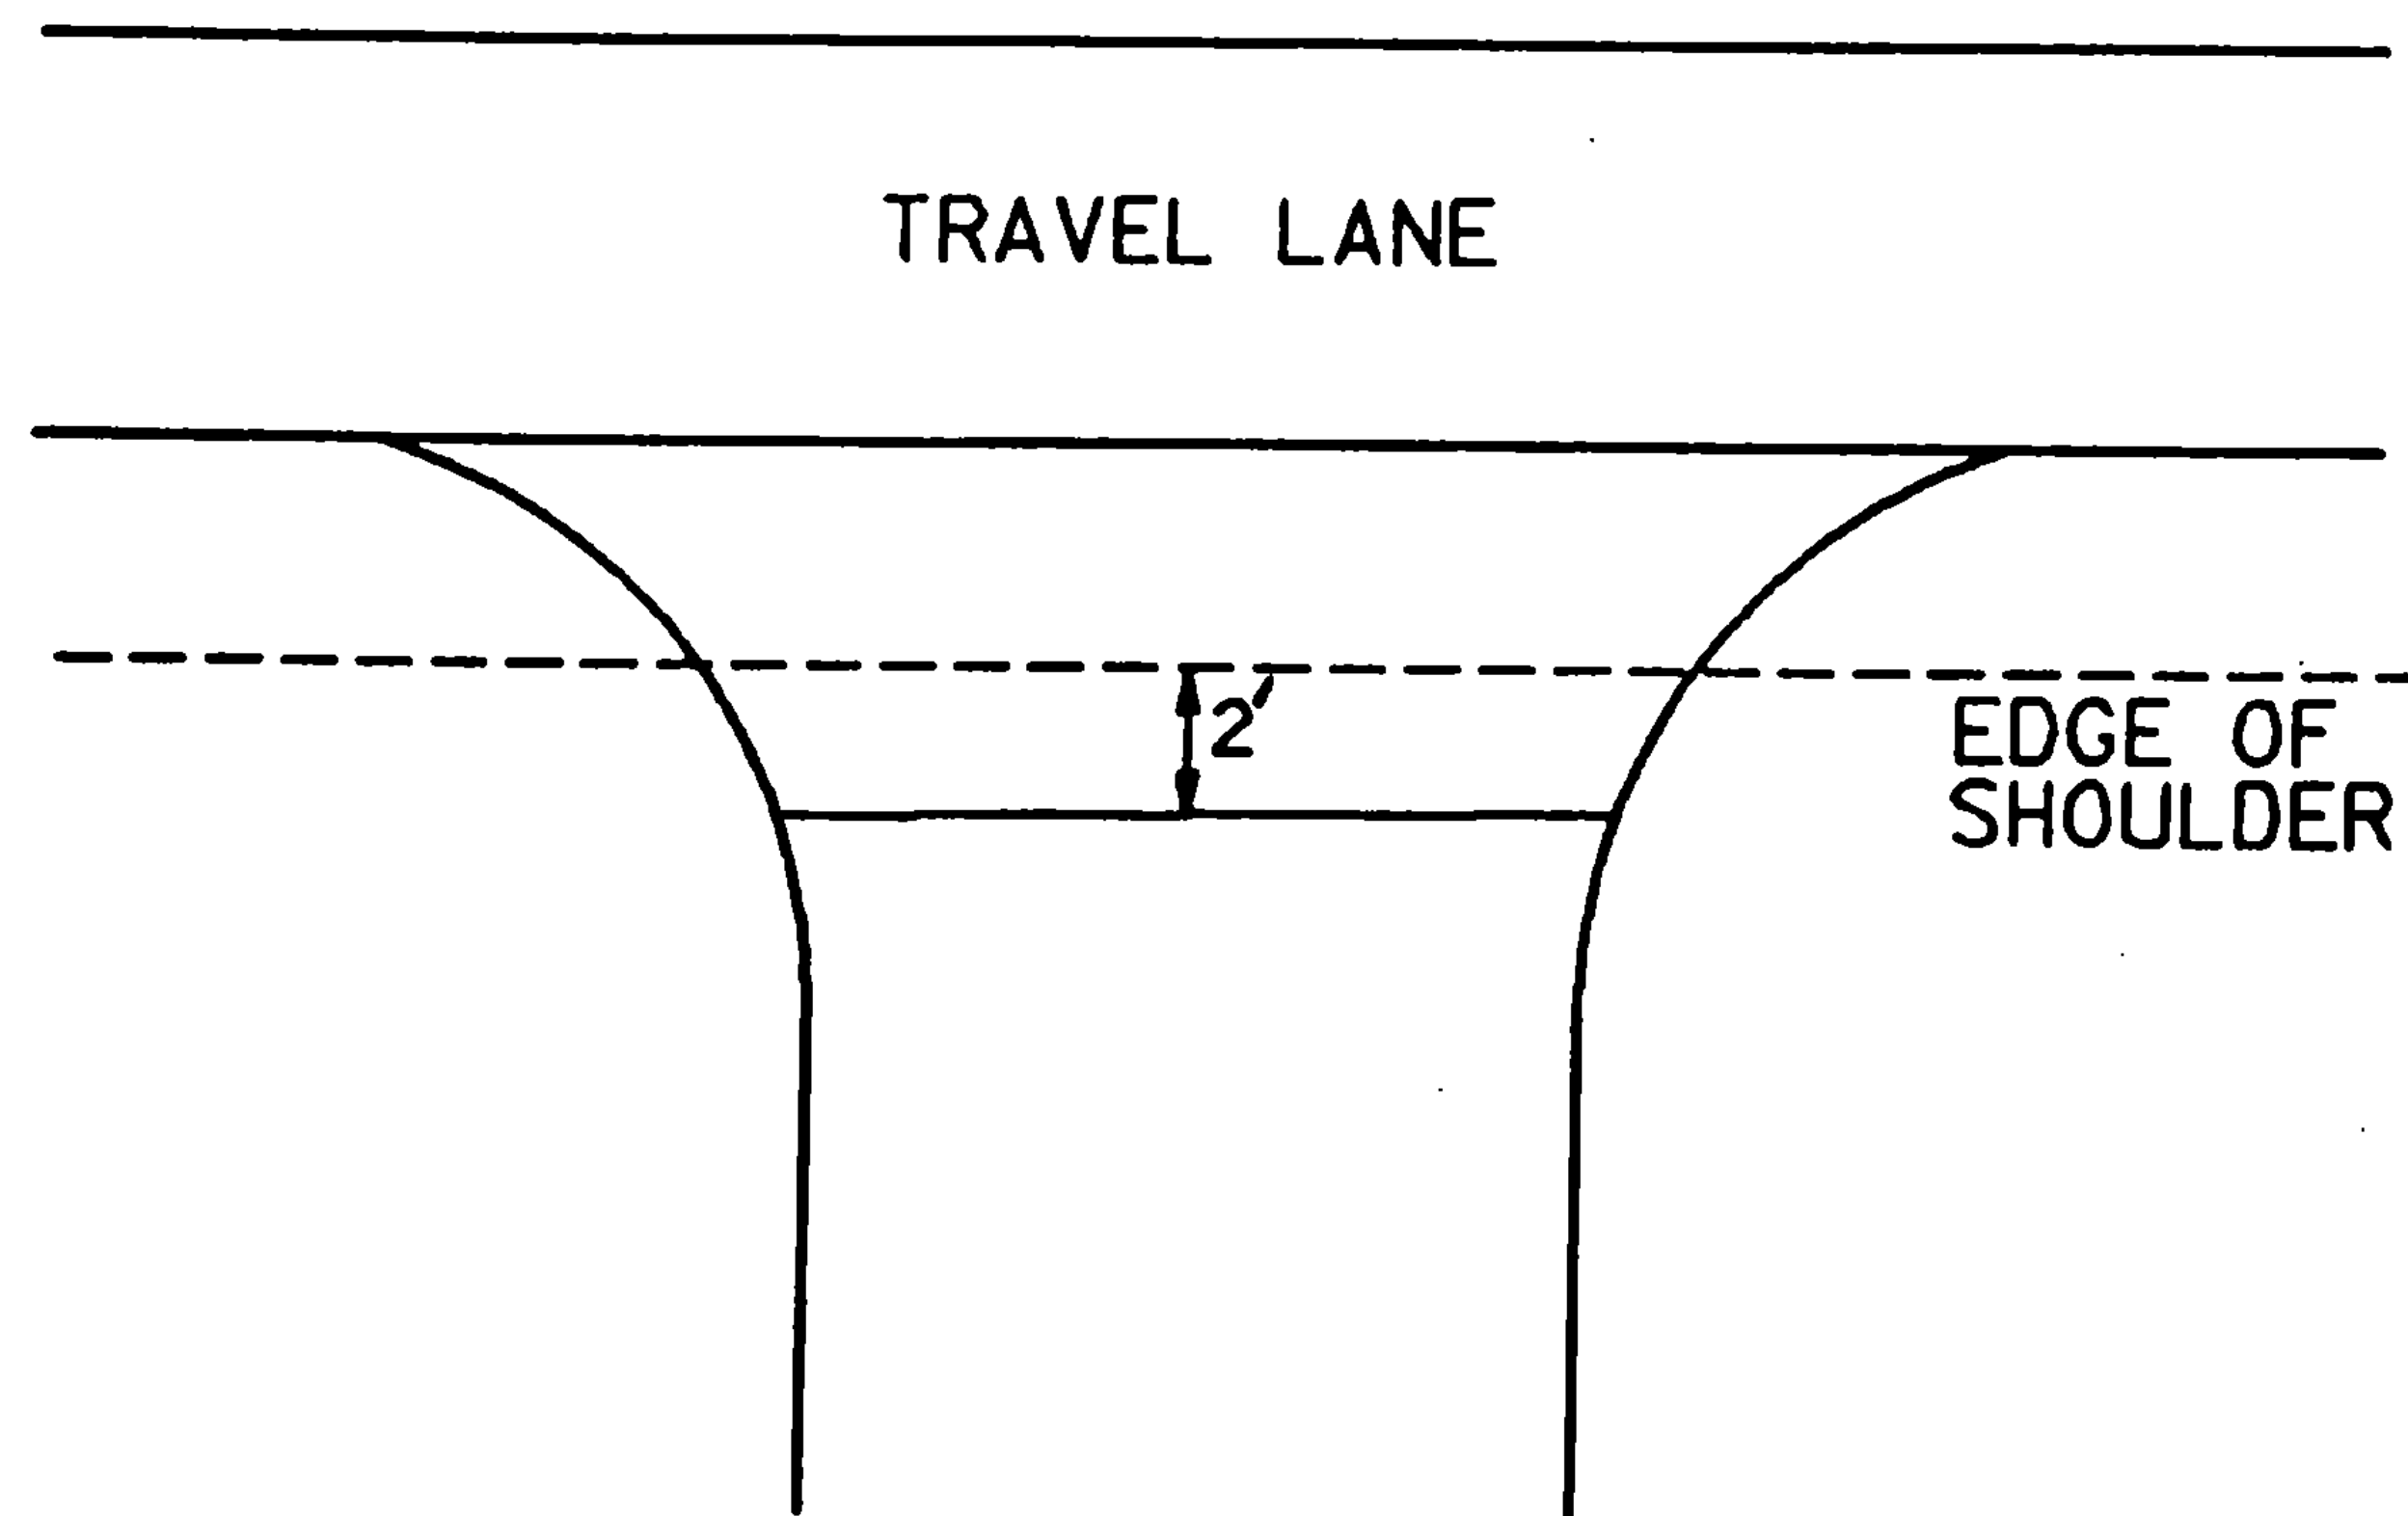

PROJECT Granville

NO. HMA 2860

SHEET 5 OF 10 SHEETS

SHEET 7 OF 38 SHEETS