
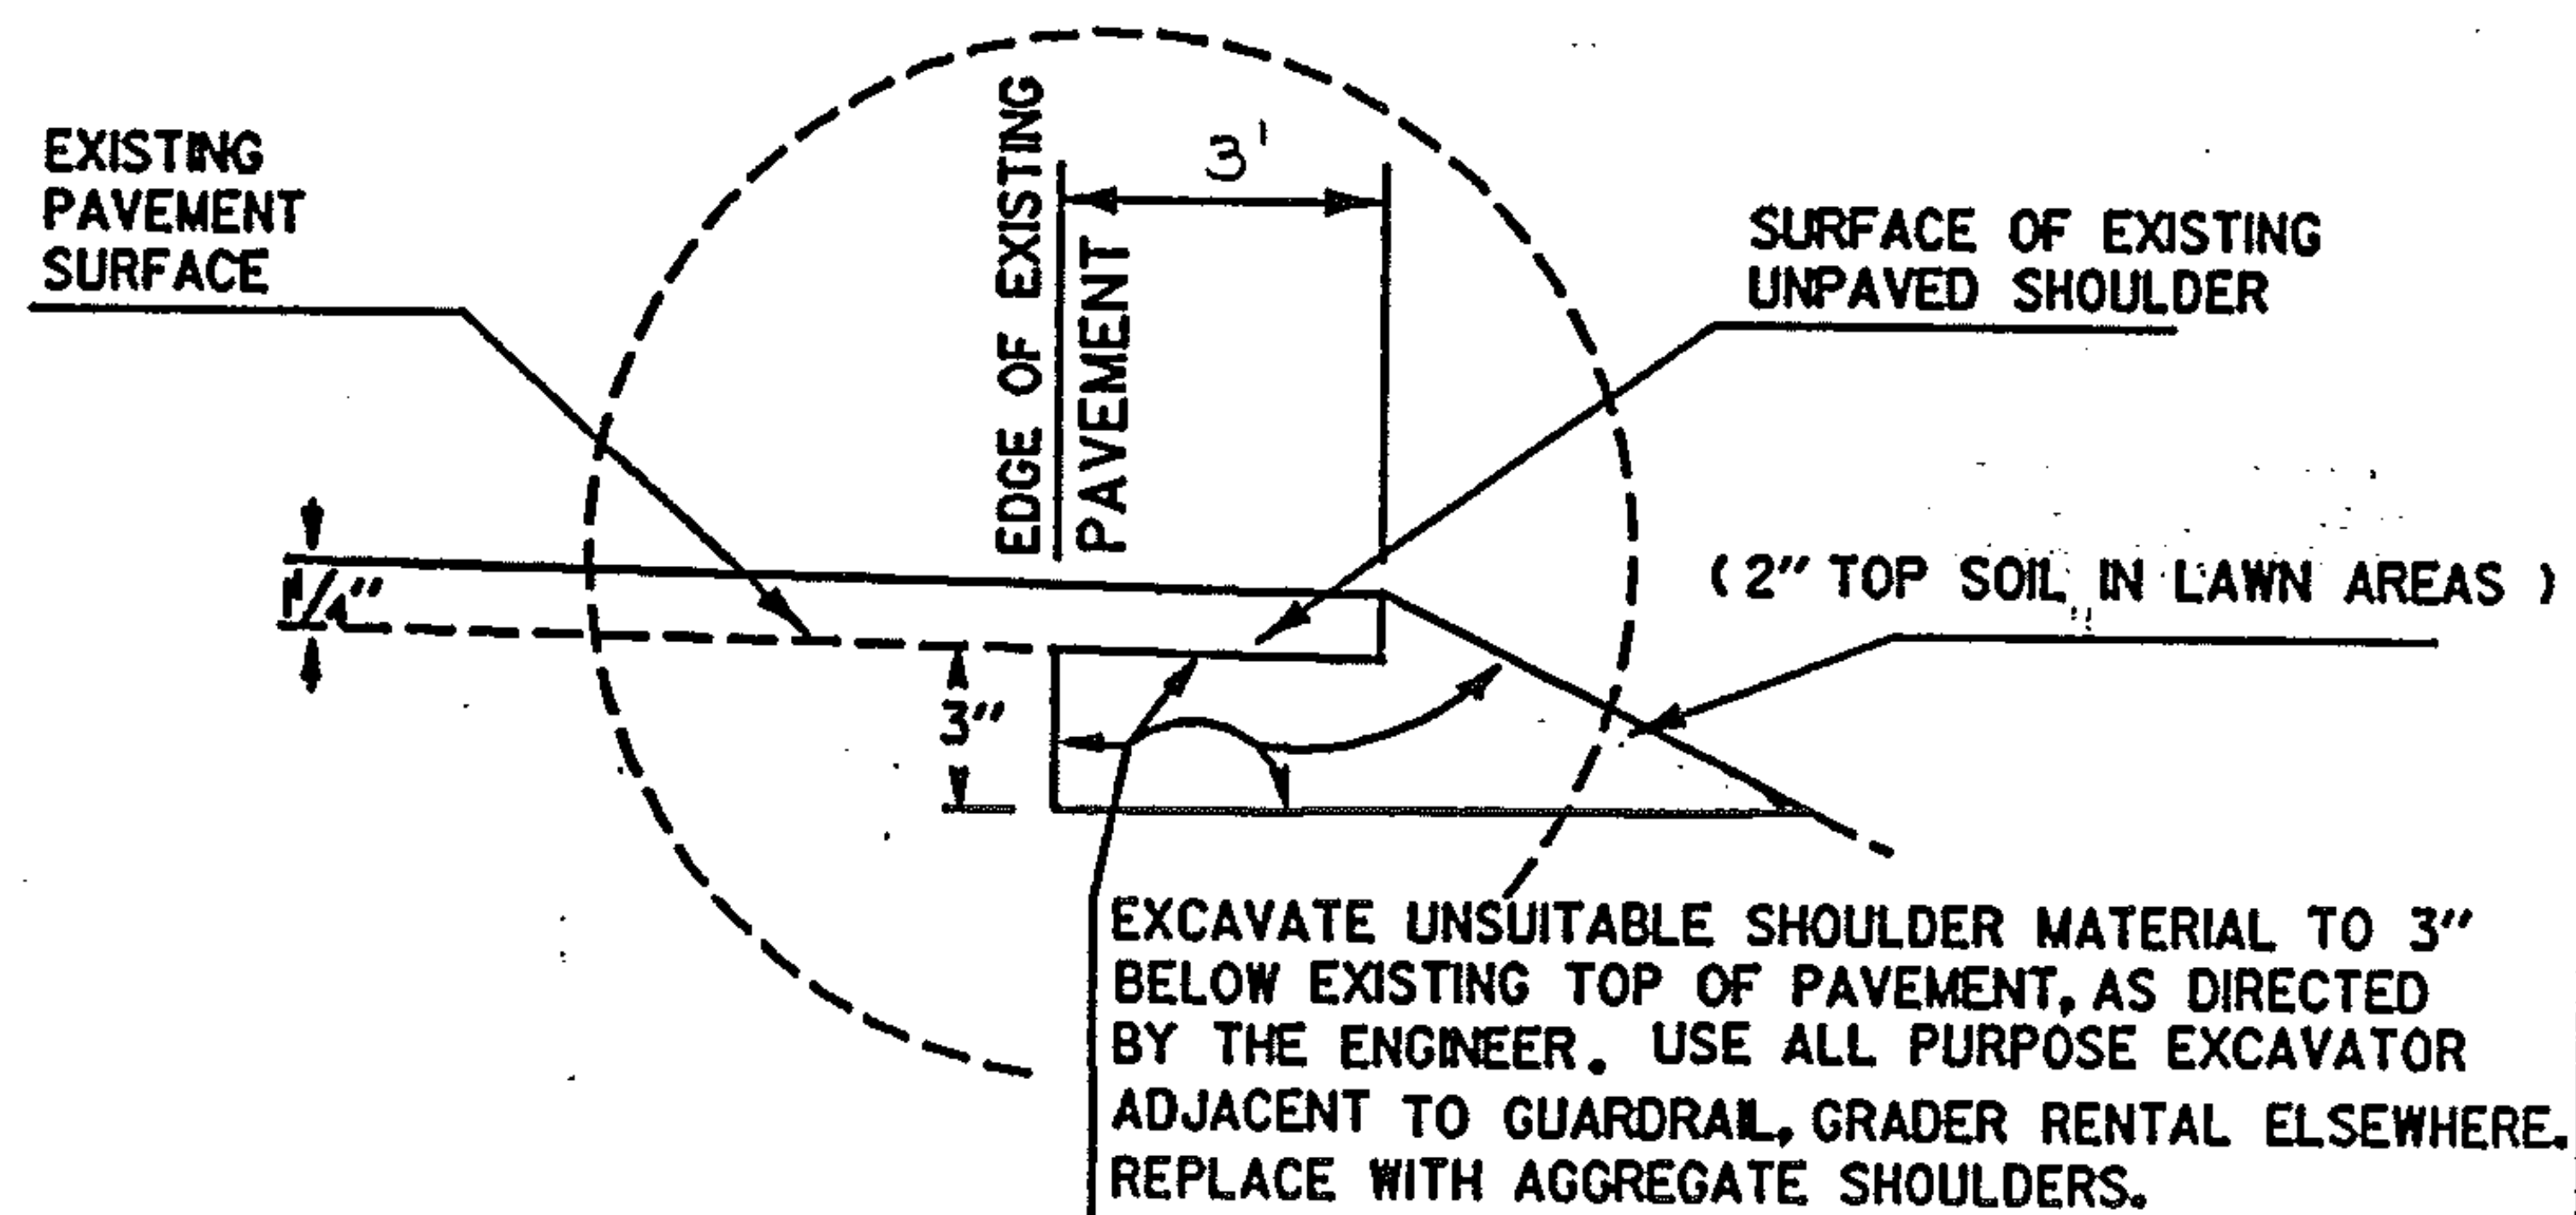


TYPICAL SECTIONS & DESIGN DATA

ITEM 406.25 BITUMINOUS CONCRETE PAVEMENT
 AGGREGATE SHOULDERS ($\pm 1/2"$)
 LEVELING COURSE TYPE IV (250 TONS/MILE)
 1 1/4" WEARING COURSE TYPE III ($\pm 1/4"$)
 AS DIRECTED BY THE ENGINEER

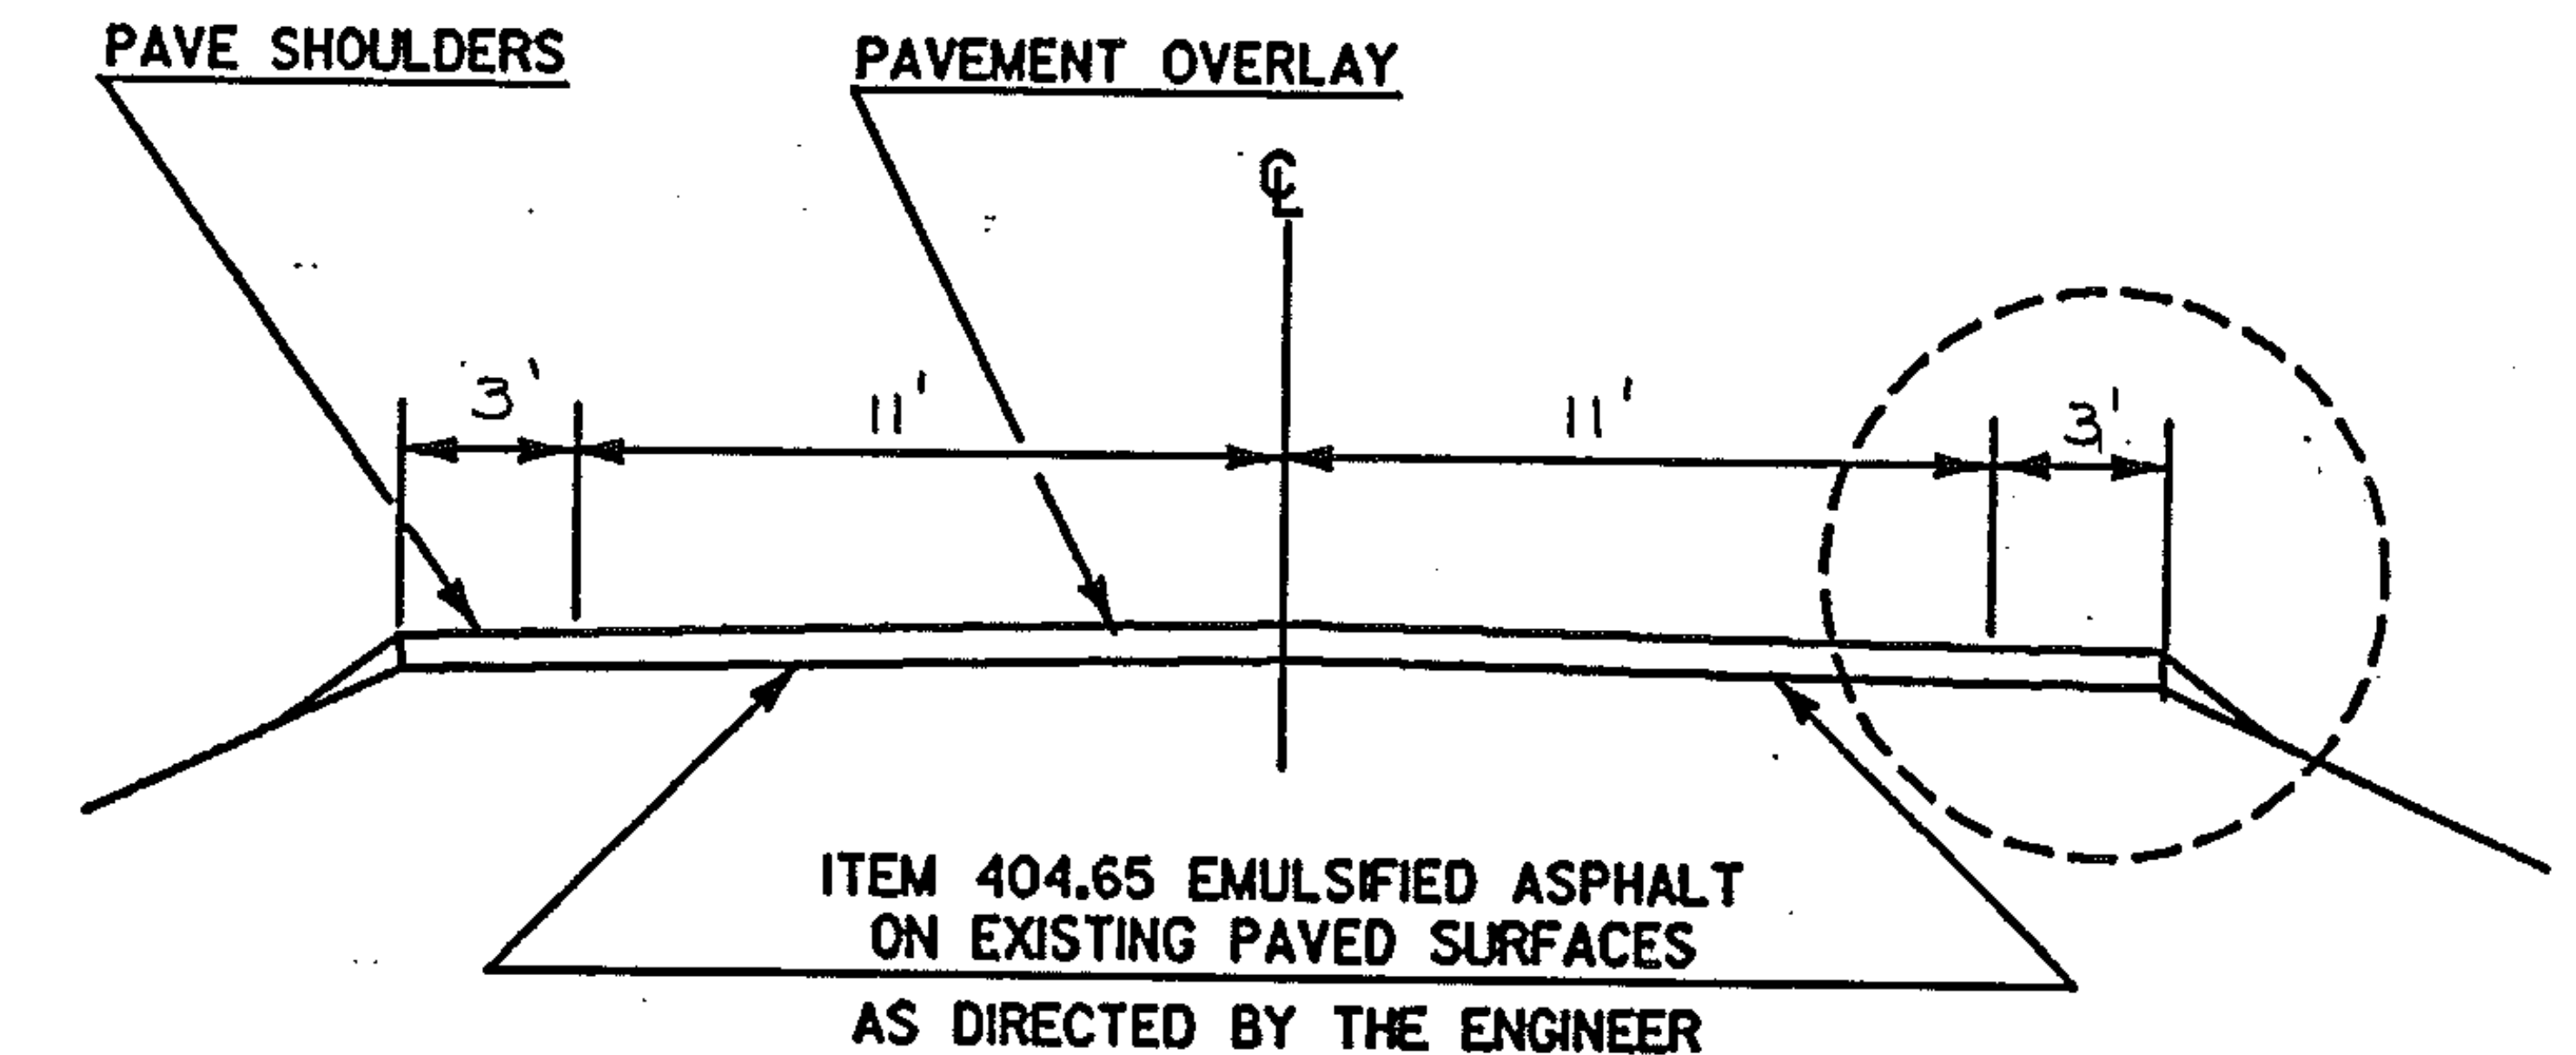

PROJECT MONTGOMERY

NO. HMA 2862

SHEET 9 OF 26 SHEETS