

STATE OF VERMONT  
 AGENCY OF TRANSPORTATION





PROPOSED IMPROVEMENT  
 RESURFACING PROJECT

TOWN OF MONTGOMERY

COUNTY OF FRANKLIN

ROUTE NO. VT 118

ROUTE CLASS F.A.S.

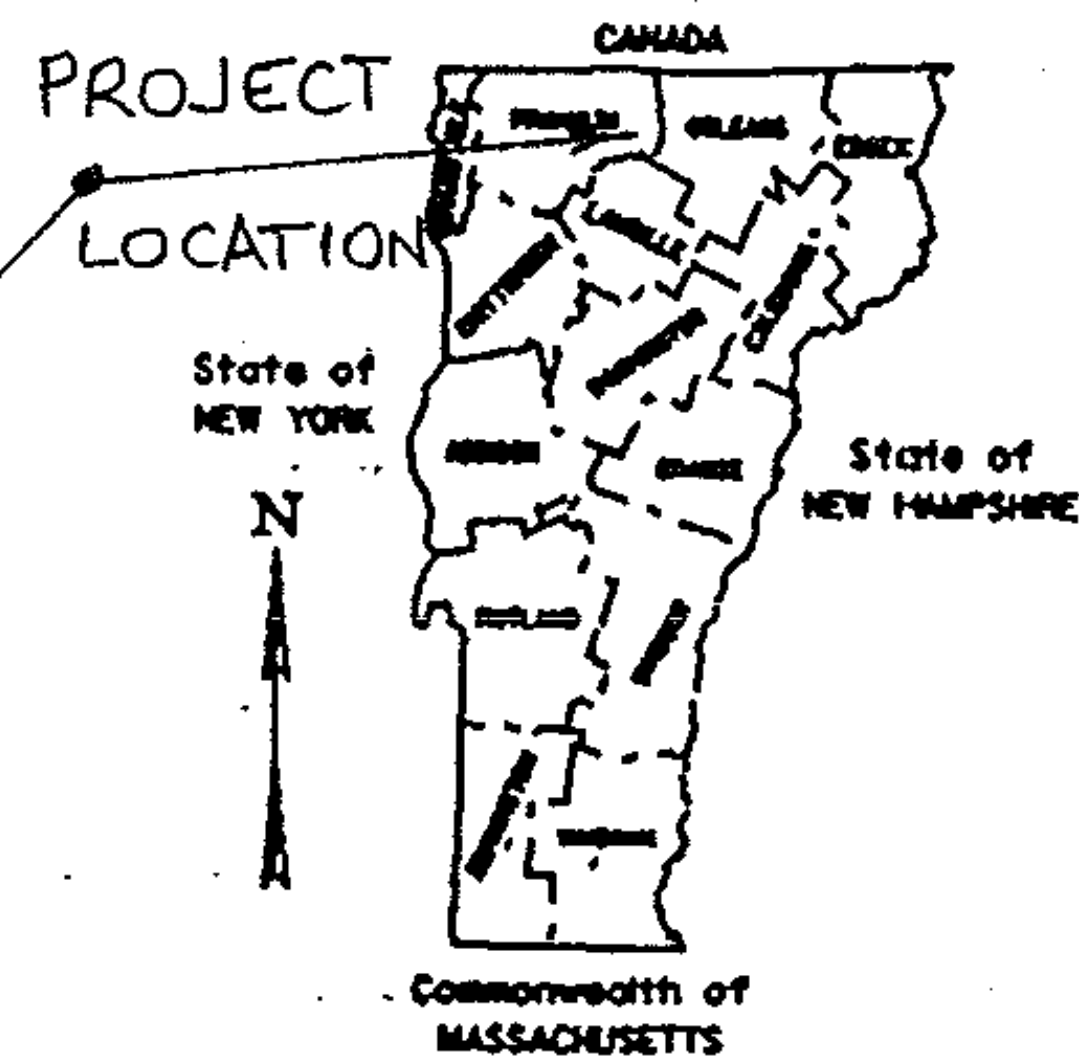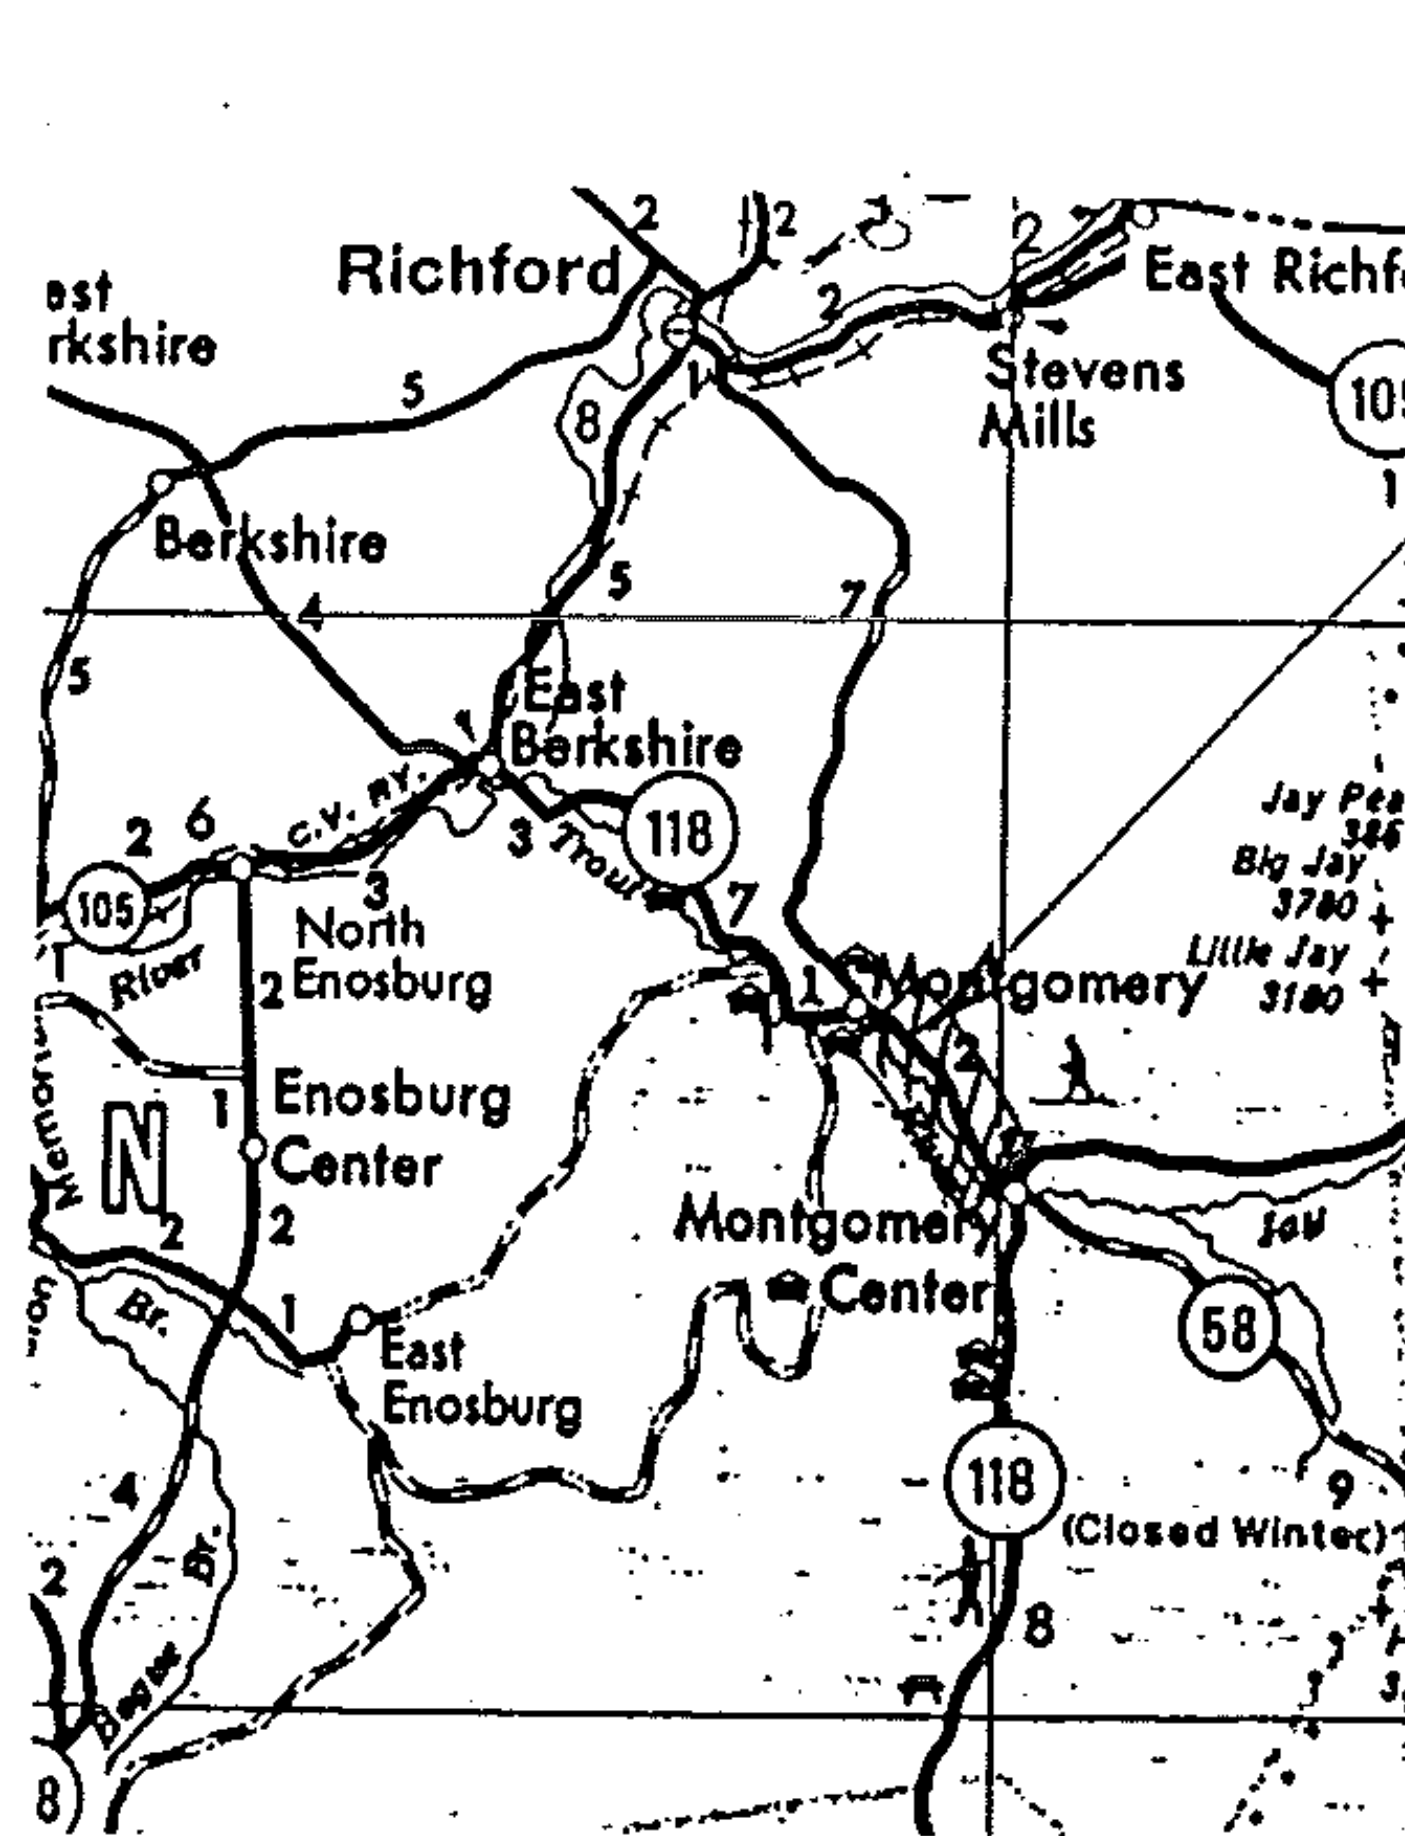

THESE PLANS ARE SUBJECT TO SUCH ENGINEERING CHANGES AS MAY BE REQUIRED BY THE FEDERAL HIGHWAY ADMINISTRATION OR THE CHIEF ENGINEER. CONSTRUCTION IS TO BE CARRIED ON IN ACCORDANCE WITH THESE PLANS AND THE STANDARD SPECIFICATIONS FOR CONSTRUCTION DATED 1966, AS APPROVED BY THE FEDERAL HIGHWAY ADMINISTRATION ON NOVEMBER 2, 1965 FOR USE ON THIS PROJECT, INCLUDING ALL SUBSEQUENT REVISIONS AND SUCH REVISED SPECIFICATIONS AND SPECIAL PROVISIONS AS ARE INCORPORATED IN THESE PLANS.

SUBMITTED BY ORDER OF THE STATE TRANSPORTATION BOARD  
 APPROVED David B. Kelley DATE 8/4/87  
 CHIEF ENGINEER  
 DEPARTMENT OF TRANSPORTATION  
 FEDERAL HIGHWAY ADMINISTRATION  
 APPROVED \_\_\_\_\_ DATE \_\_\_\_\_  
 DIVISION ADMINISTRATOR

PROJECT NO. \_\_\_\_\_  
 SHEET 7 OF 26 SHEETS