



PAVING LIMITS FOR TOWN ROADS & DRIVES

PAVING LIMITS FOR TOWN ROADS

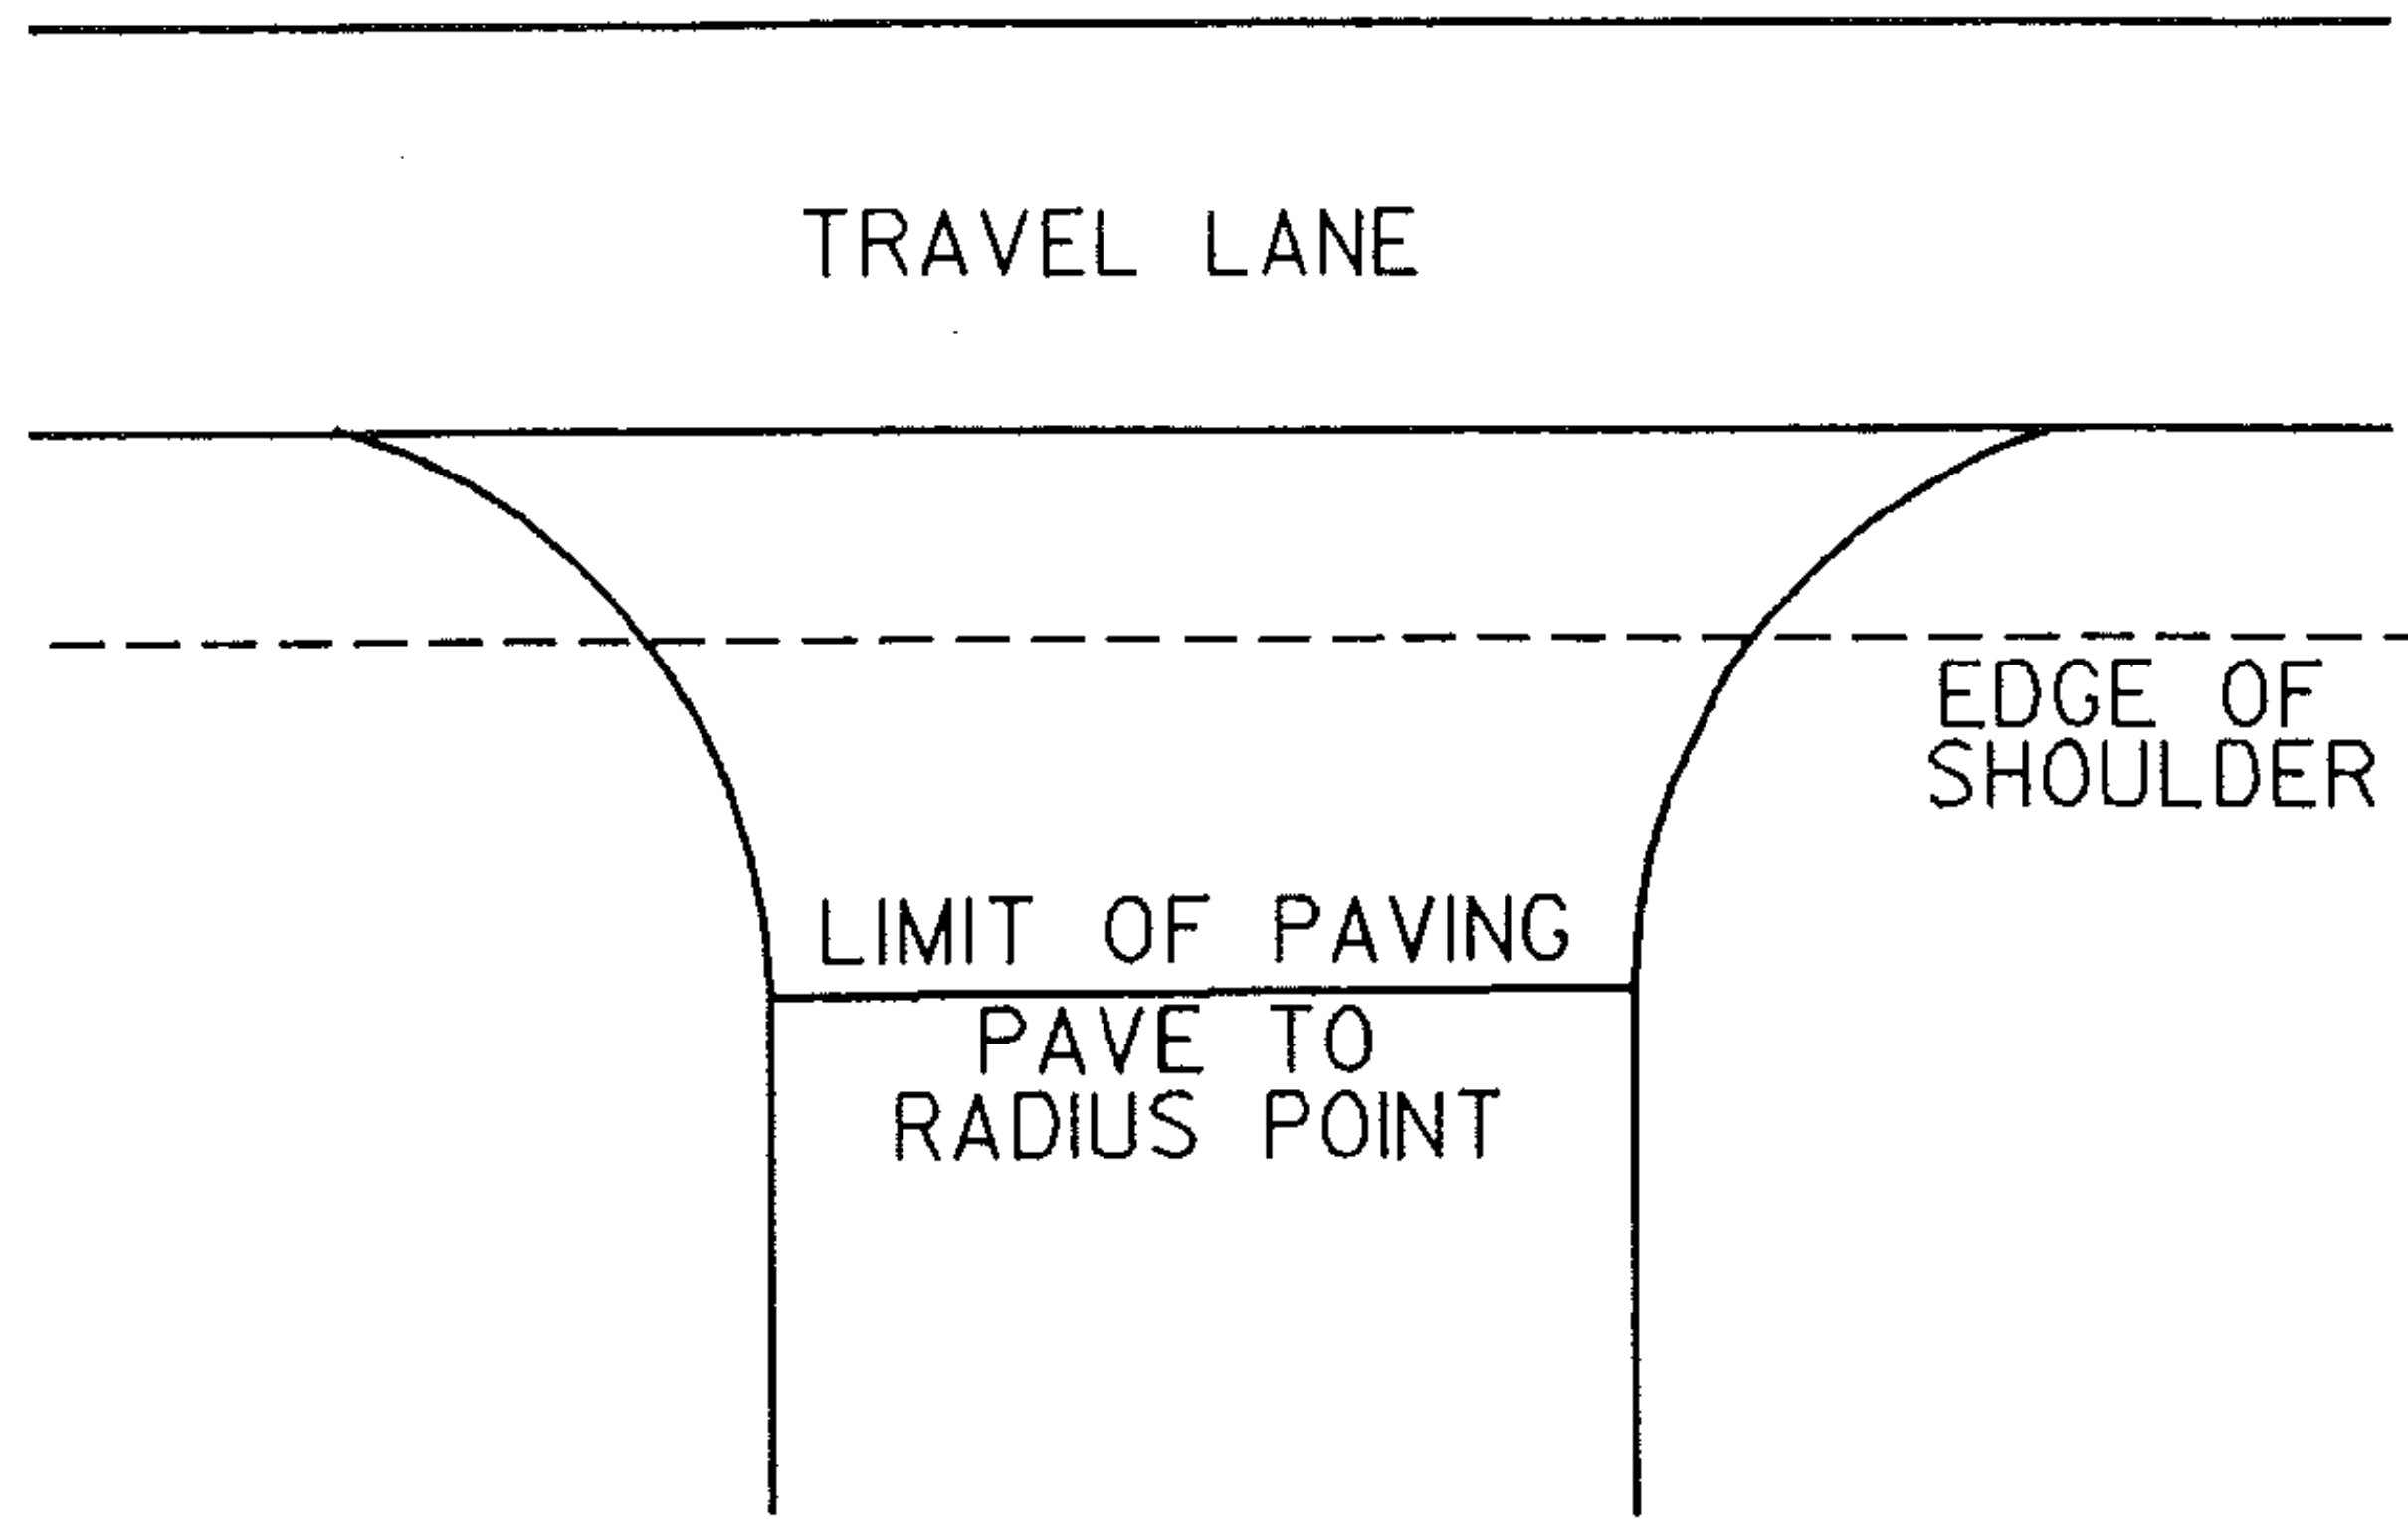

PAVING LIMITS FOR DRIVES

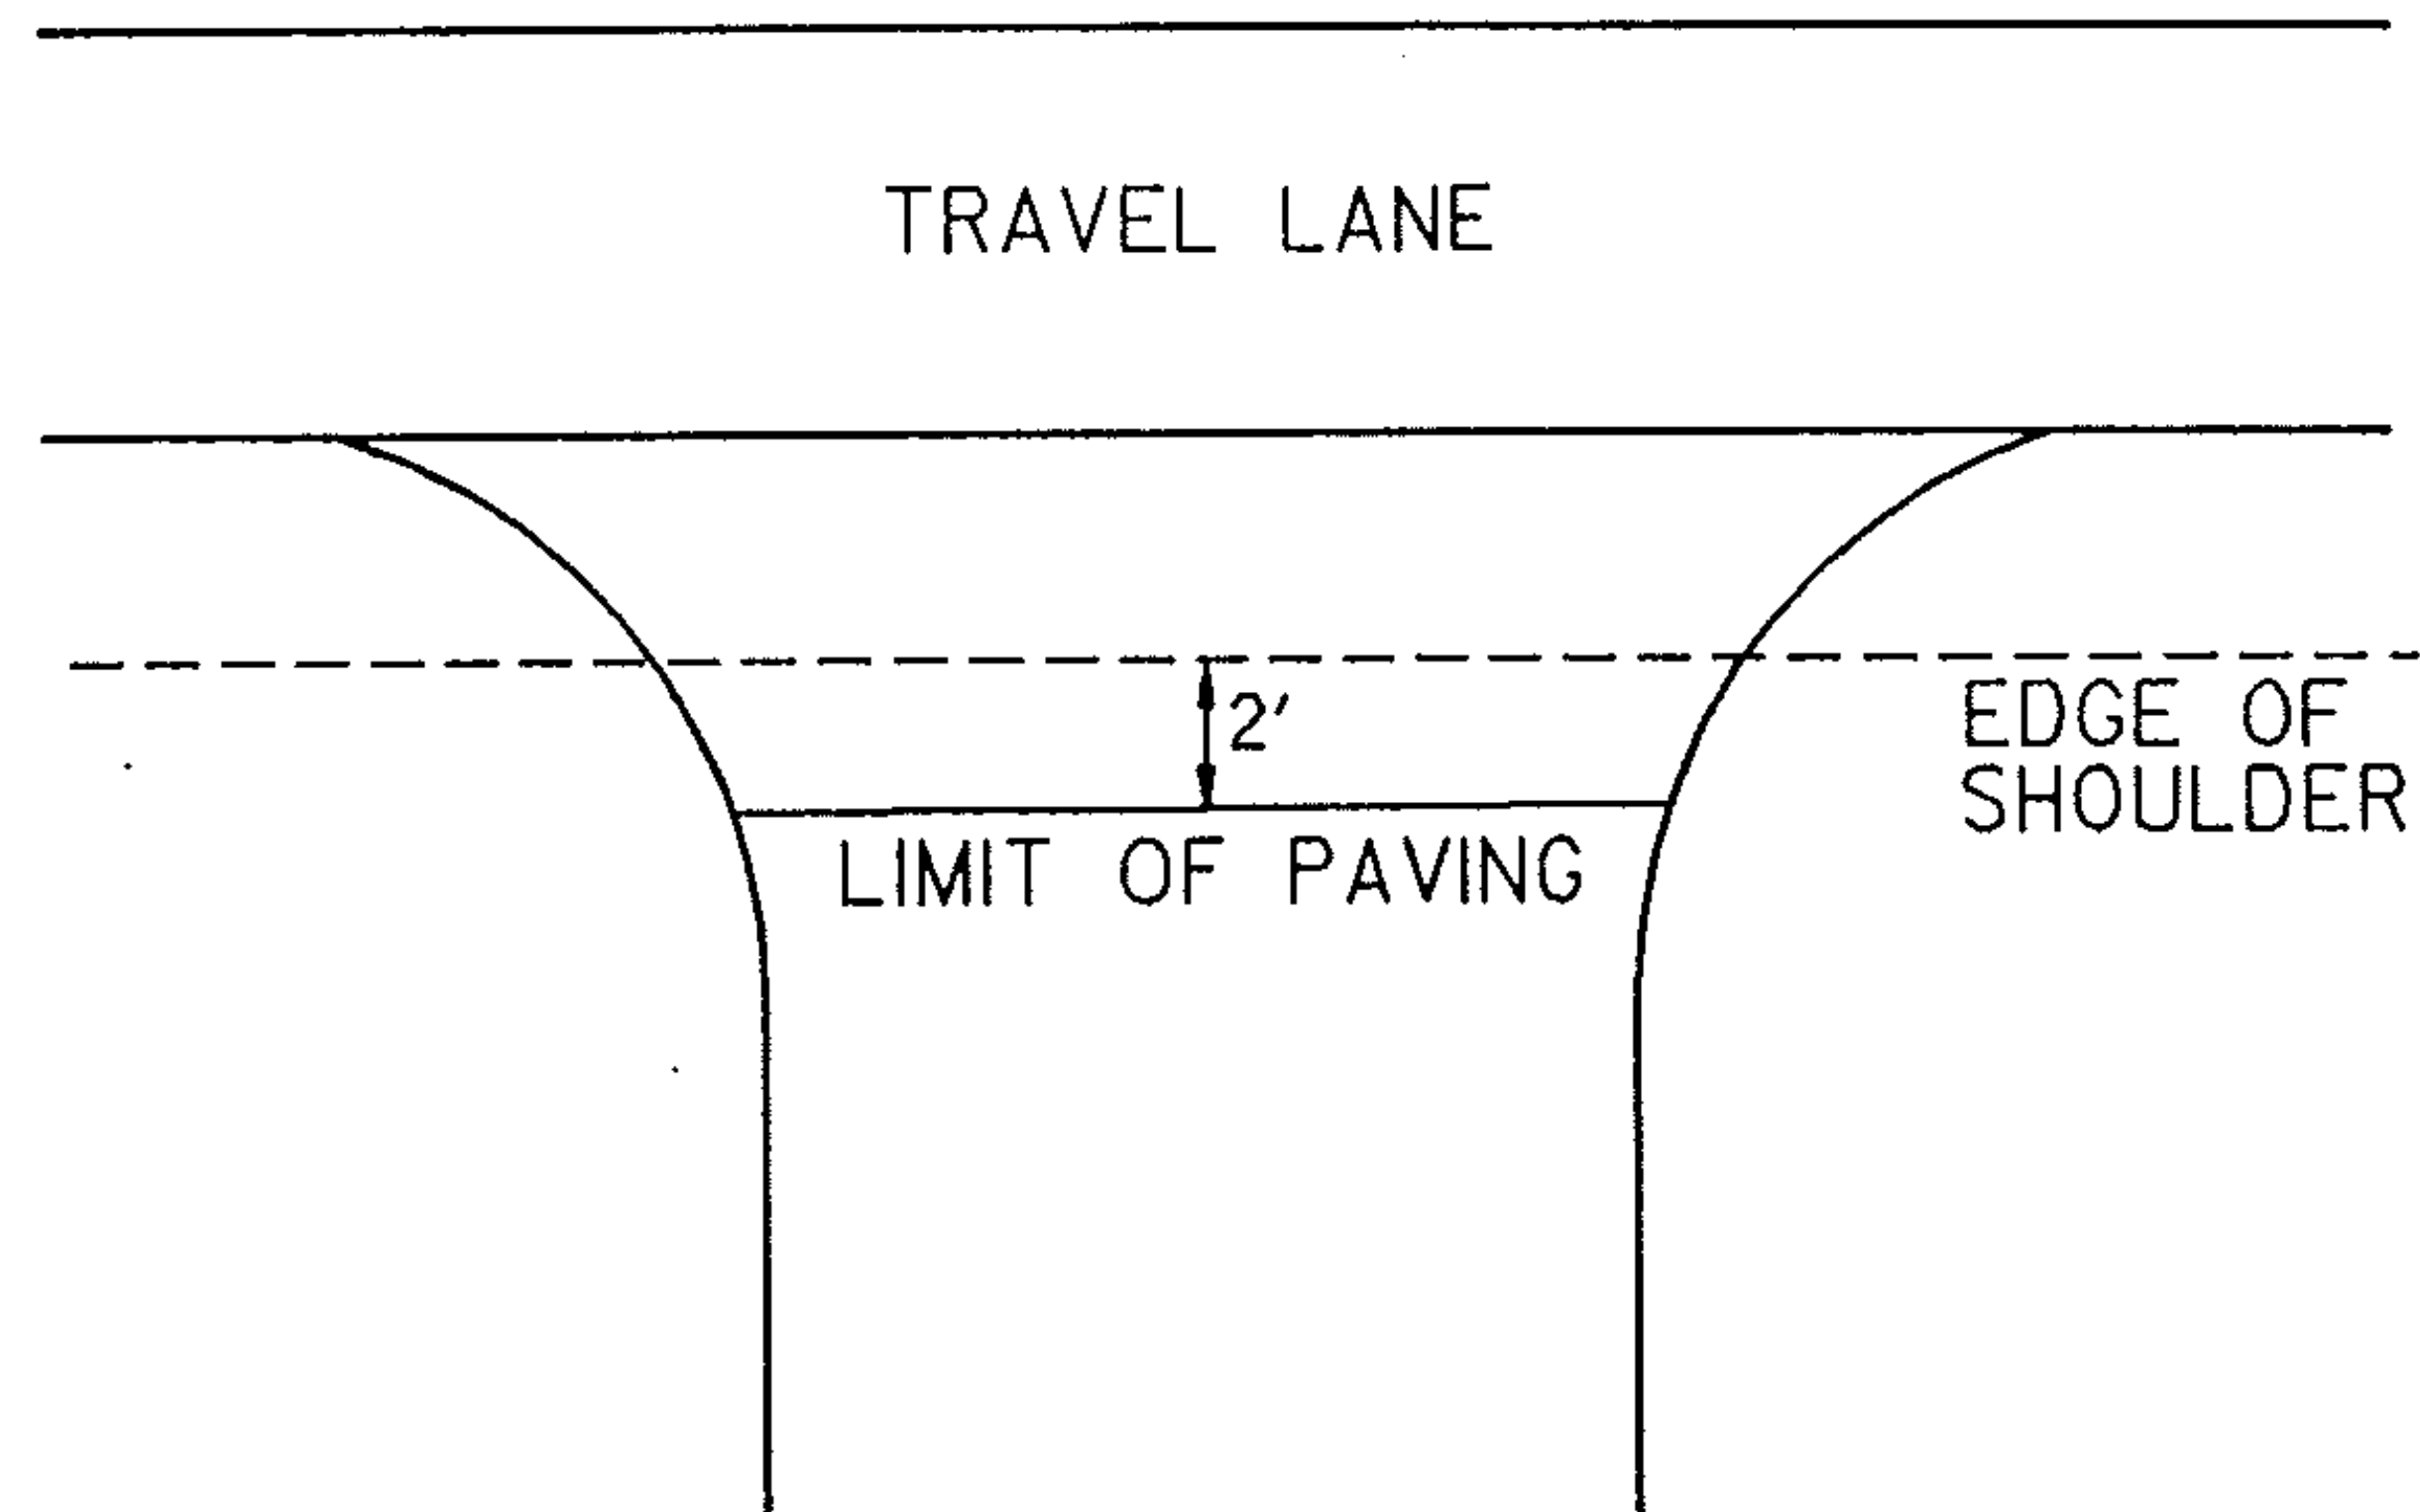

PROJECT LYNDON-SHEFFIELD

NO. HMA 2834

SHEET 8 OF 30 SHEETS