


# DESCRIPTION AND LOCATION

PROJECT LENGTH: 7.000 MILES, 36,960.00 FEET

1986 A.D.T.: 980

BEGINNING IN THE TOWN OF HARDWICK ON VT. 16 AT M.M. 1.686 AND EXTENDING NORTHERLY 7.000 MILES TO M.M. 4.270 IN THE TOWN OF GREENSBORO.

RESURFACING OF THE HIGHWAY AND ITS APPROACHES, AND NEW PAVEMENT MARKINGS.

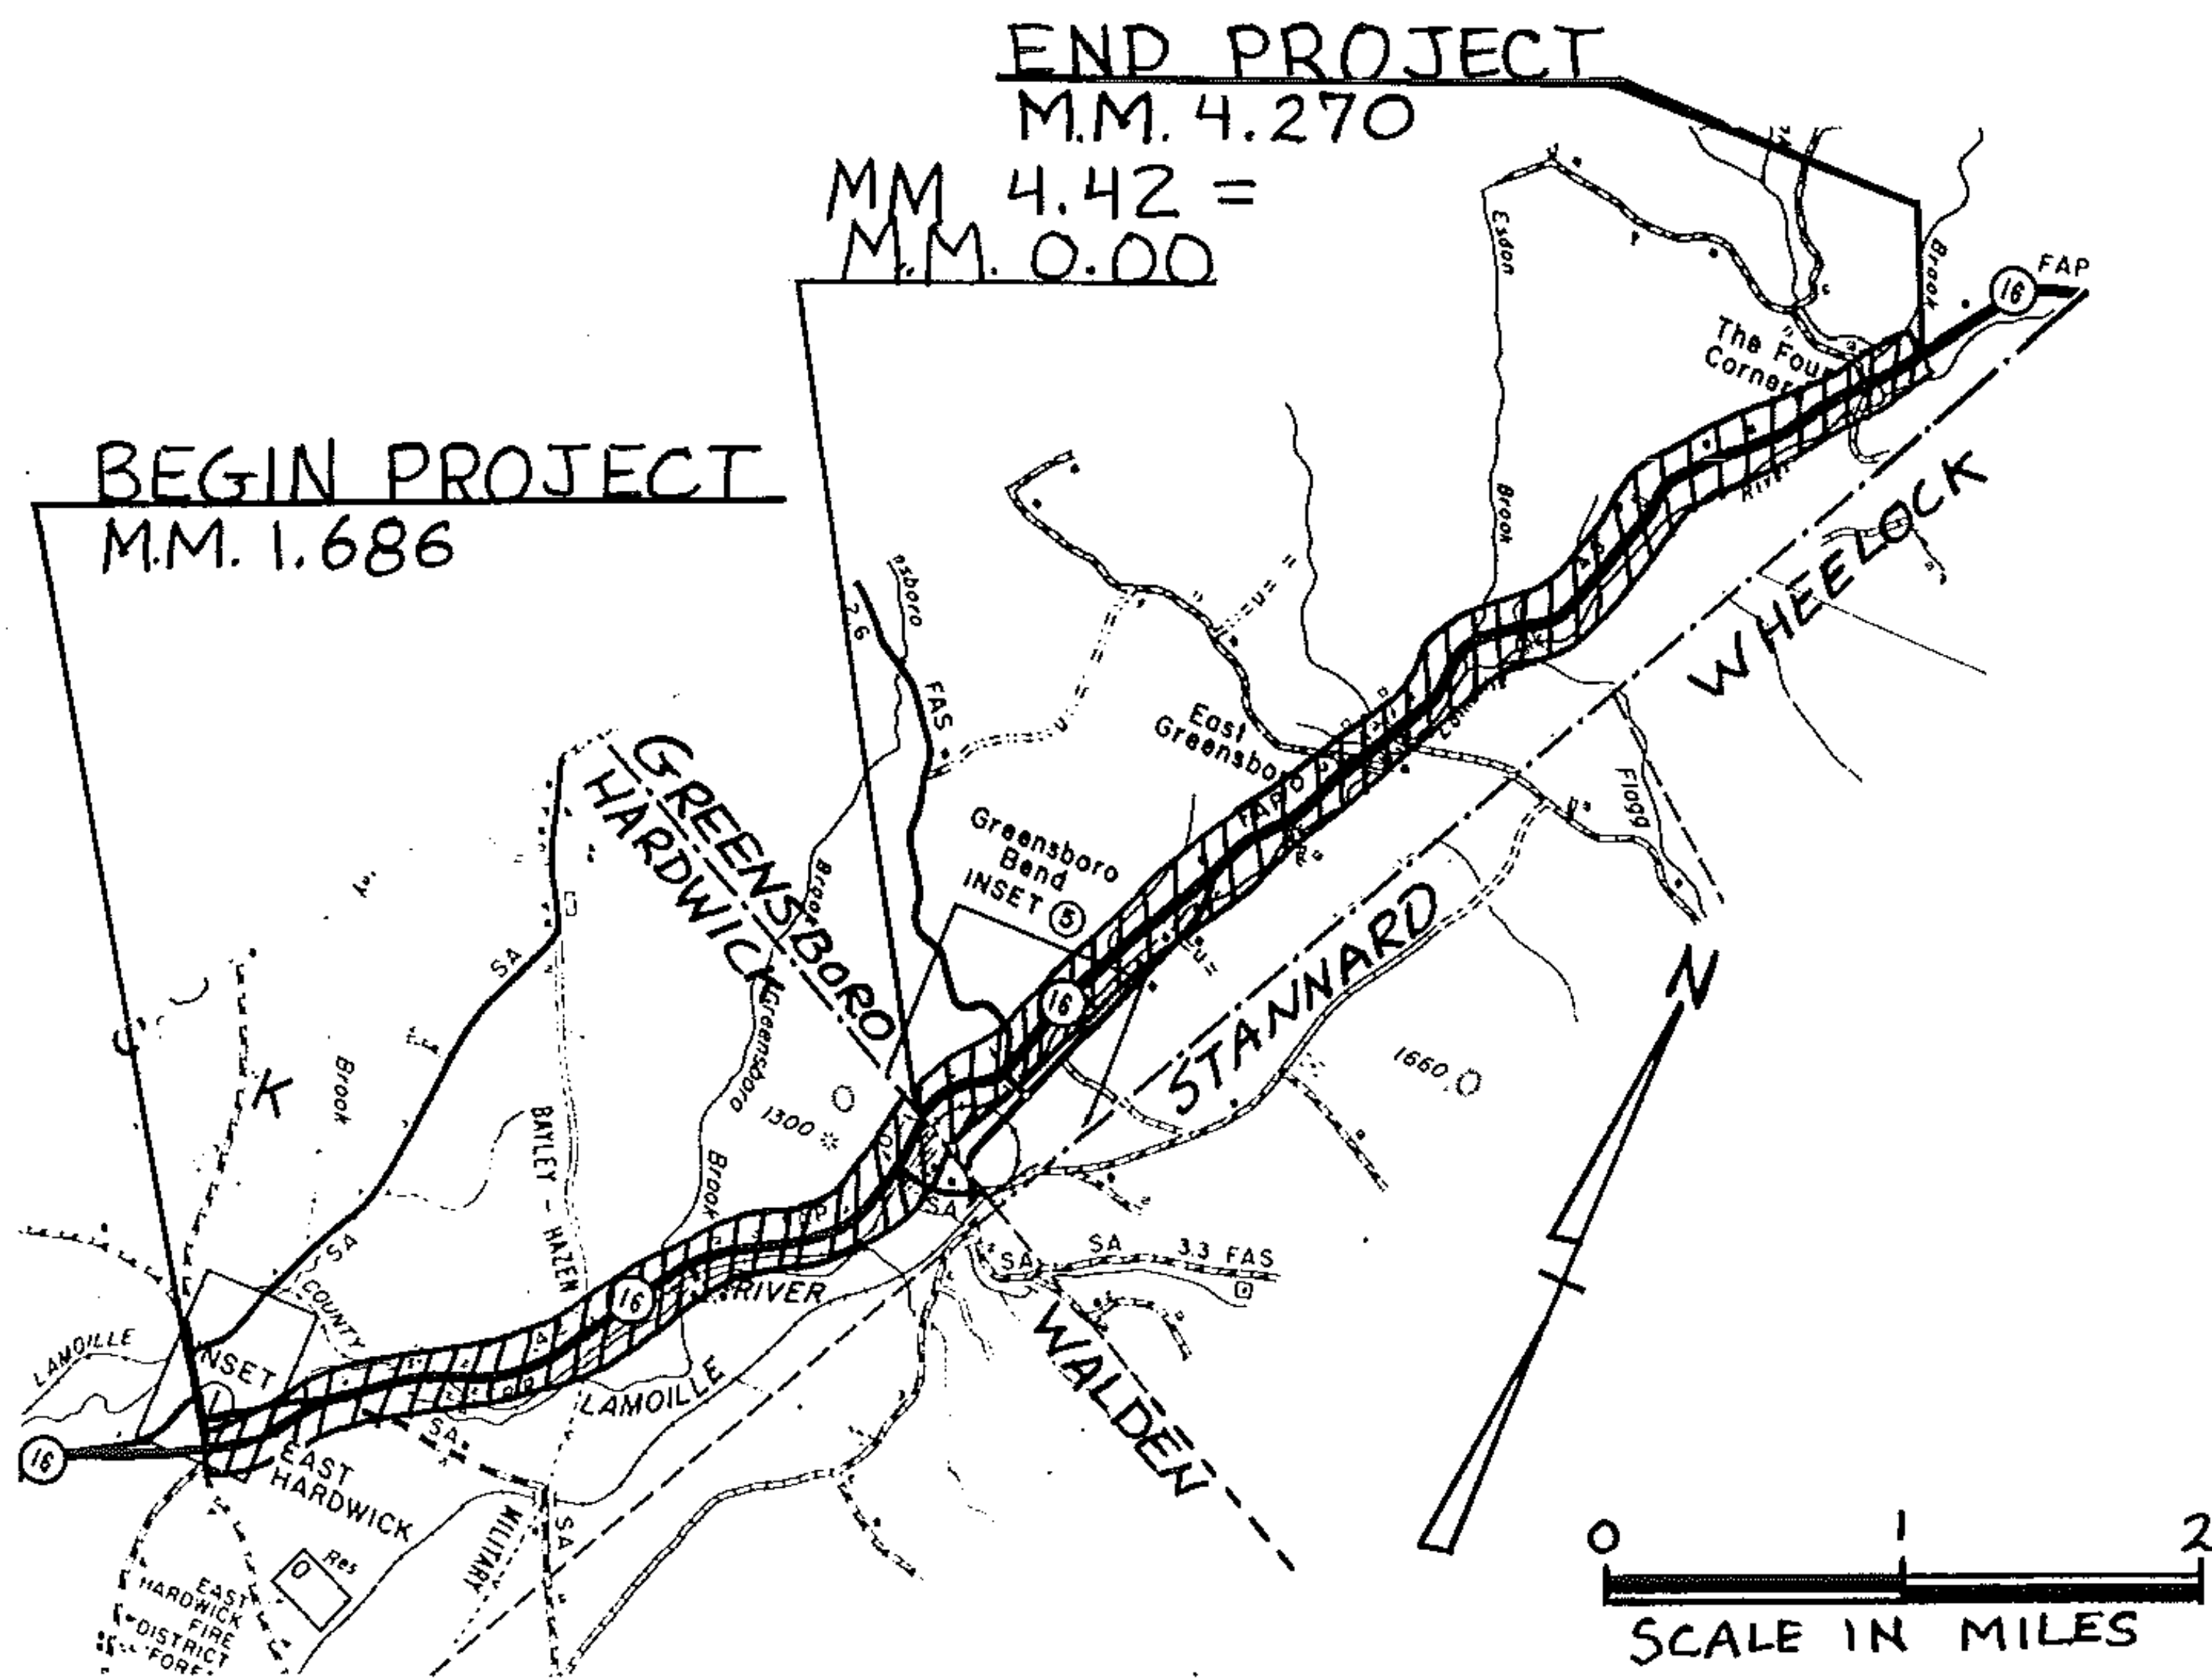

PROJECT HARDWICK-GREENSBORO

NO. HMA 2867

SHEET 15 OF 30 SHEETS