



PAVING LIMITS FOR TOWN ROADS & DRIVES

PAVING LIMITS FOR TOWN ROADS

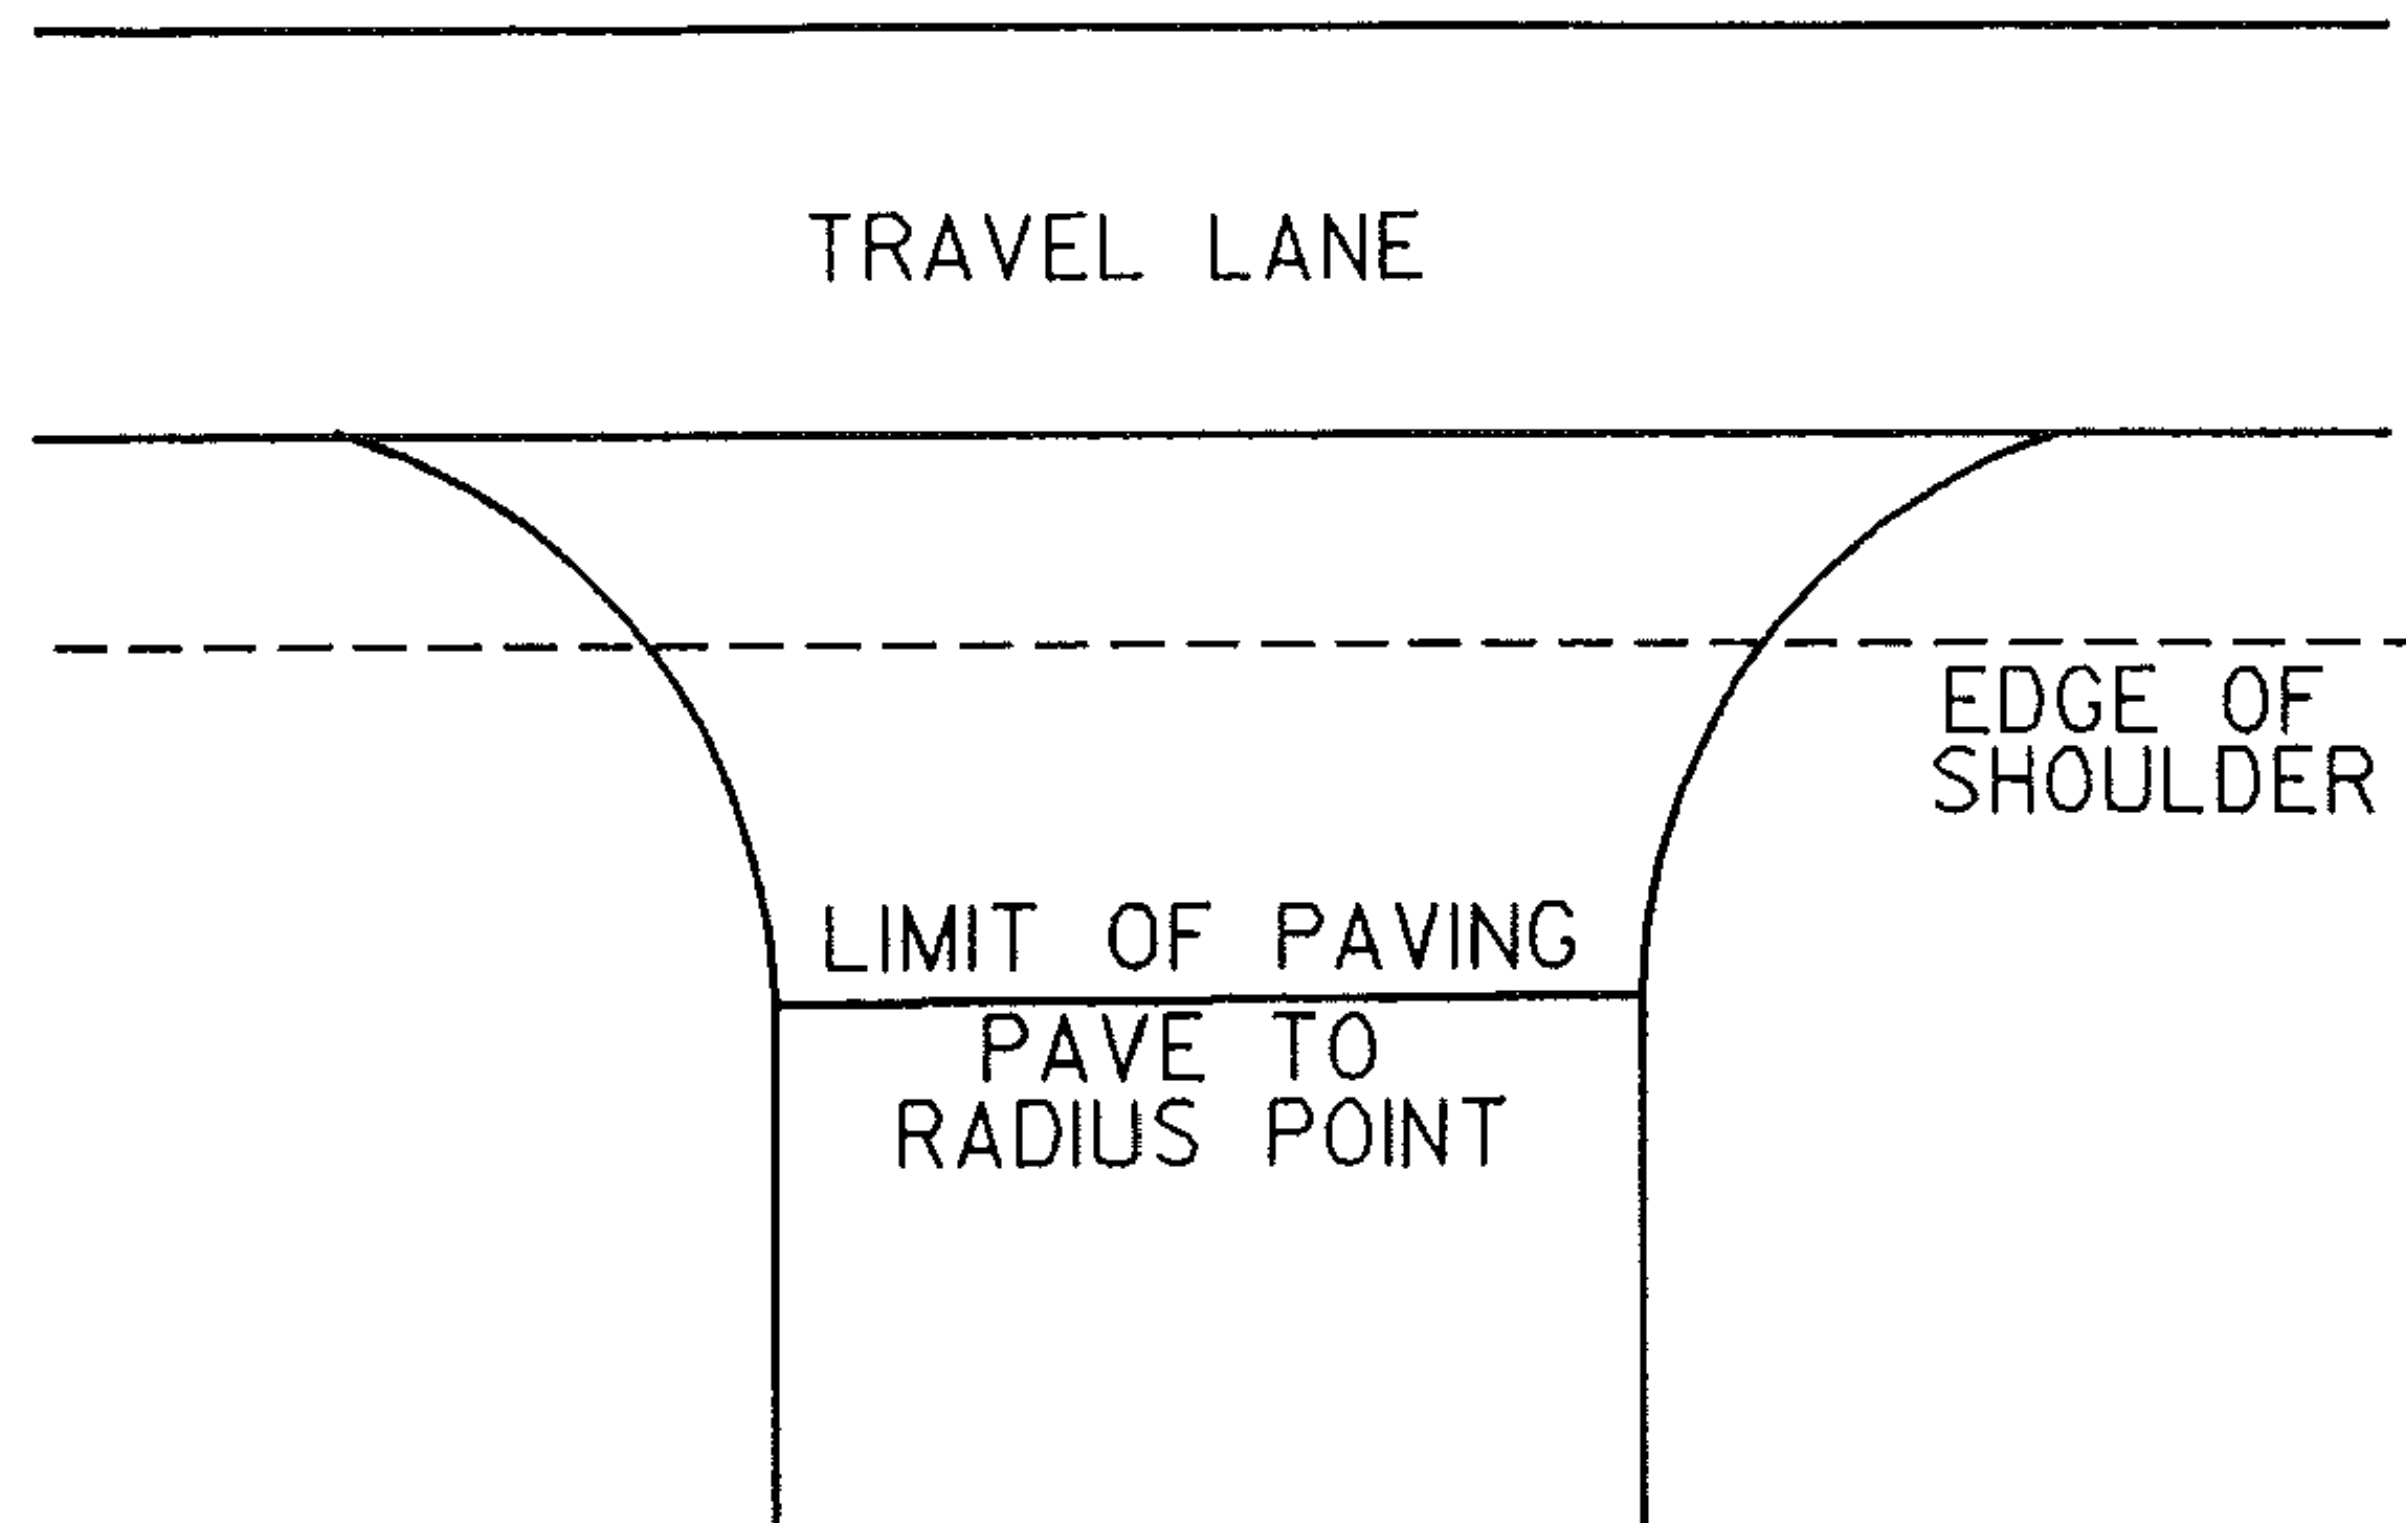

PAVING LIMITS FOR DRIVES

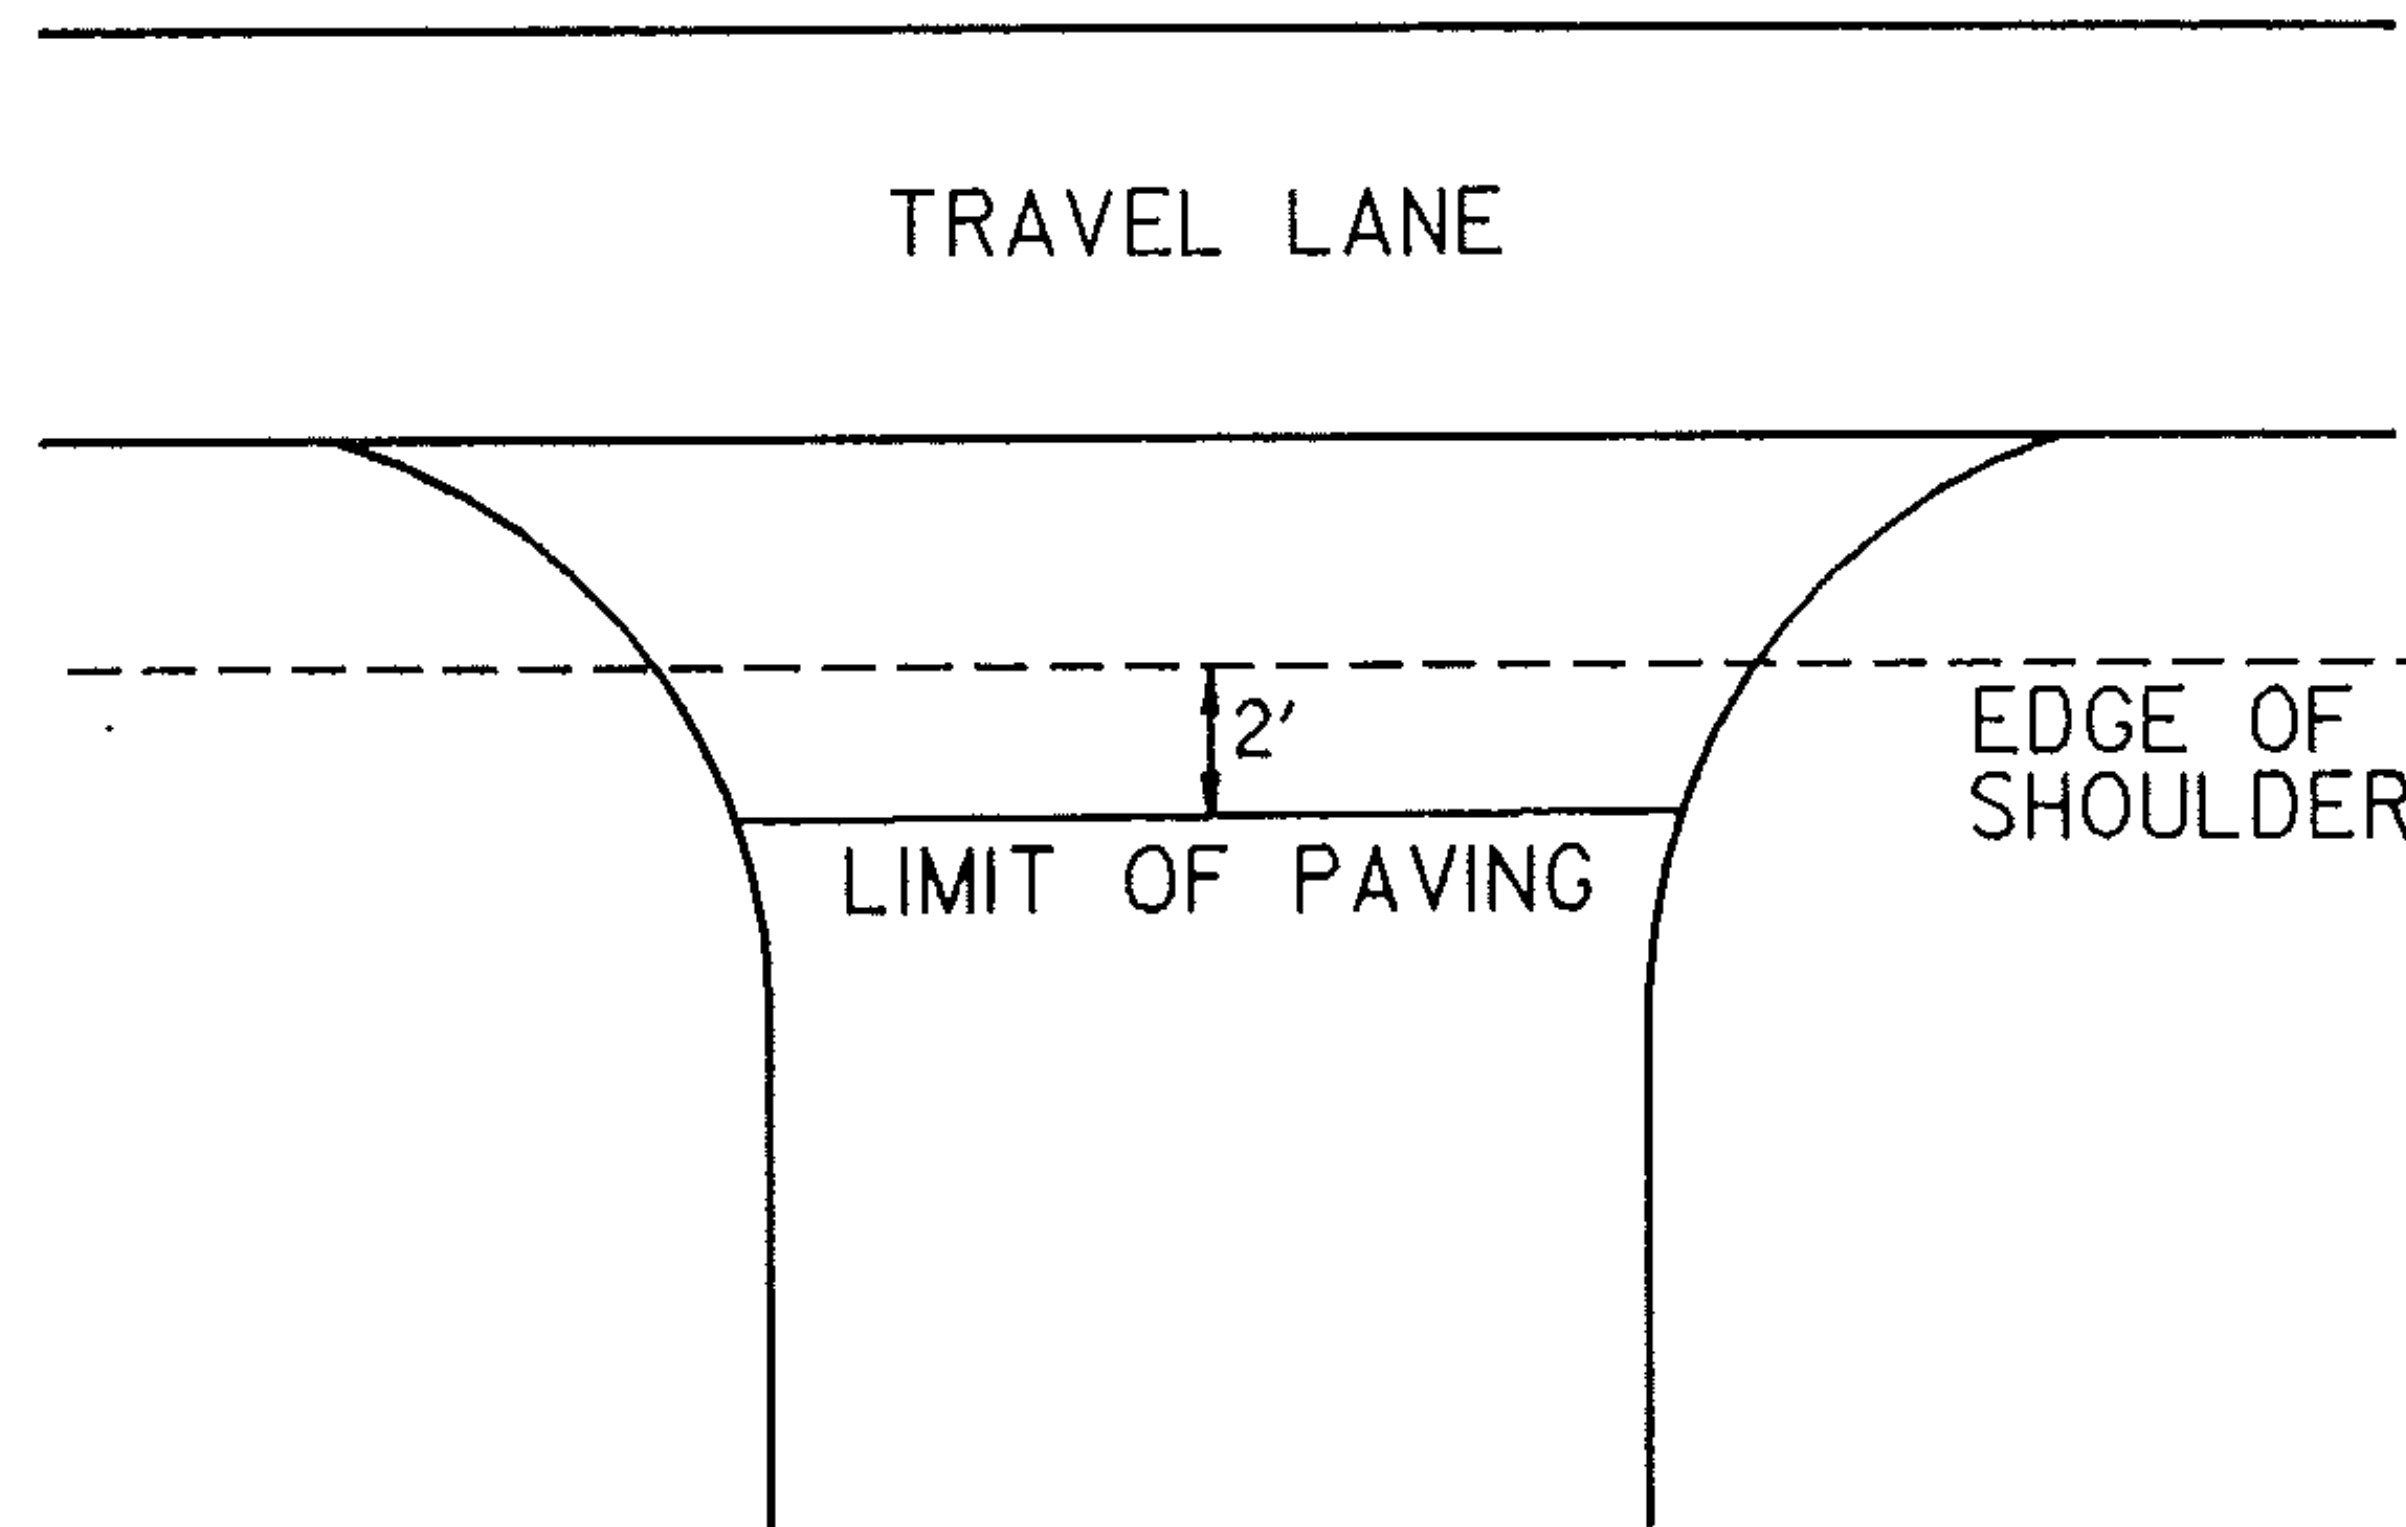

PROJECT HARDWICK-GREENSBORO

NO. HMA 2867

SHEET 17 OF 30 SHEETS