


DESCRIPTION AND LOCATION

PROJECT LENGTH: 2.100 MILES, 11,088. FEET
1986 A.D.T.: 2660

BEGINNING IN THE TOWN OF STOWE ON VT. 108 AT M.M. 5.537 AND EXTENDING NORTHERLY 2.100 MILES TO M.M. 7.637. RESURFACING OF THE HIGHWAY AND ITS APPROACHES, NEW PAVEMENT MARKINGS.

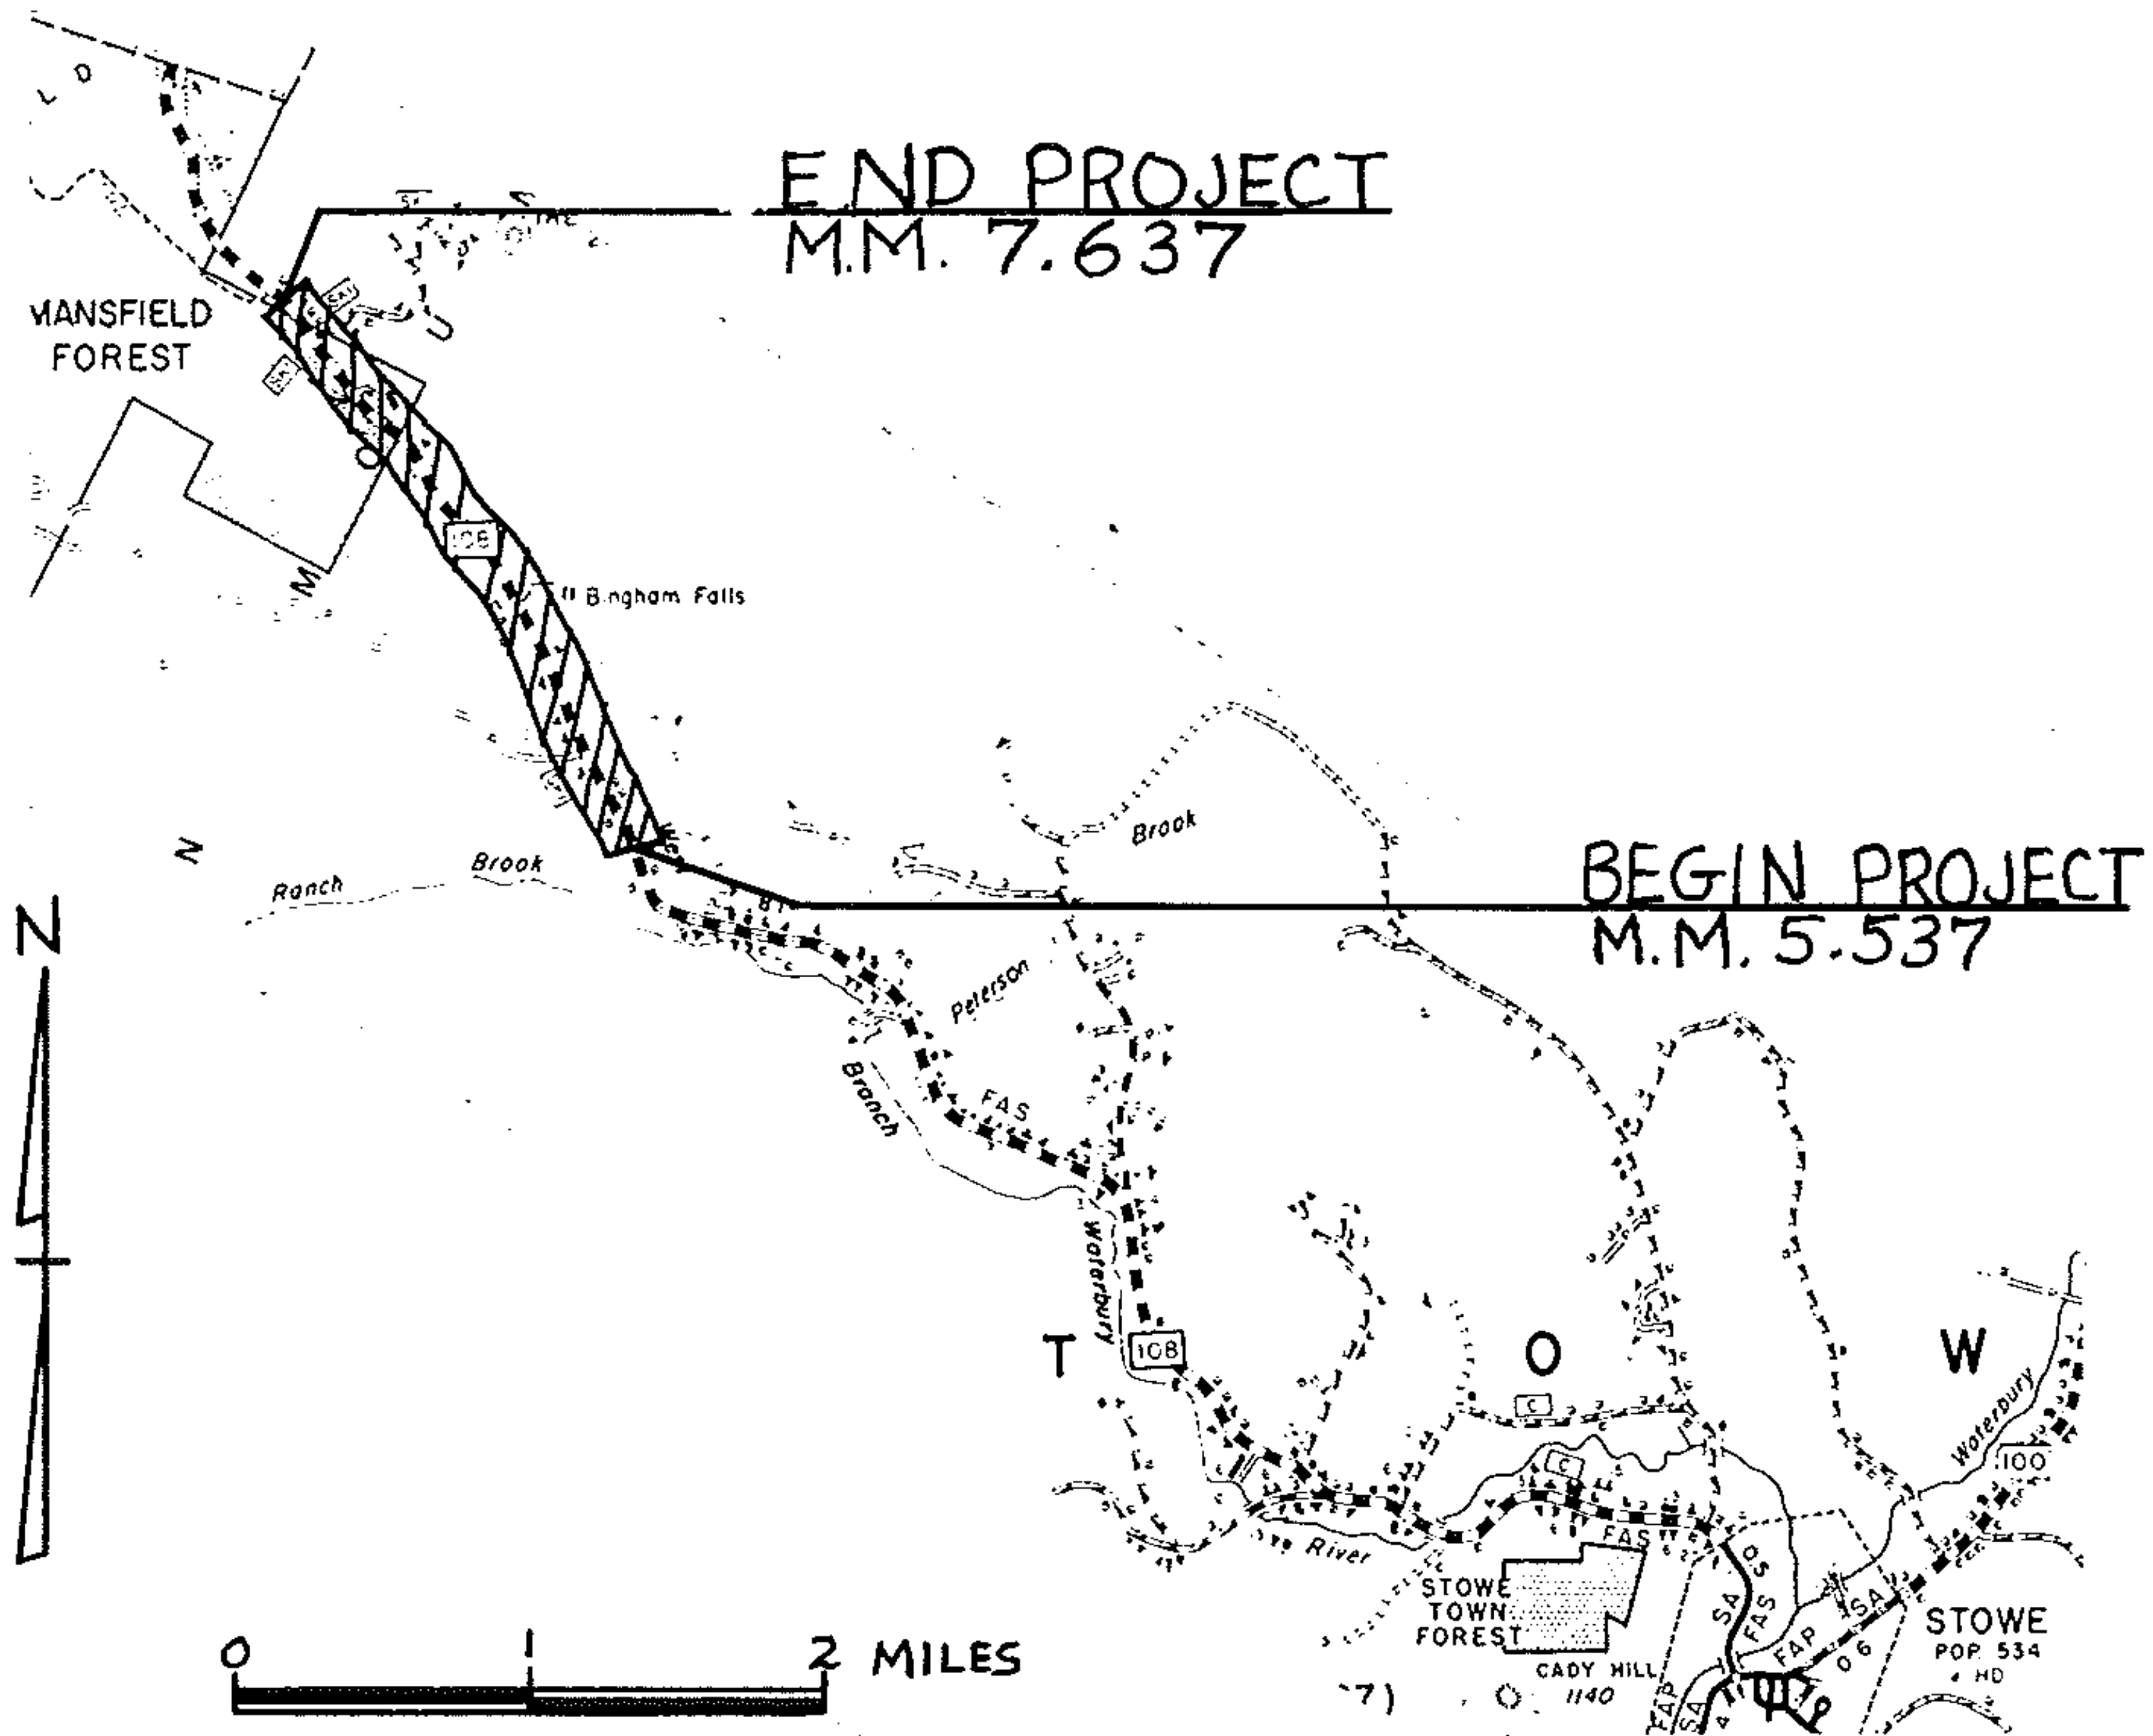

PROJECT STOWE

NO. HMA 2865

SHEET 24 OF 30 SHEETS