


PAVING LIMITS FOR TOWN ROADS & DRIVES


PAVING LIMITS FOR TOWN ROADS

TRAVEL LANE

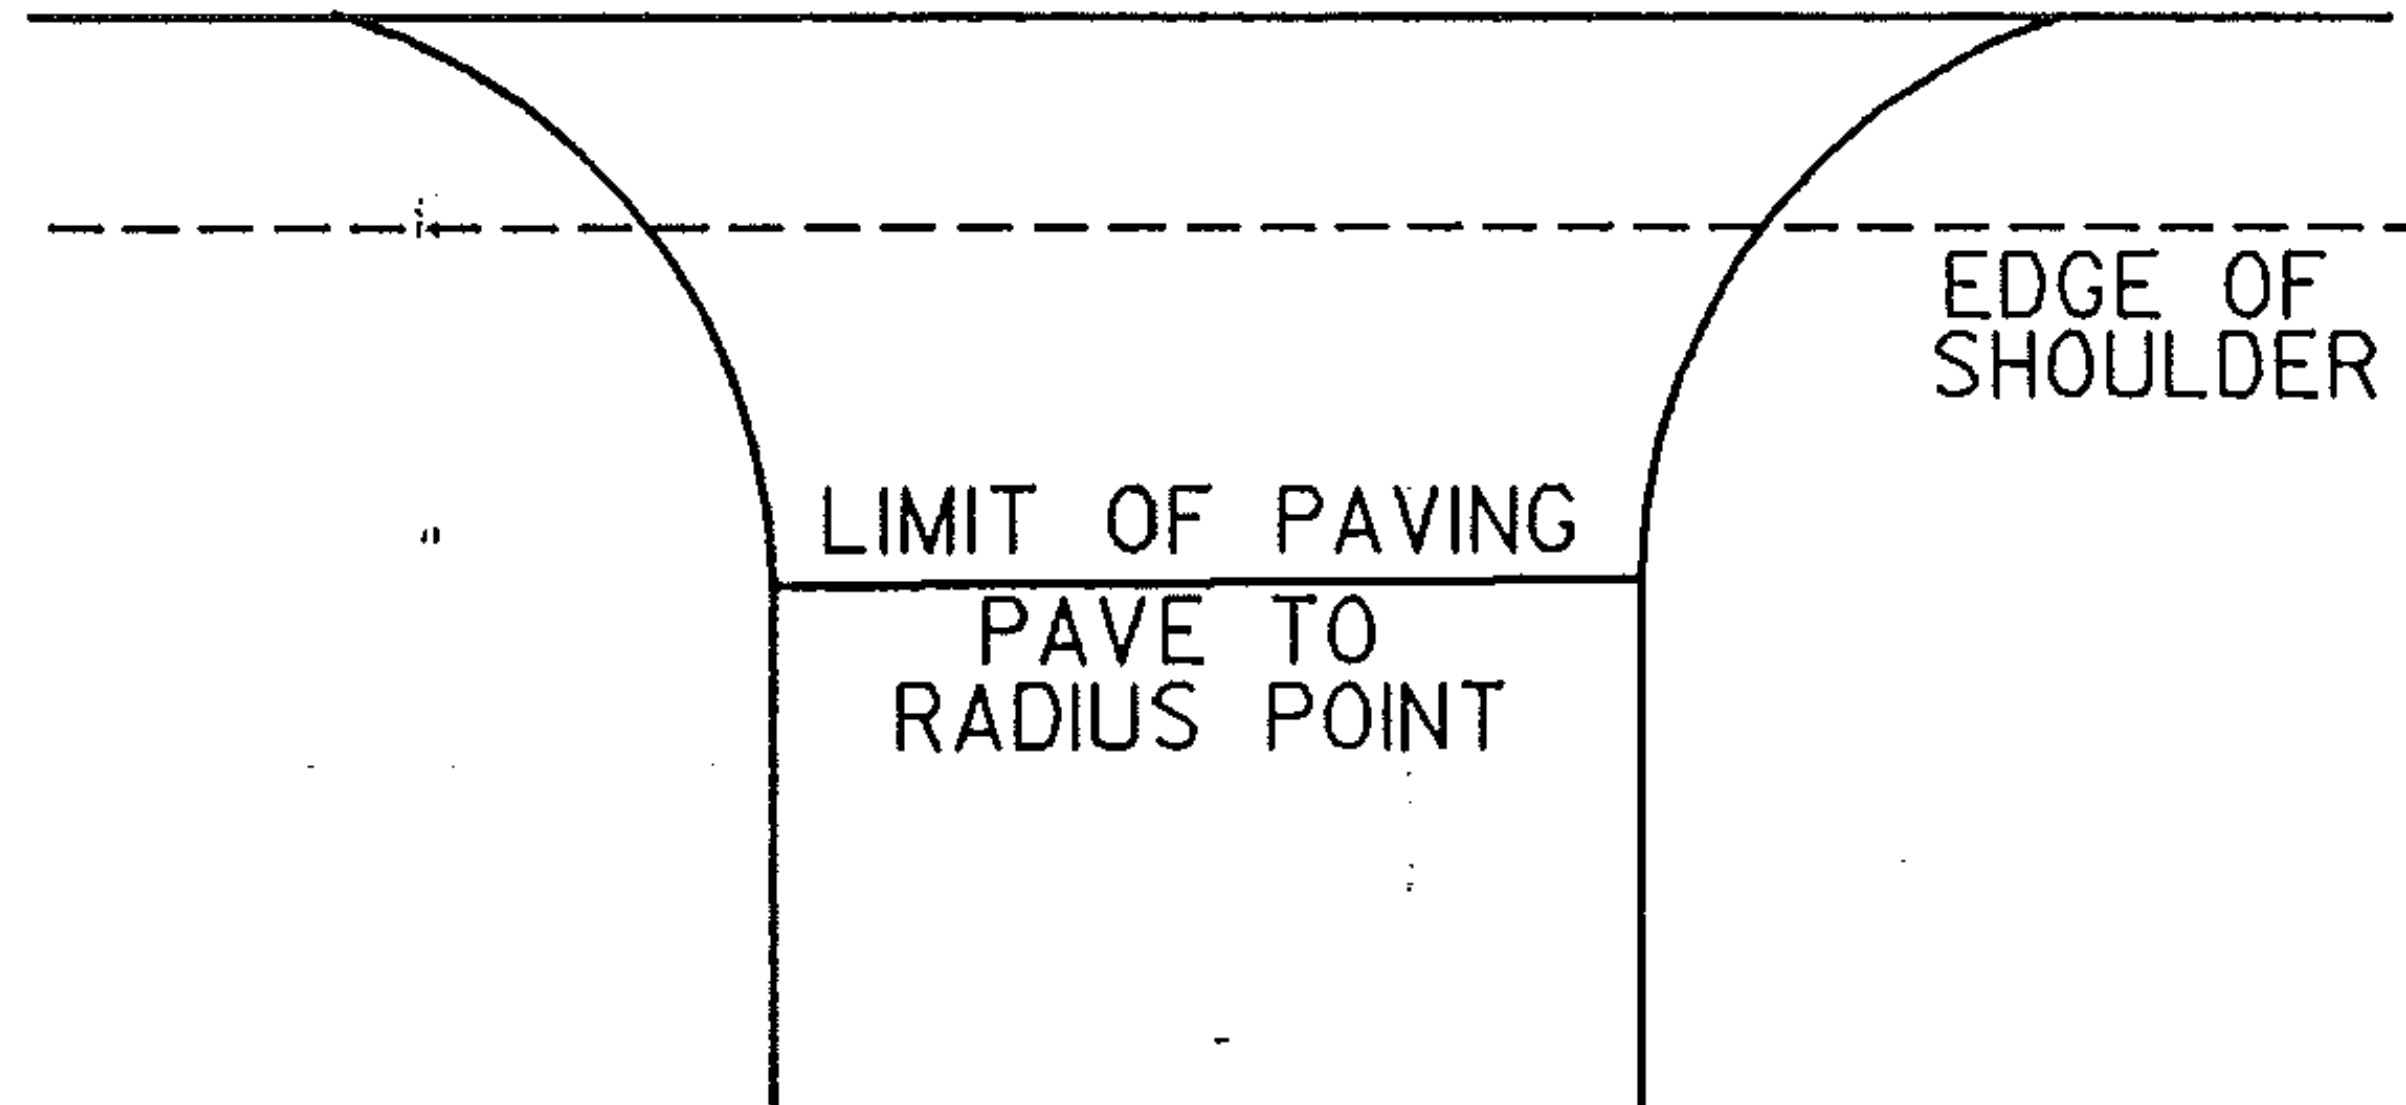

PAVING LIMITS FOR DRIVES

TRAVEL LANE

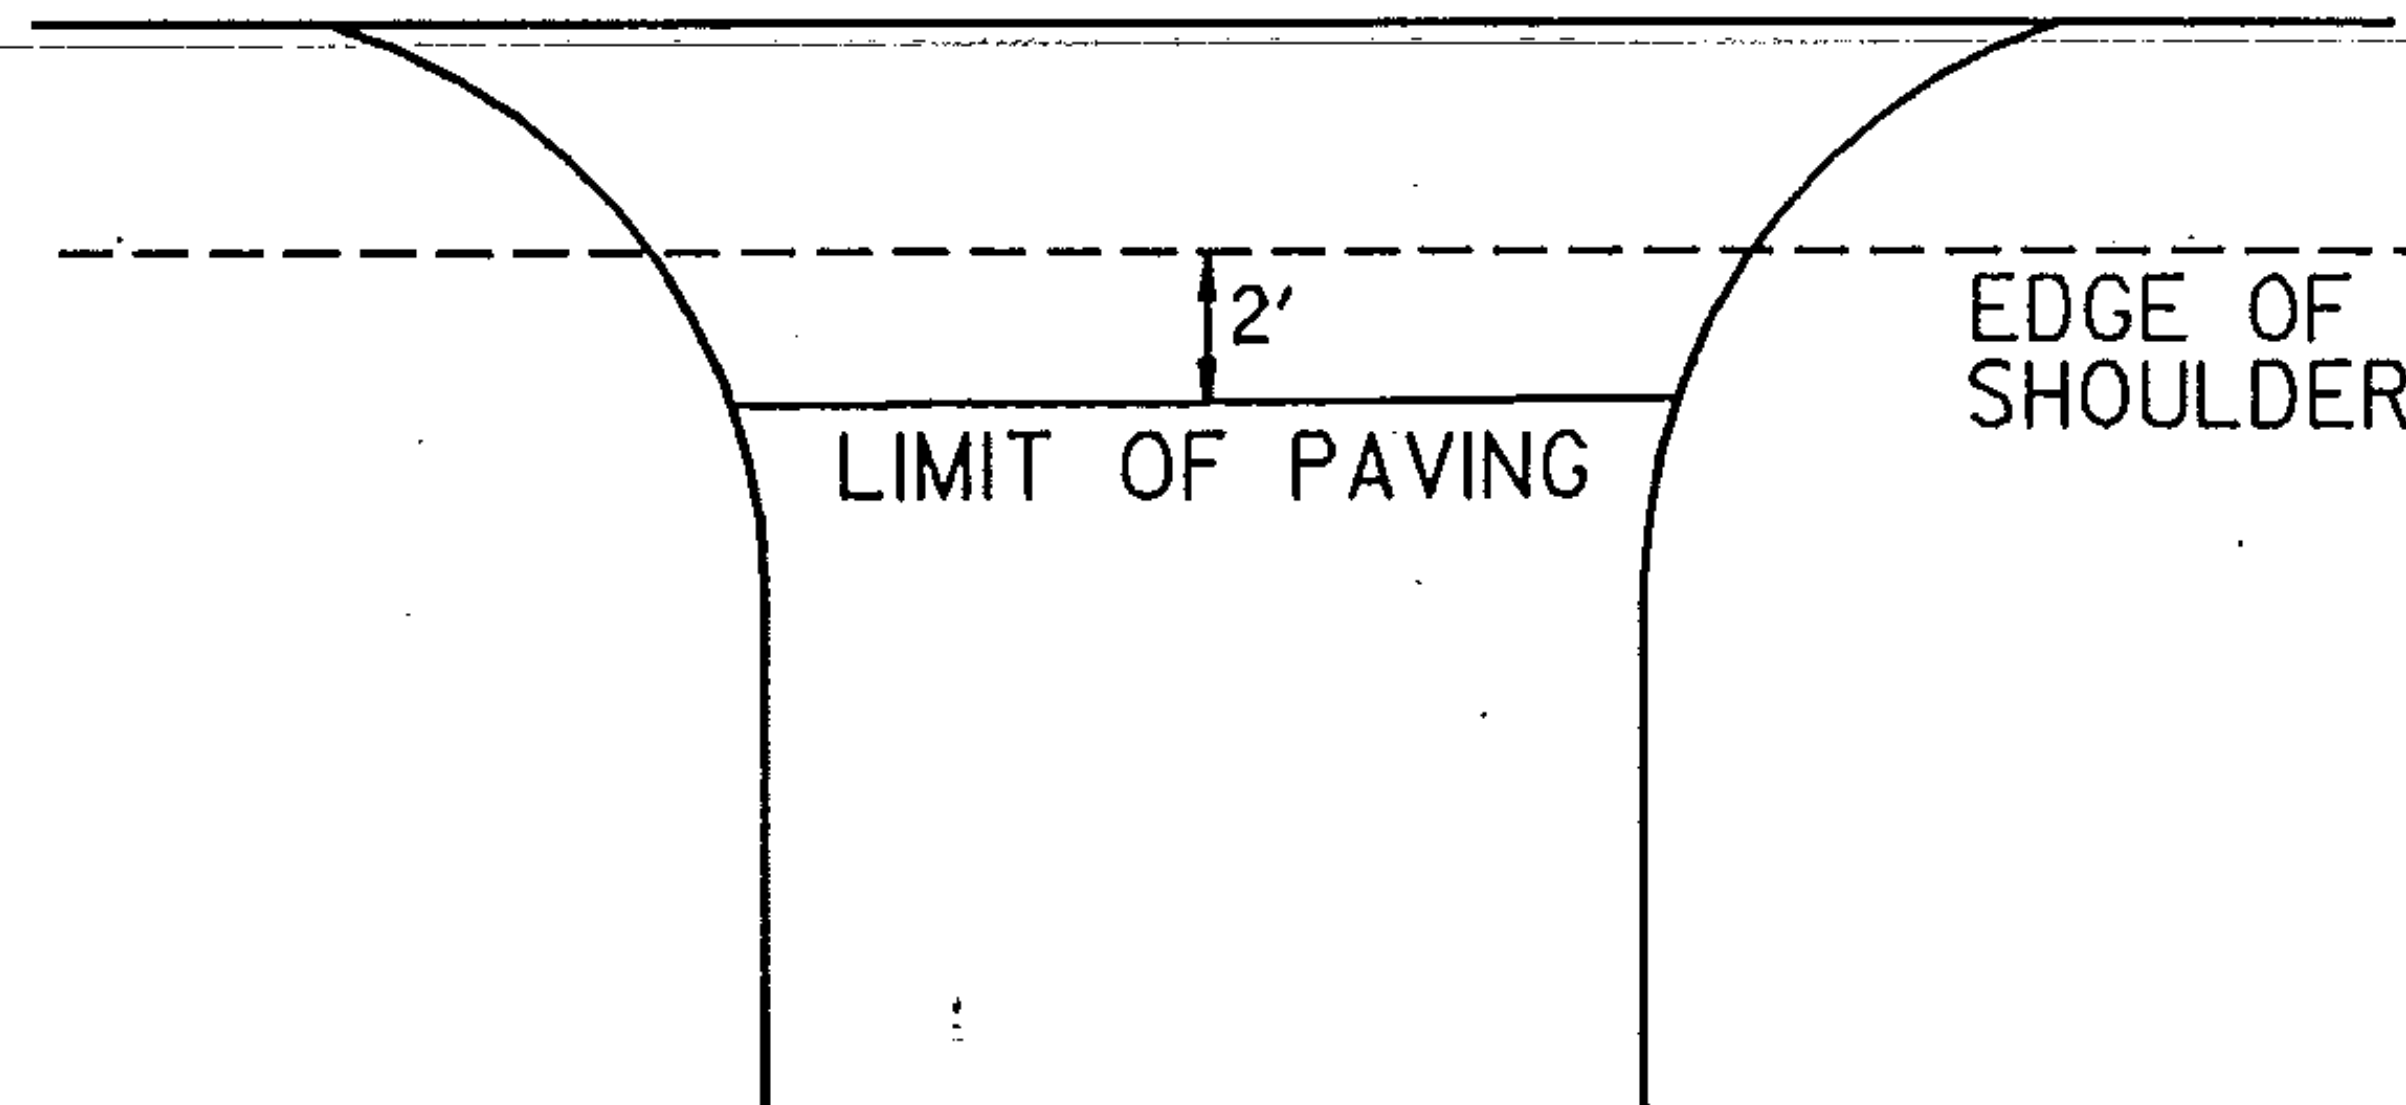

PROJECT STOWE

NO. HMA 2865

SHEET 26 OF 30 SHEETS