


DESCRIPTION AND LOCATION



BEGINNING IN THE TOWN OF
 FAIRFAX ON VT ROUTE 104 AT
 MM 6.905
 AND EXTENDING NORTHERLY THROUGH THE
 TOWNS OF GEORGIA AND FAIRFIELD TO
 THE ST. ALBANS-FAIRFIELD T/L MM 0.111,
 A TOTAL OF 7.527 MILES. RESURFACING
 OF THE HIGHWAY, NEW PAVEMENT MARKINGS.

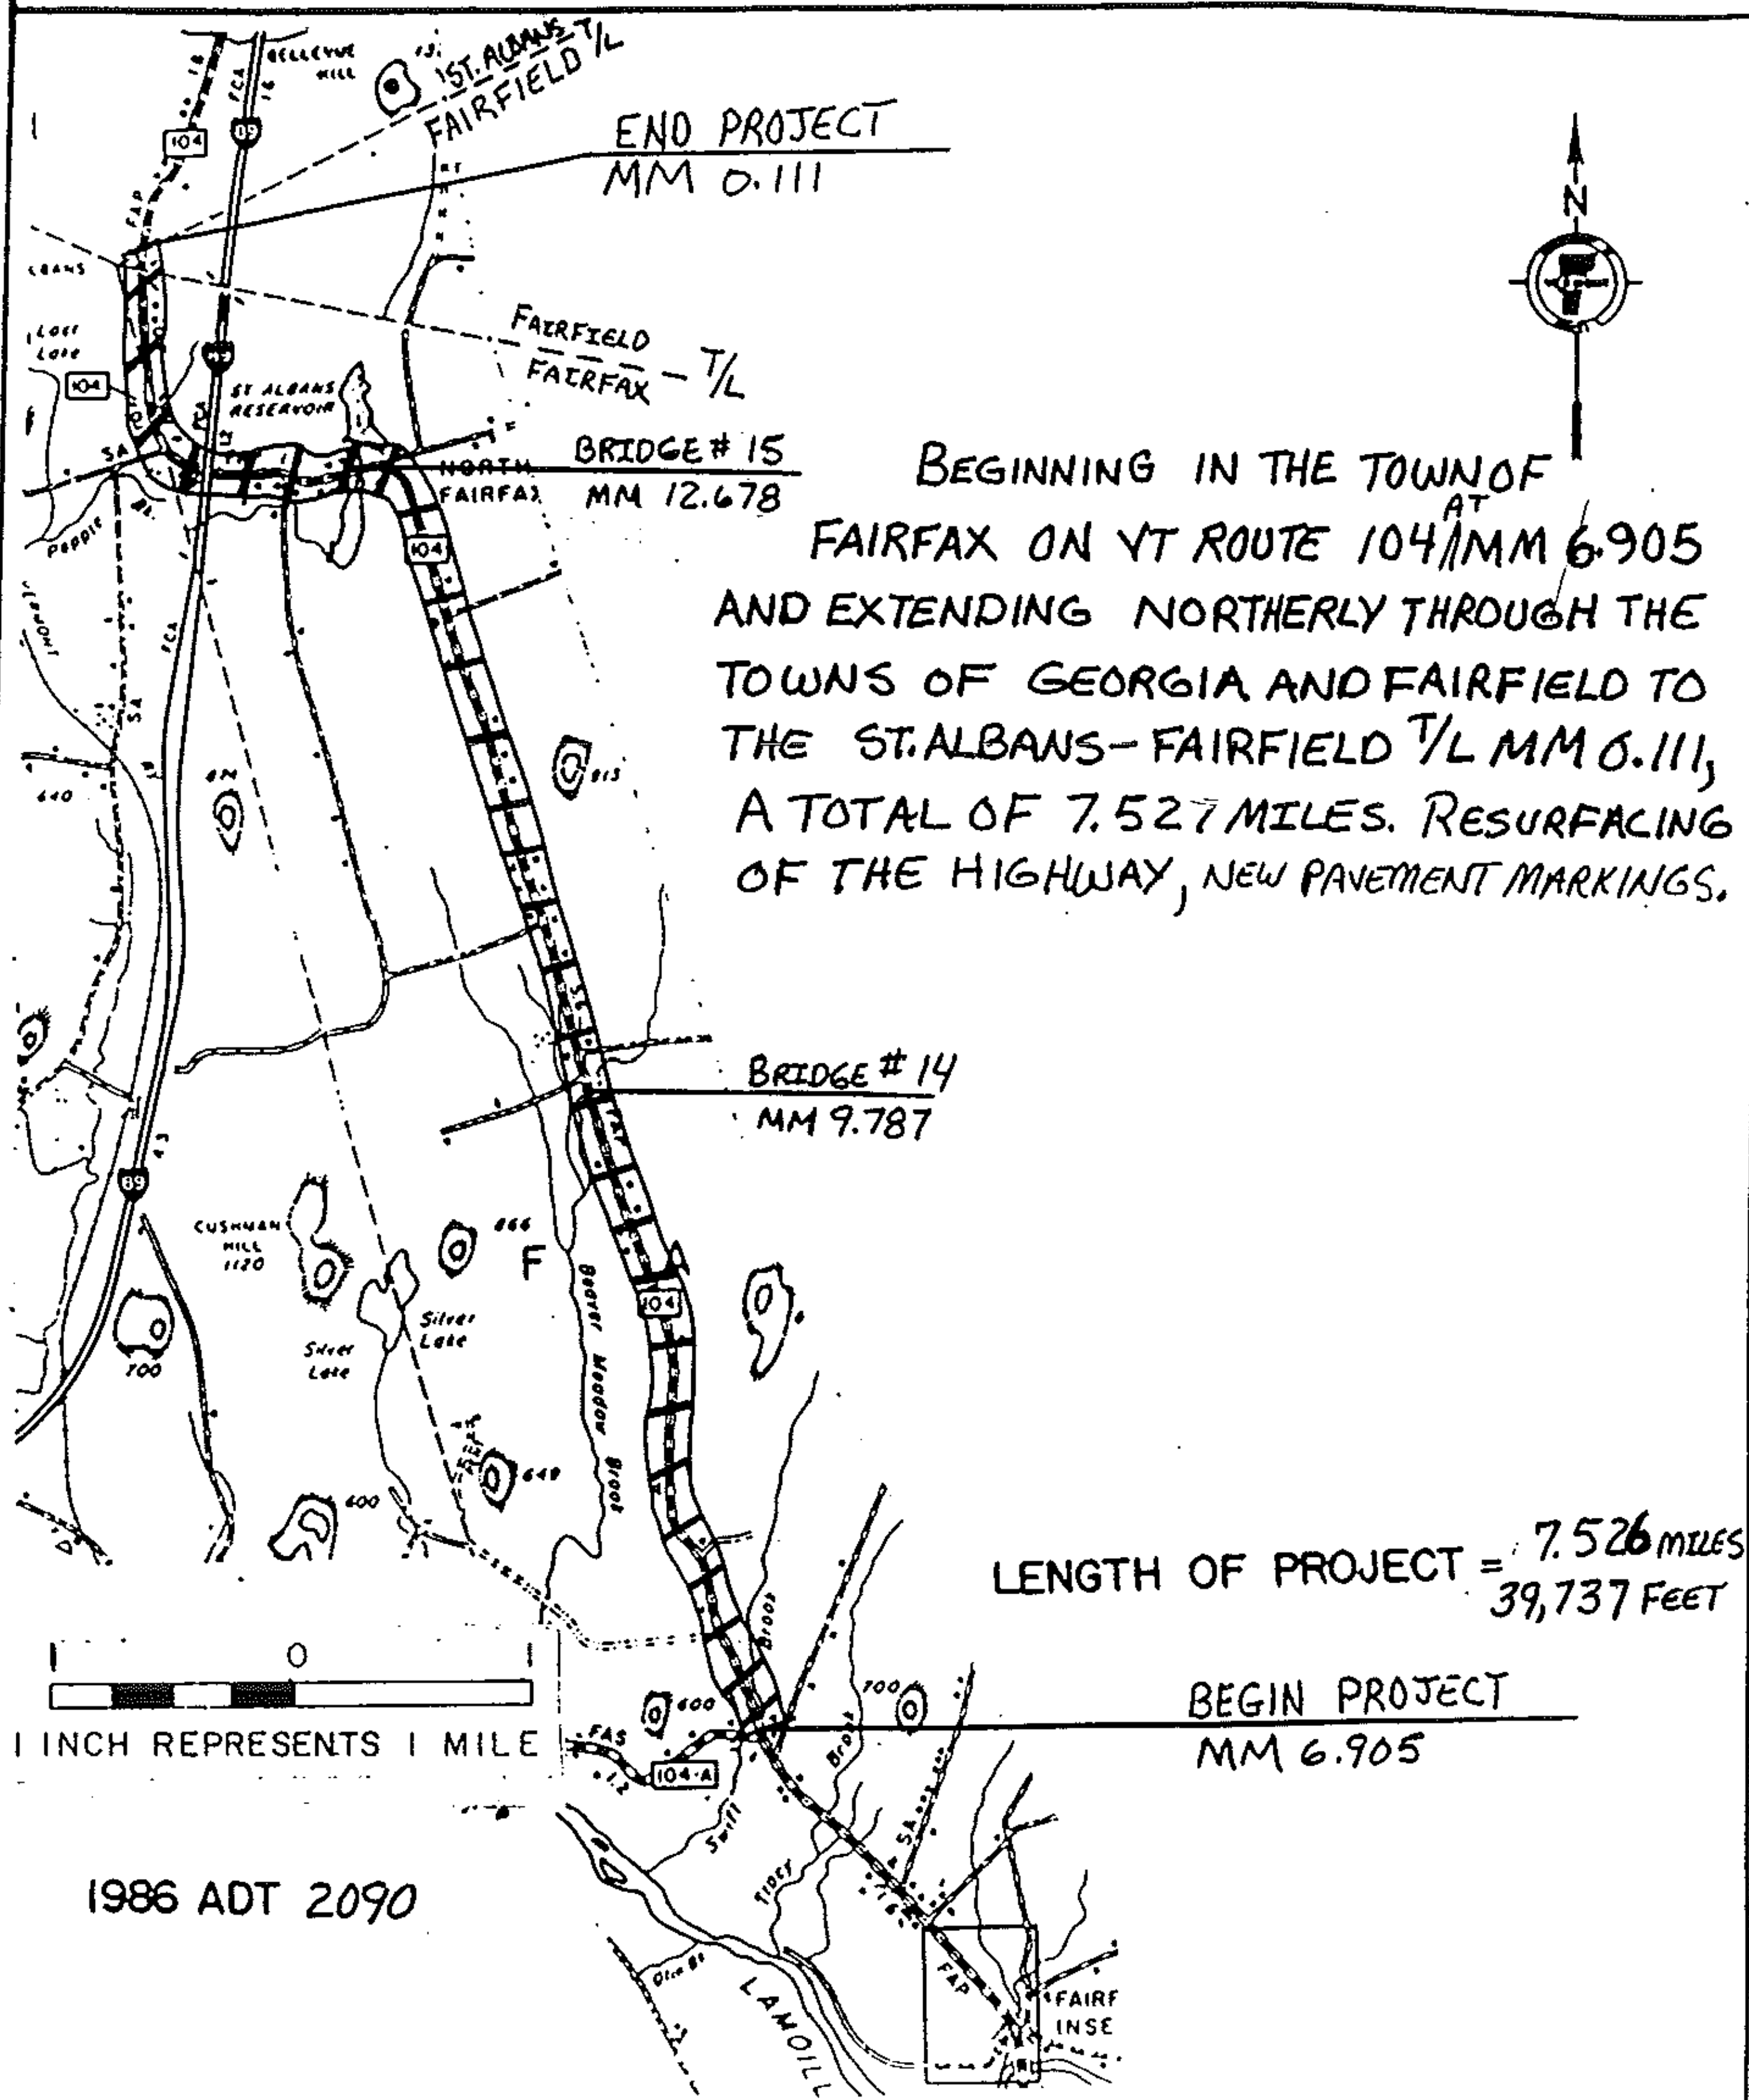

LENGTH OF PROJECT = 7.526 MILES
 39,737 FEET

BEGIN PROJECT
 MM 6.905

1 INCH REPRESENTS 1 MILE

1986 ADT 2090

PROJECT FAIRFAX-GEORGIA-FAIRFIELD

NO. HMA 2836

SHEET 19 OF 60 SHEETS