


TYPICAL SECTIONS & DESIGN DATA

ITEM 406.25 BITUMINOUS CONCRETE PAVEMENT
LEVELING COURSE TYPE IV (385 TONS/MILE)
1/4" WEARING COURSE TYPE III ($\pm 1/4"$)
AS DIRECTED BY THE ENGINEER

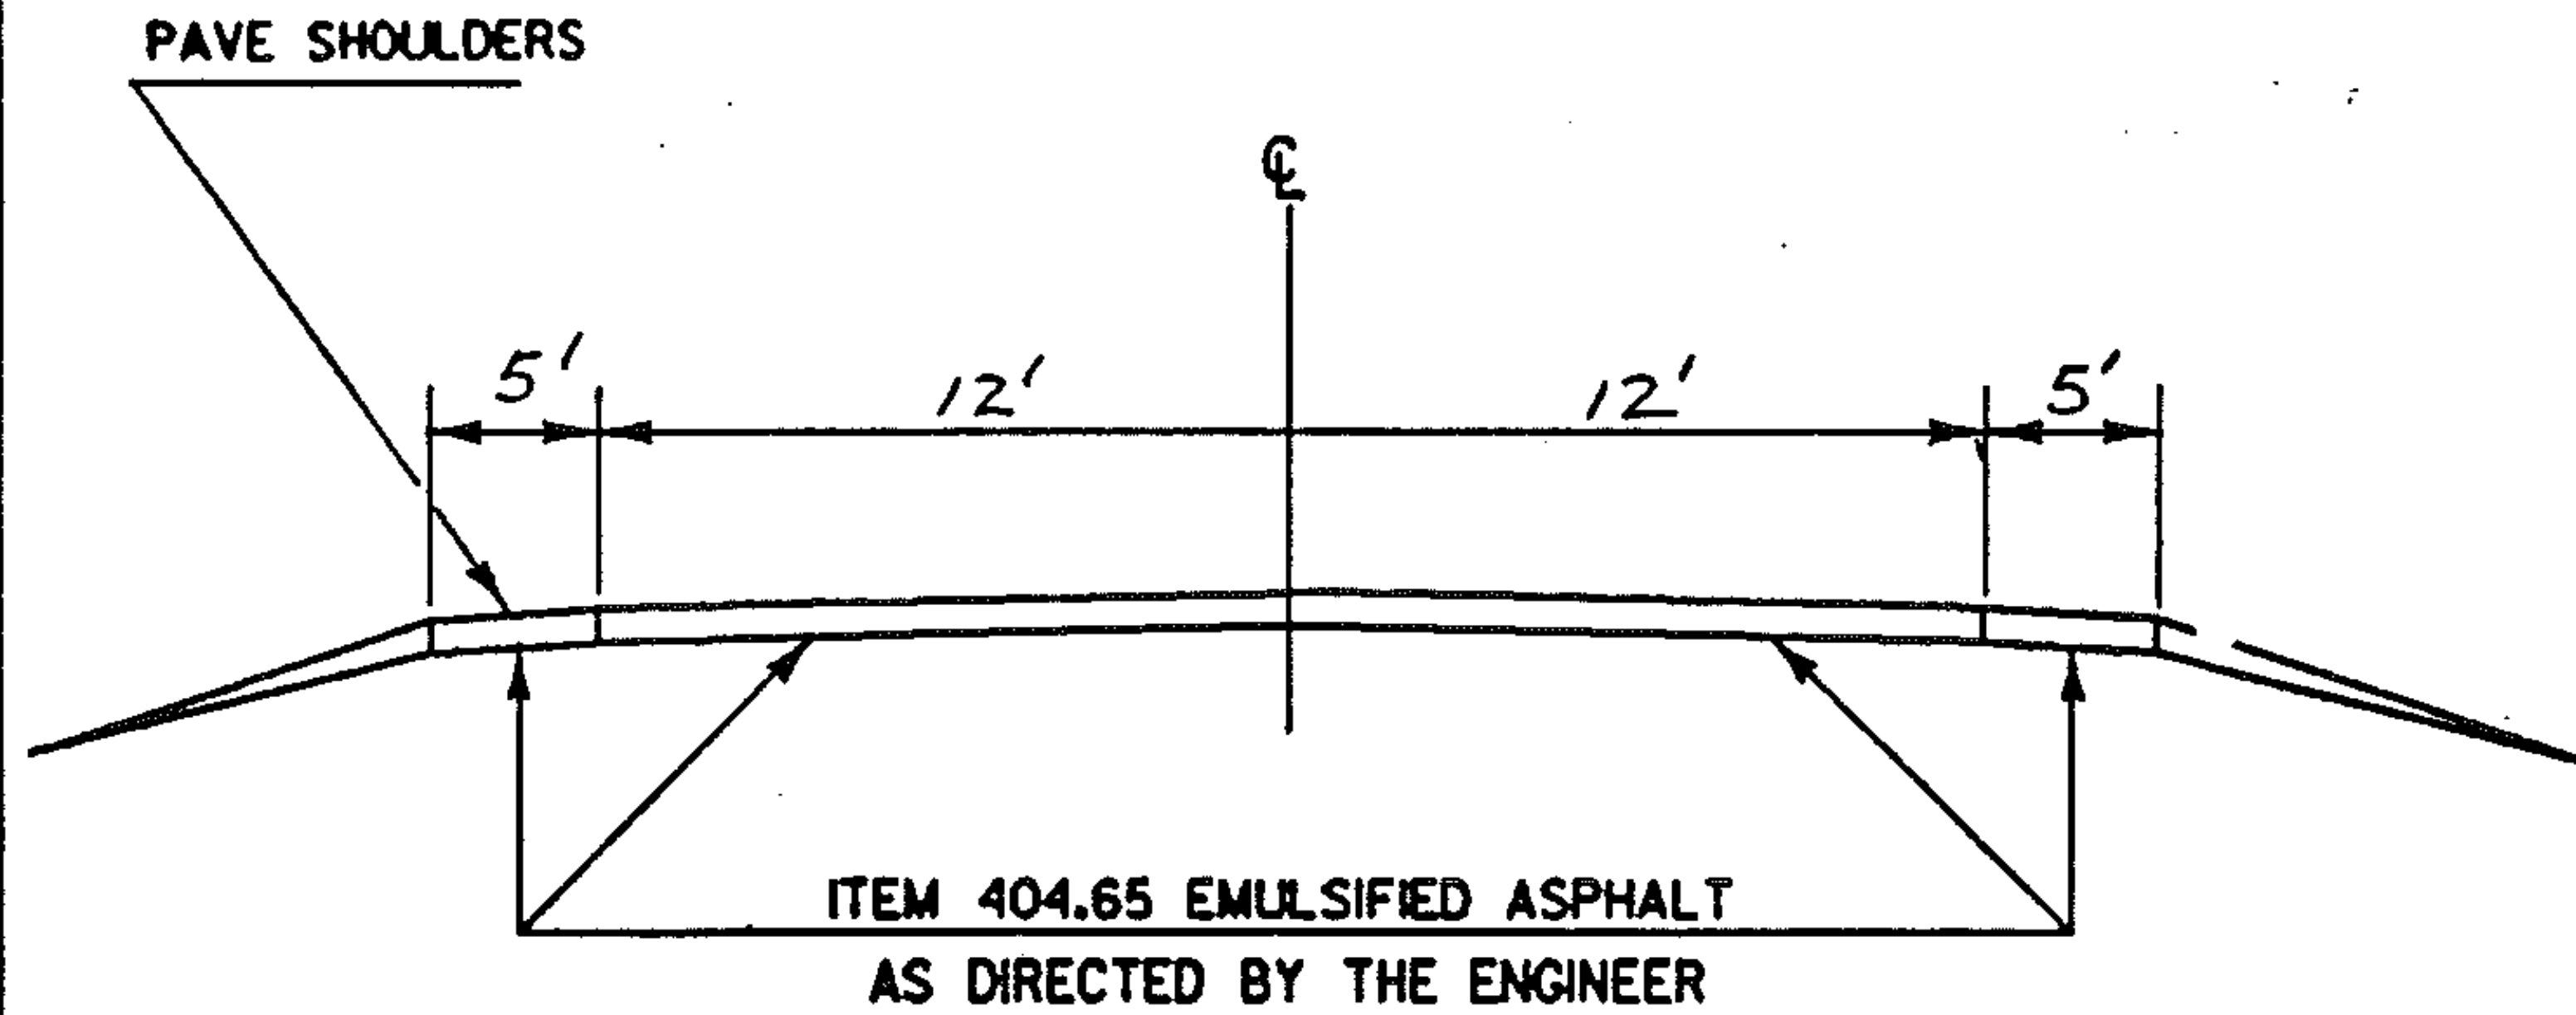

VT 104-A GEORGIA MM 1.567 ~ MM 1.794

PROJECT GEORGIA

NO. HMA 2854

SHEET 36 OF 66 SHEETS