
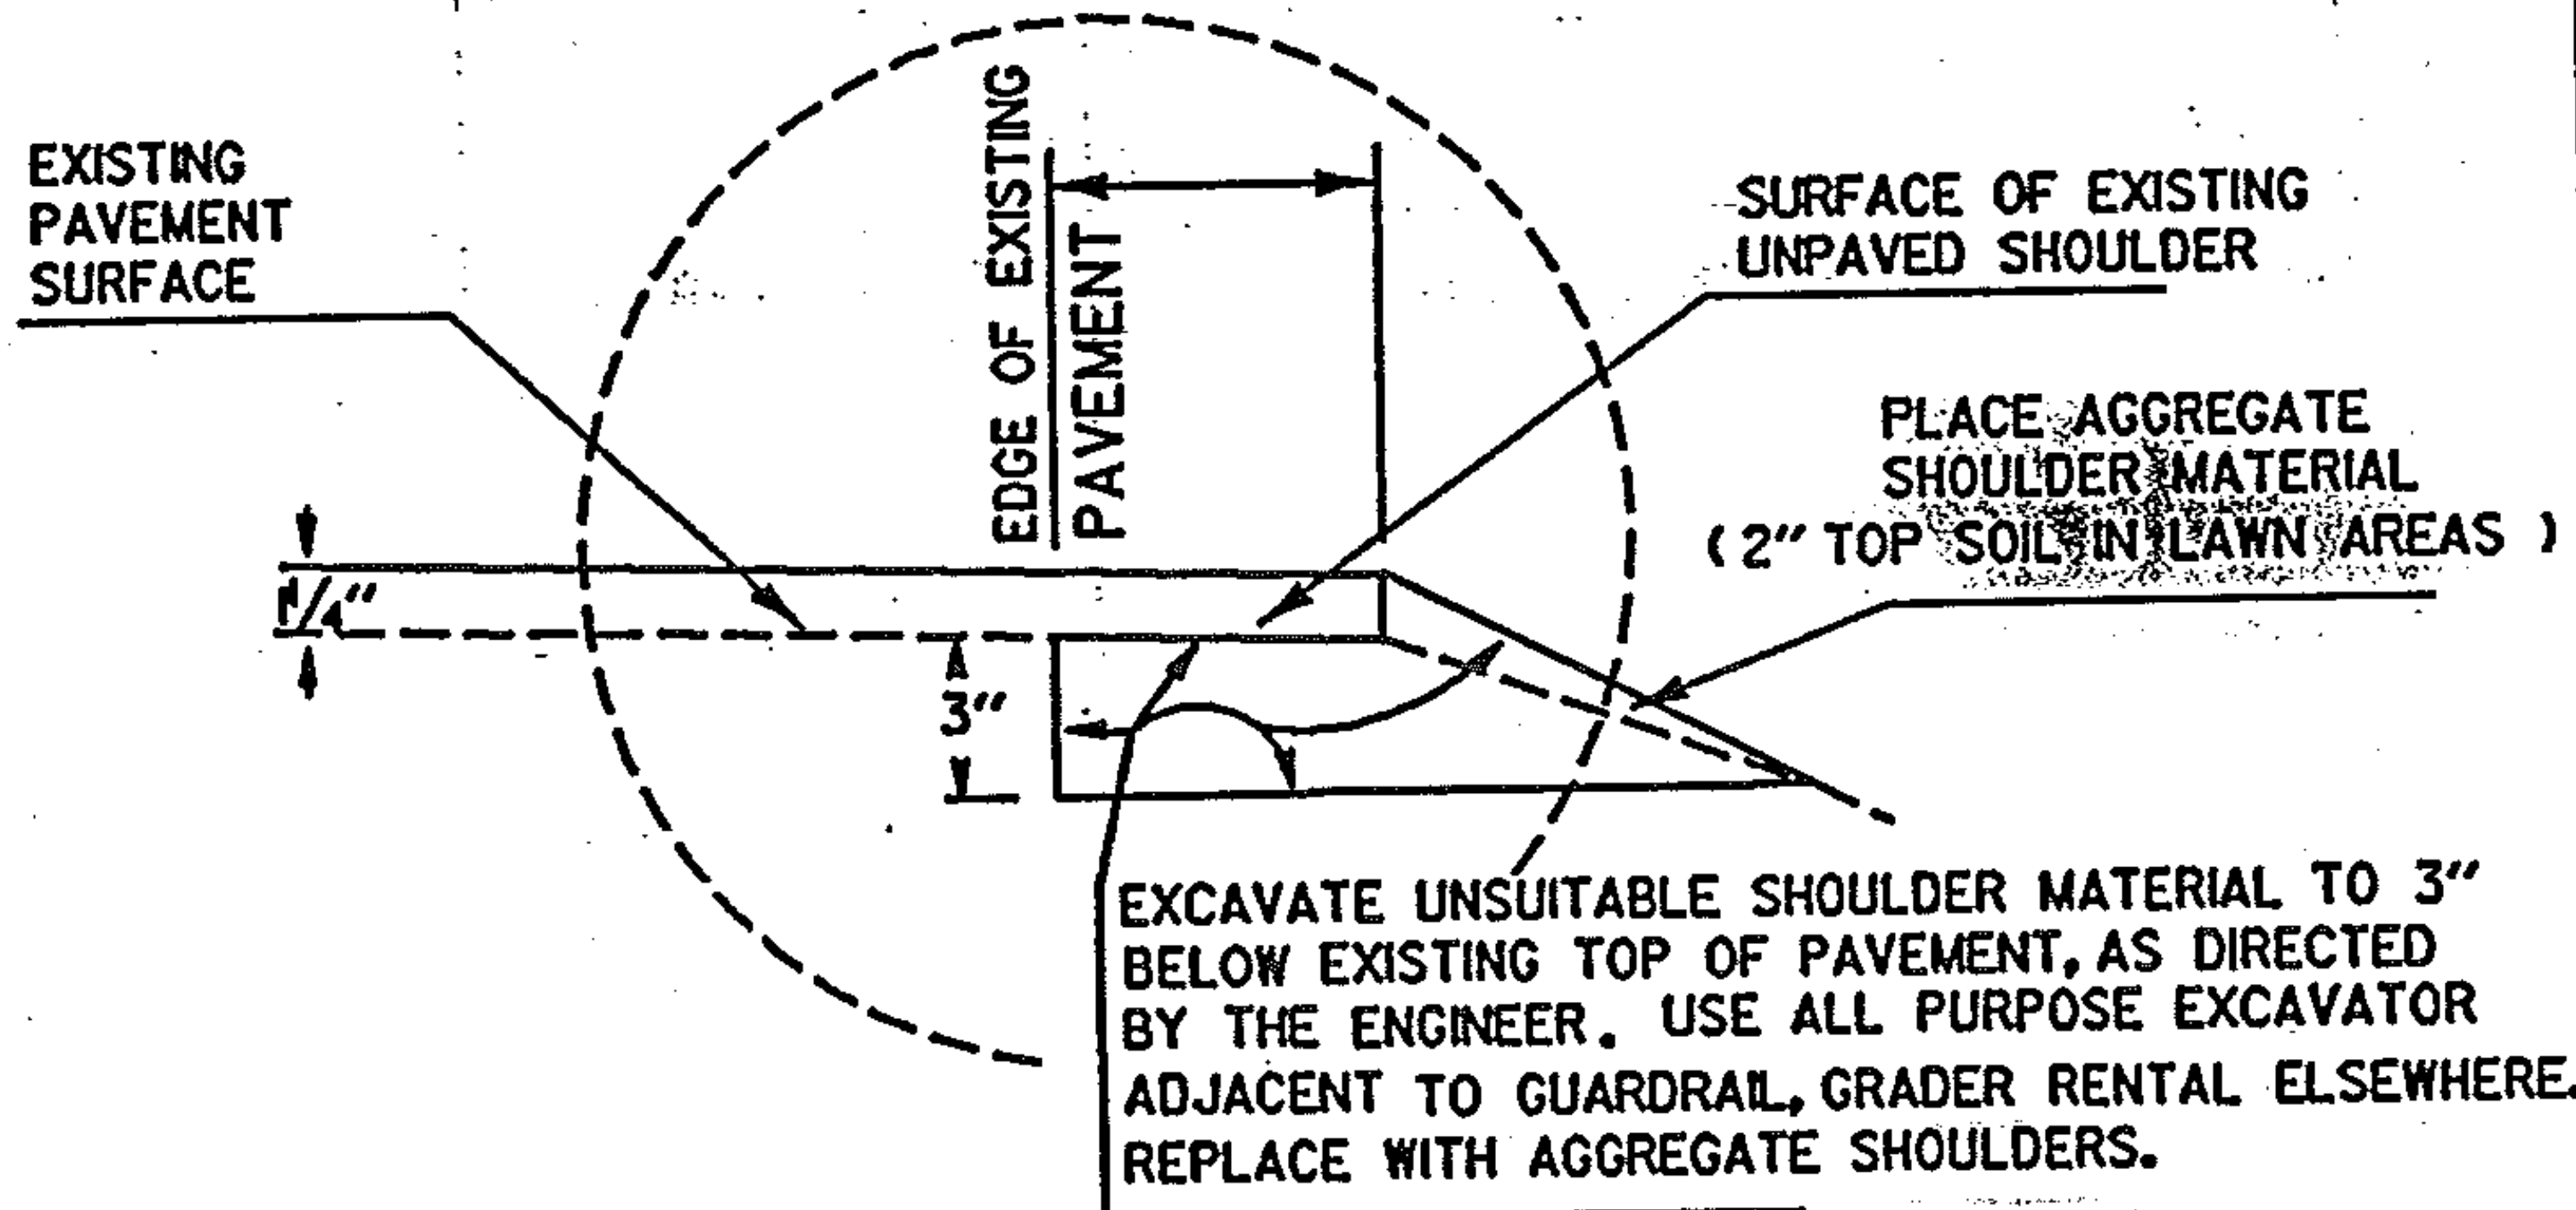


TYPICAL SECTIONS & DESIGN DATA

ITEM 406.25 BITUMINOUS CONCRETE PAVEMENT
 AGGREGATE SHOULDERS ($\pm 1/2"$)
 LEVELING COURSE TYPE IV (315 TONS/MILE)
 1 1/4" WEARING COURSE TYPE III ($\pm 1/4"$)
 AS DIRECTED BY THE ENGINEER
 VT. 36 FAIRFIELD MM 1.33 ~ MM 1.830

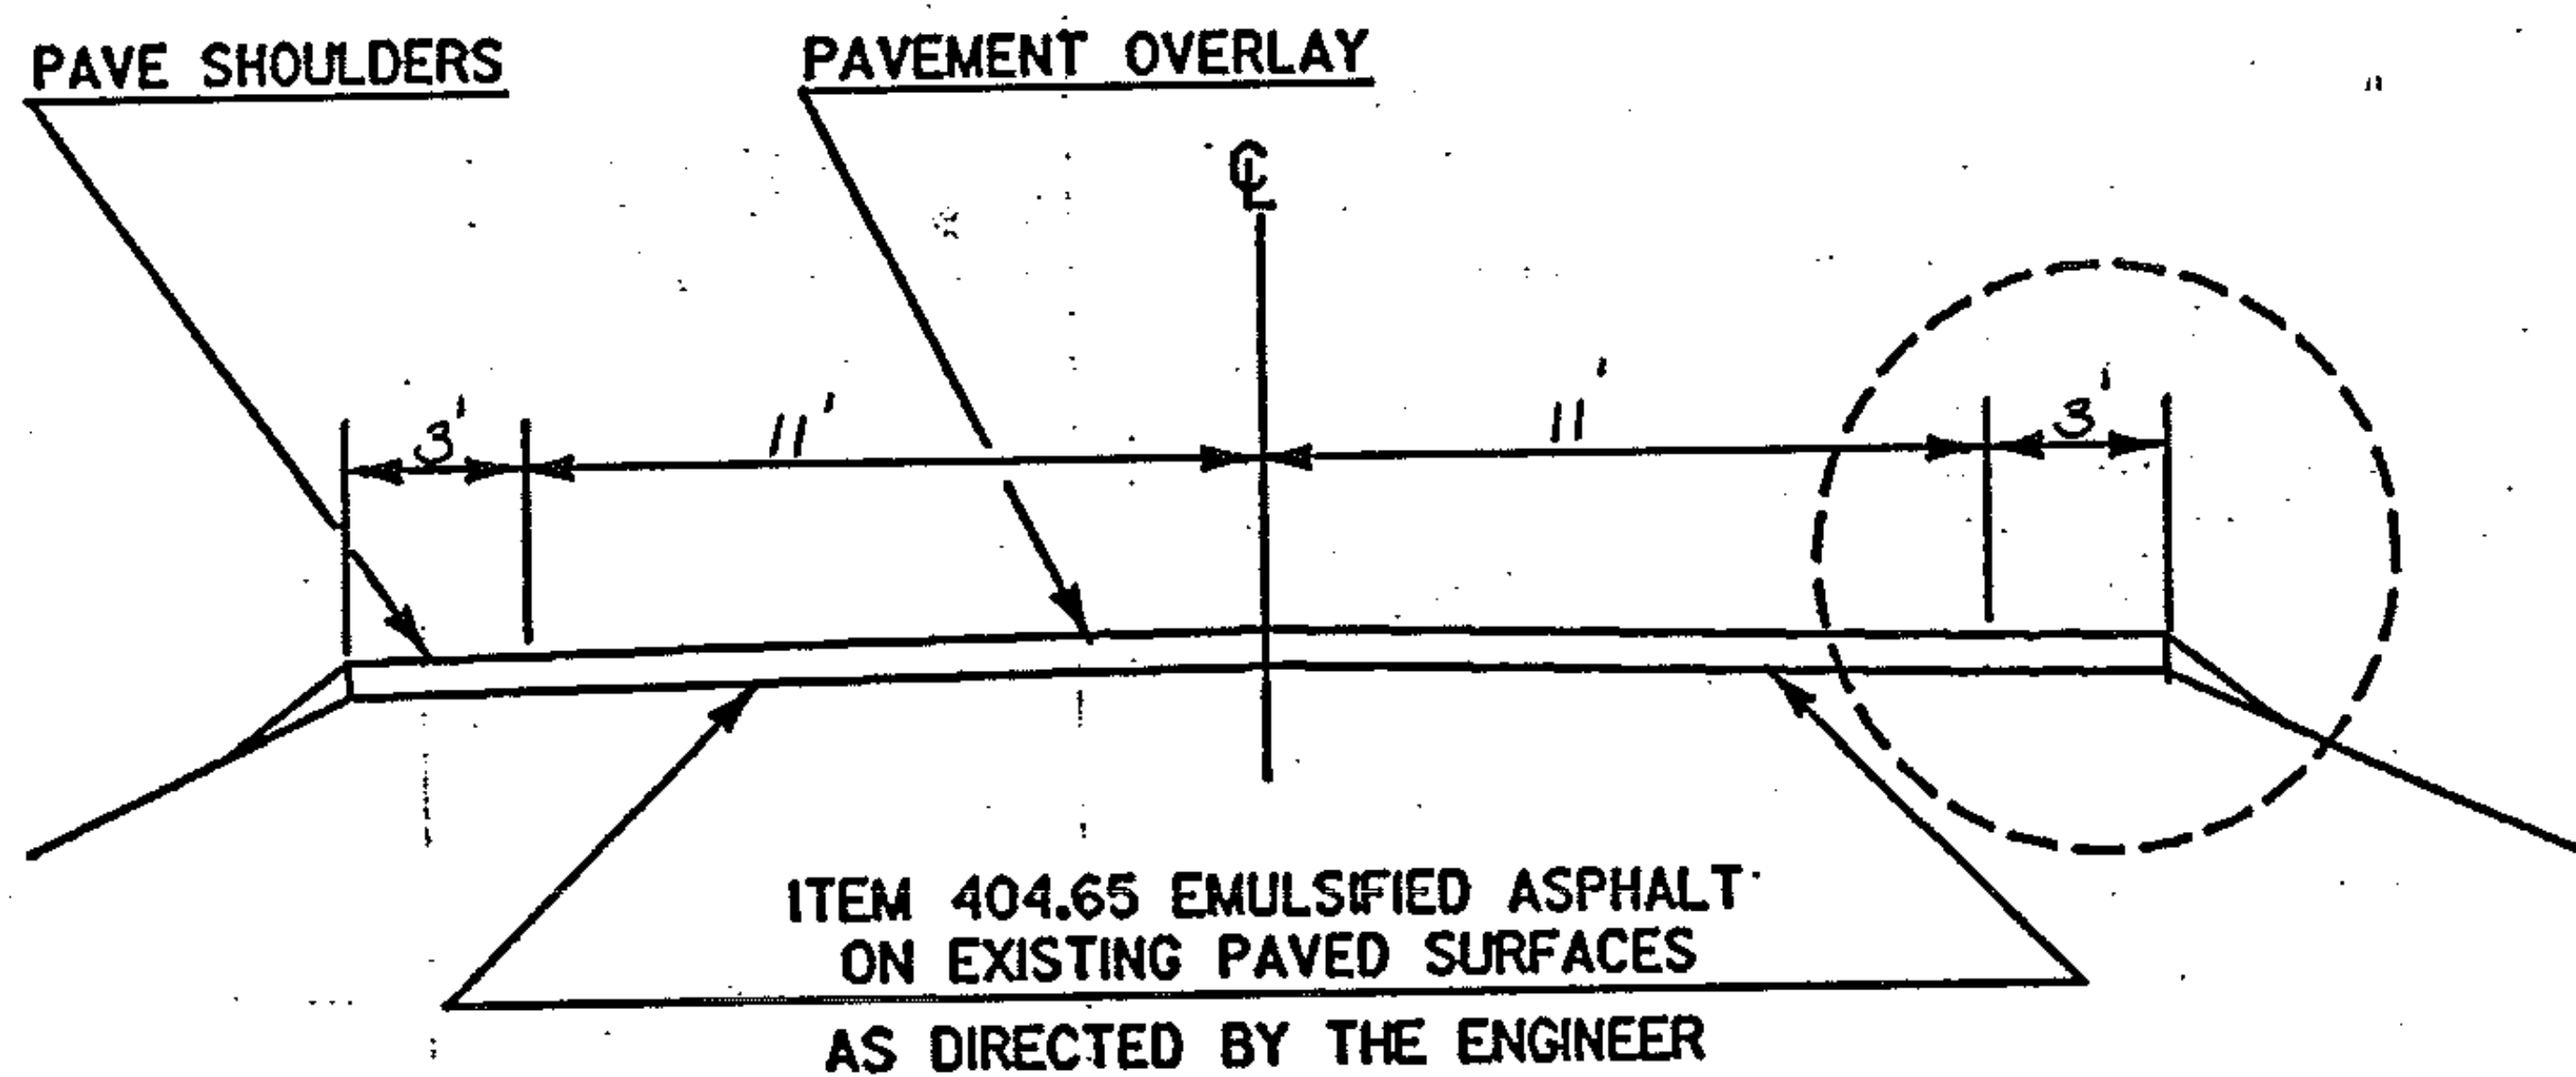

PROJECT FAIRFIELD

NO. HMA 2871

SHEET 40 OF 60 SHEETS