


TYPICAL SECTIONS & DESIGN DATA

ITEM 406.25 BITUMINOUS CONCRETE PAVEMENT
 AGGREGATE SHOULDERS ($\pm 1/2"$)
 LEVELING COURSE TYPE IV (350 TONS/MILE)
 1 1/4" WEARING COURSE TYPE III ($\pm 1/4"$)
 AS DIRECTED BY THE ENGINEER

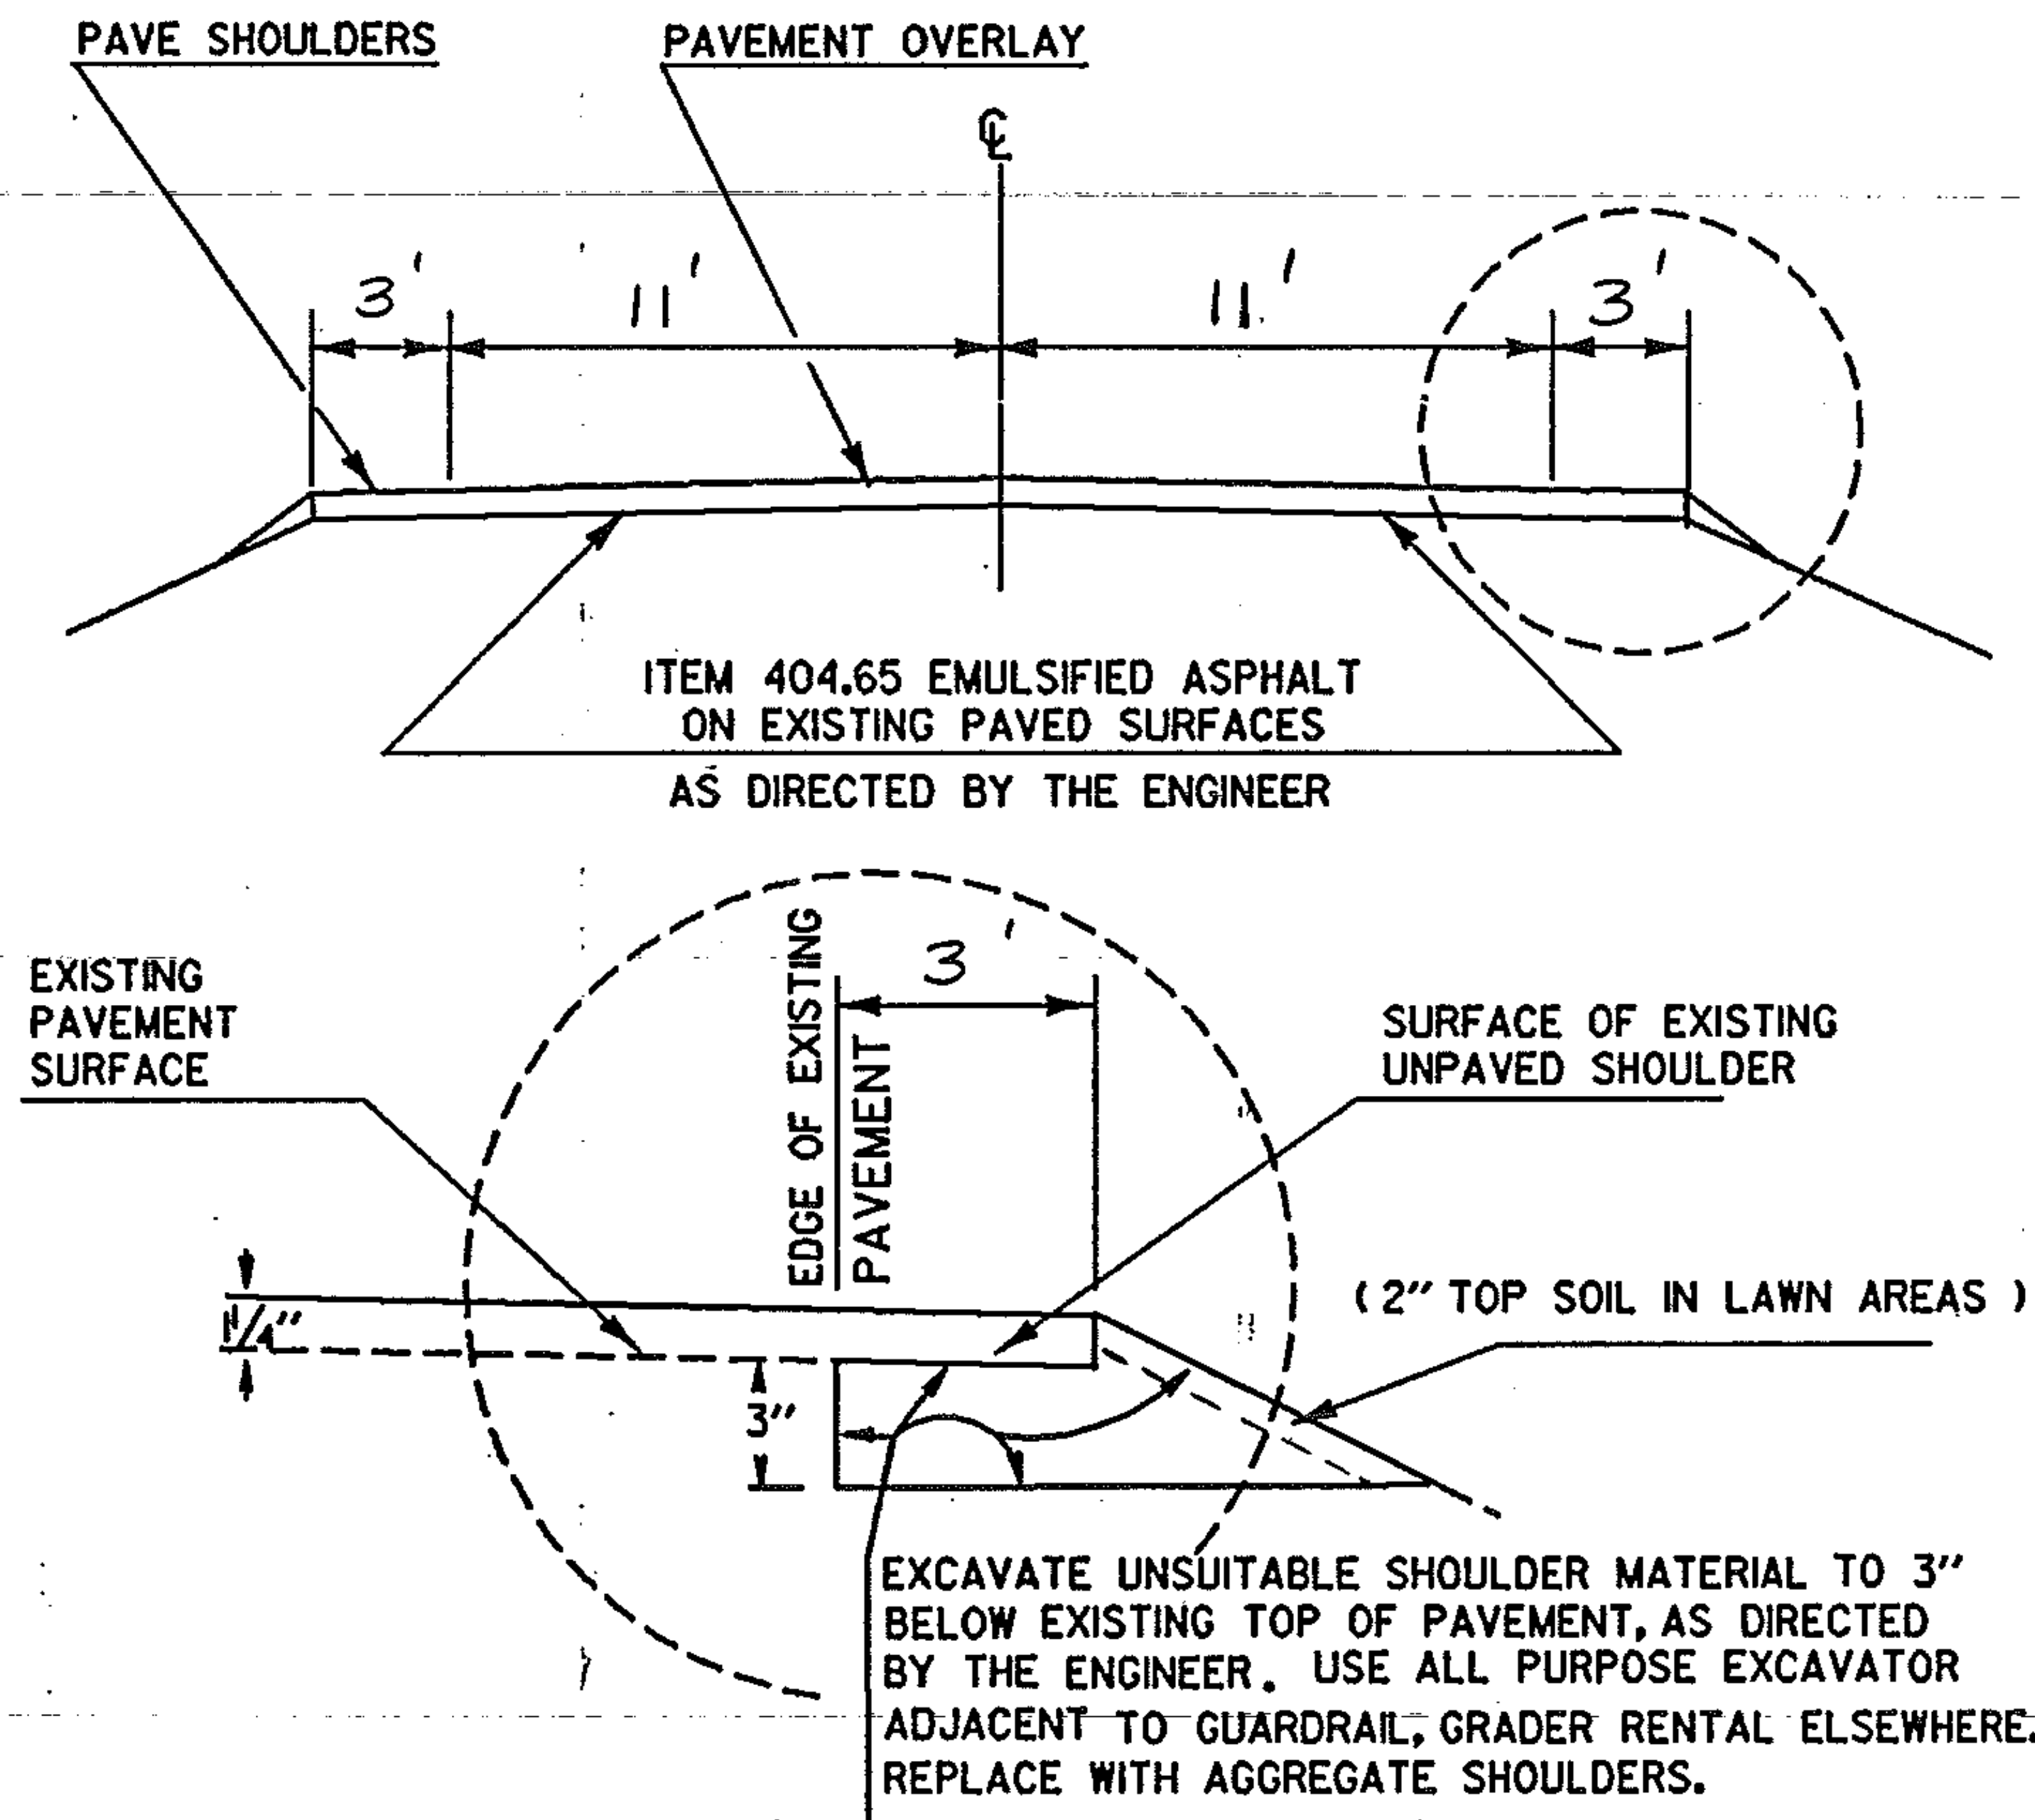

PROJECT LYNDON - SHEFFIELD

NO. HMA 2834

SHEET 7 OF 30 SHEETS