


## DESCRIPTION AND LOCATION

PROJECT LENGTH: 7.000 MILES, 36,960.00 FEET

1986 A.D.T.: 980

BEGINNING IN THE TOWN OF HARDWICK  
ON VT. 16 AT M.M. 1.686 AND EXTENDING  
NORTHERLY 7.000 MILES TO M.M. 4.270  
IN THE TOWN OF GREENSBORO.

RESURFACING OF THE HIGHWAY AND ITS  
APPROACHES, AND NEW PAVEMENT MARKINGS.

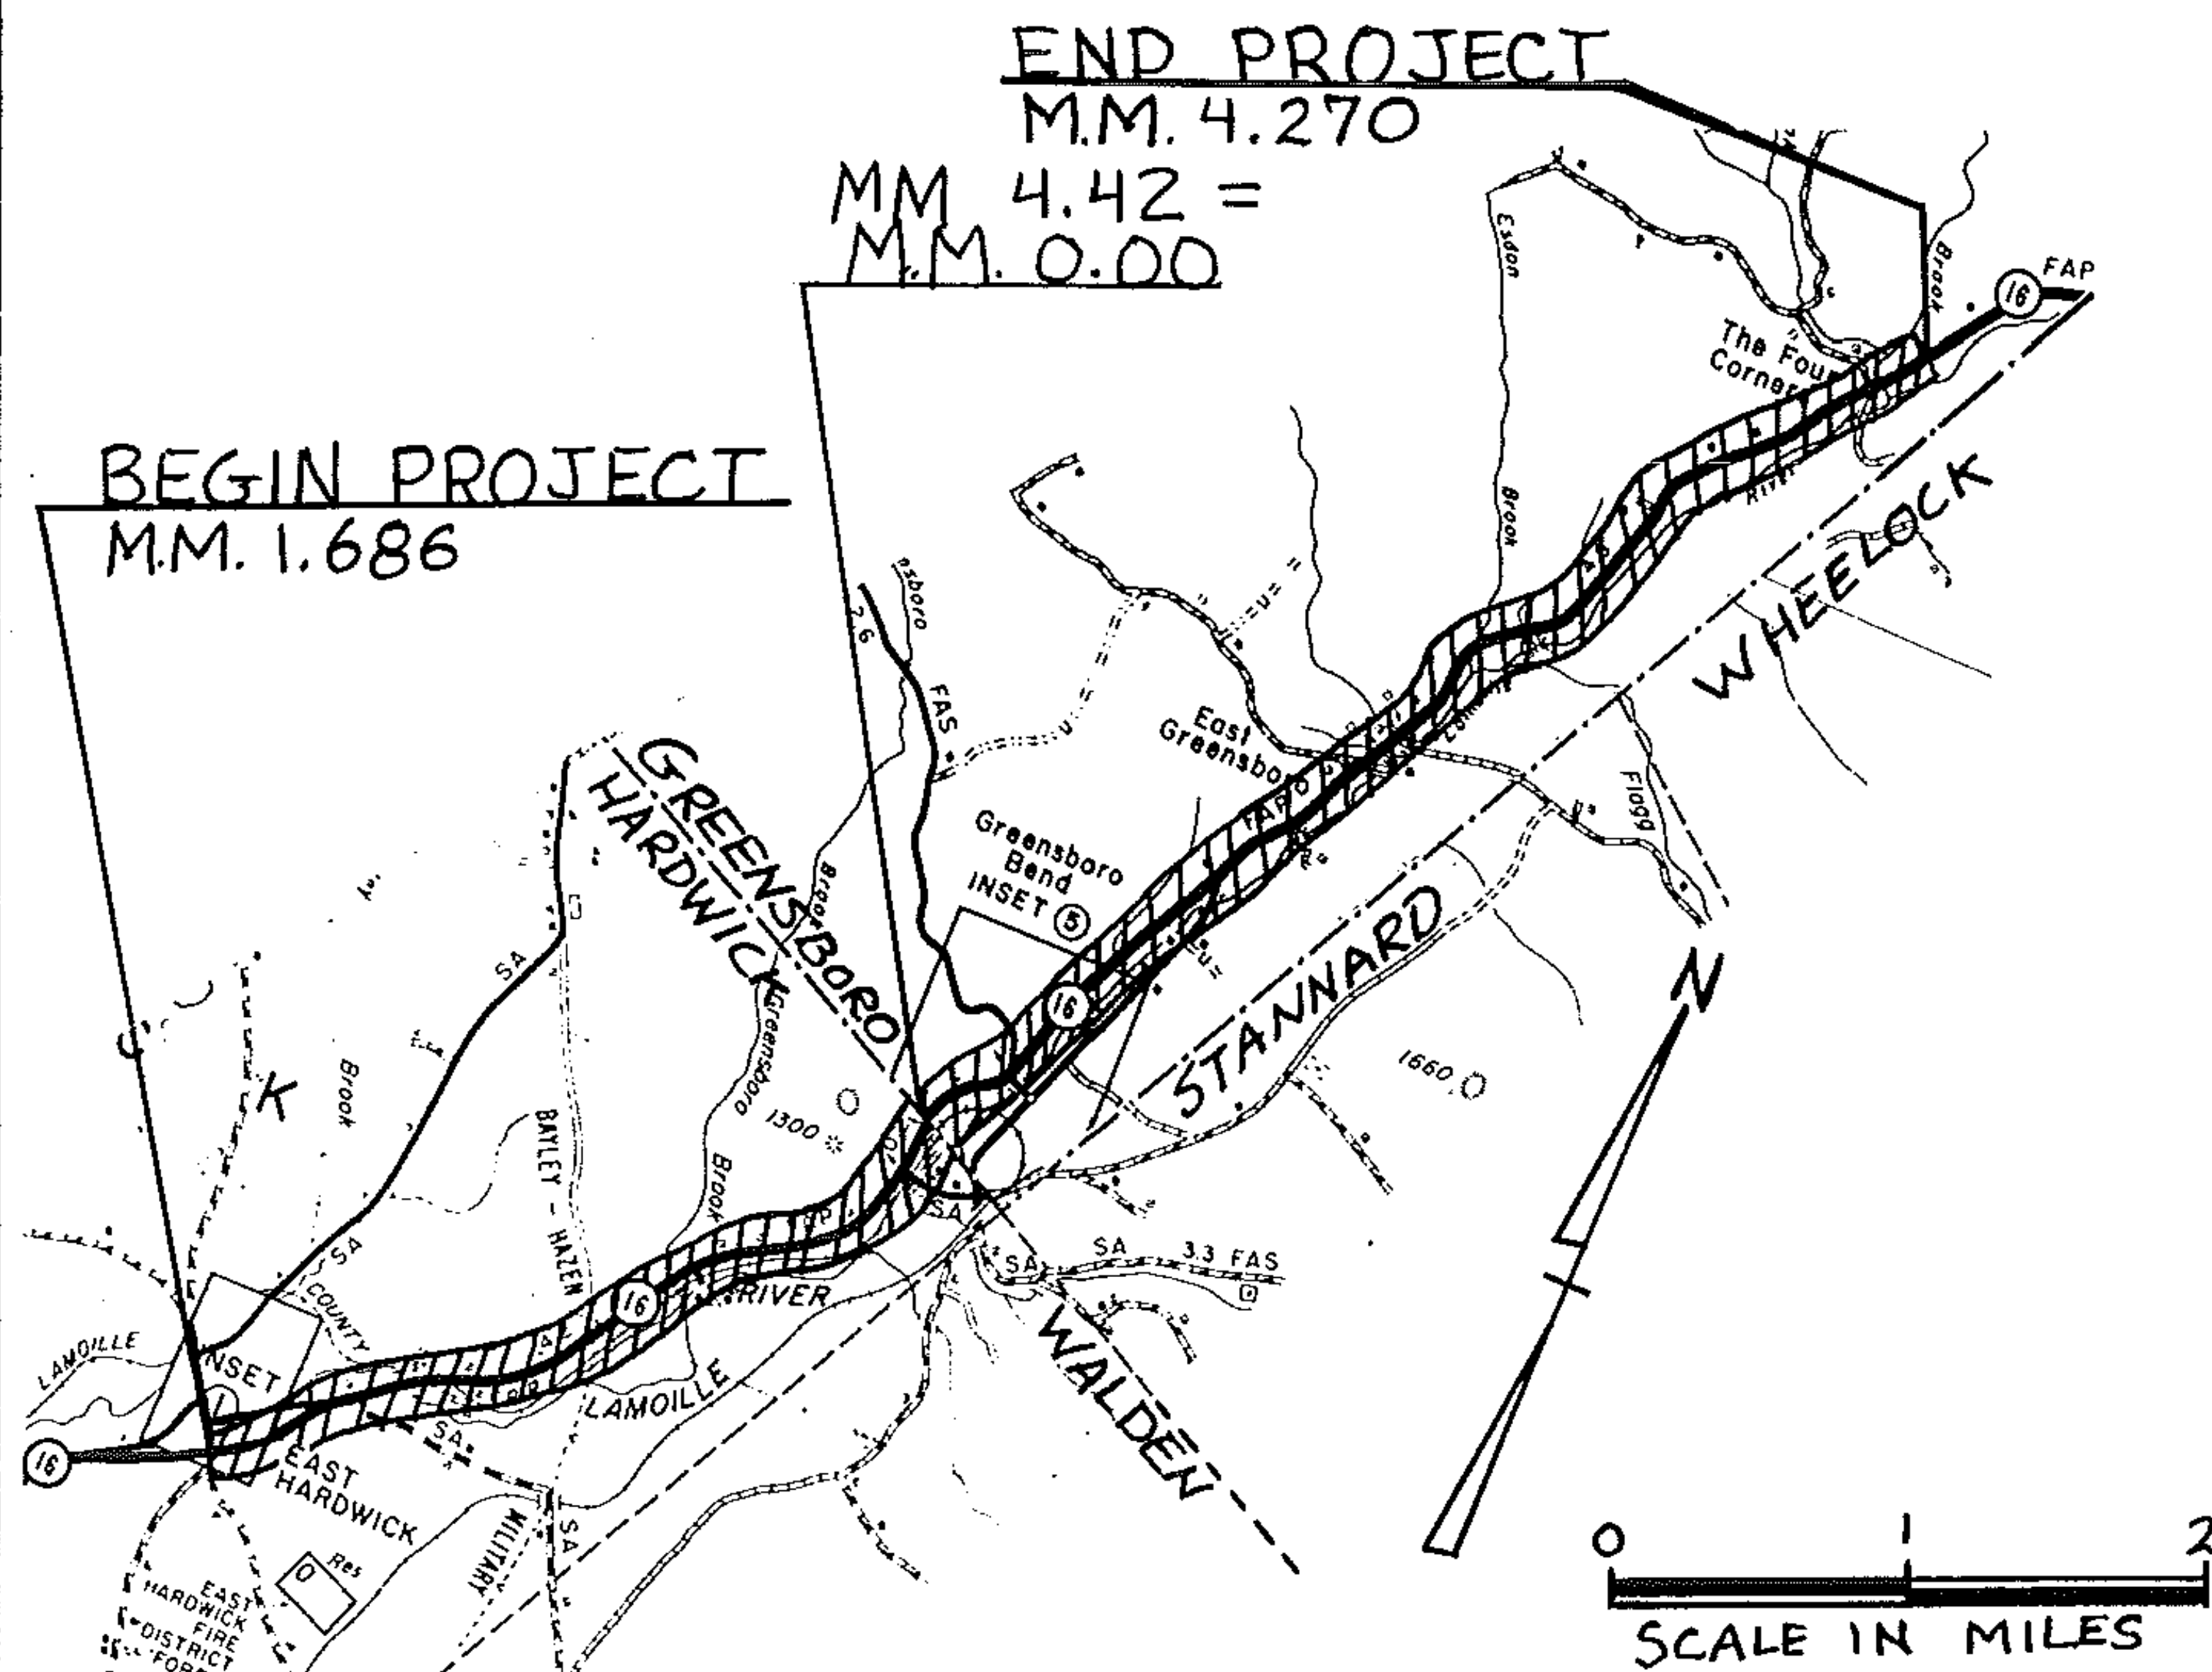

PROJECT HARDWICK-GREENSBORO

NO. HMA 2867

SHEET 15 OF 30 SHEETS