



PAVING LIMITS FOR TOWN ROADS & DRIVES

PAVING LIMITS FOR TOWN ROADS

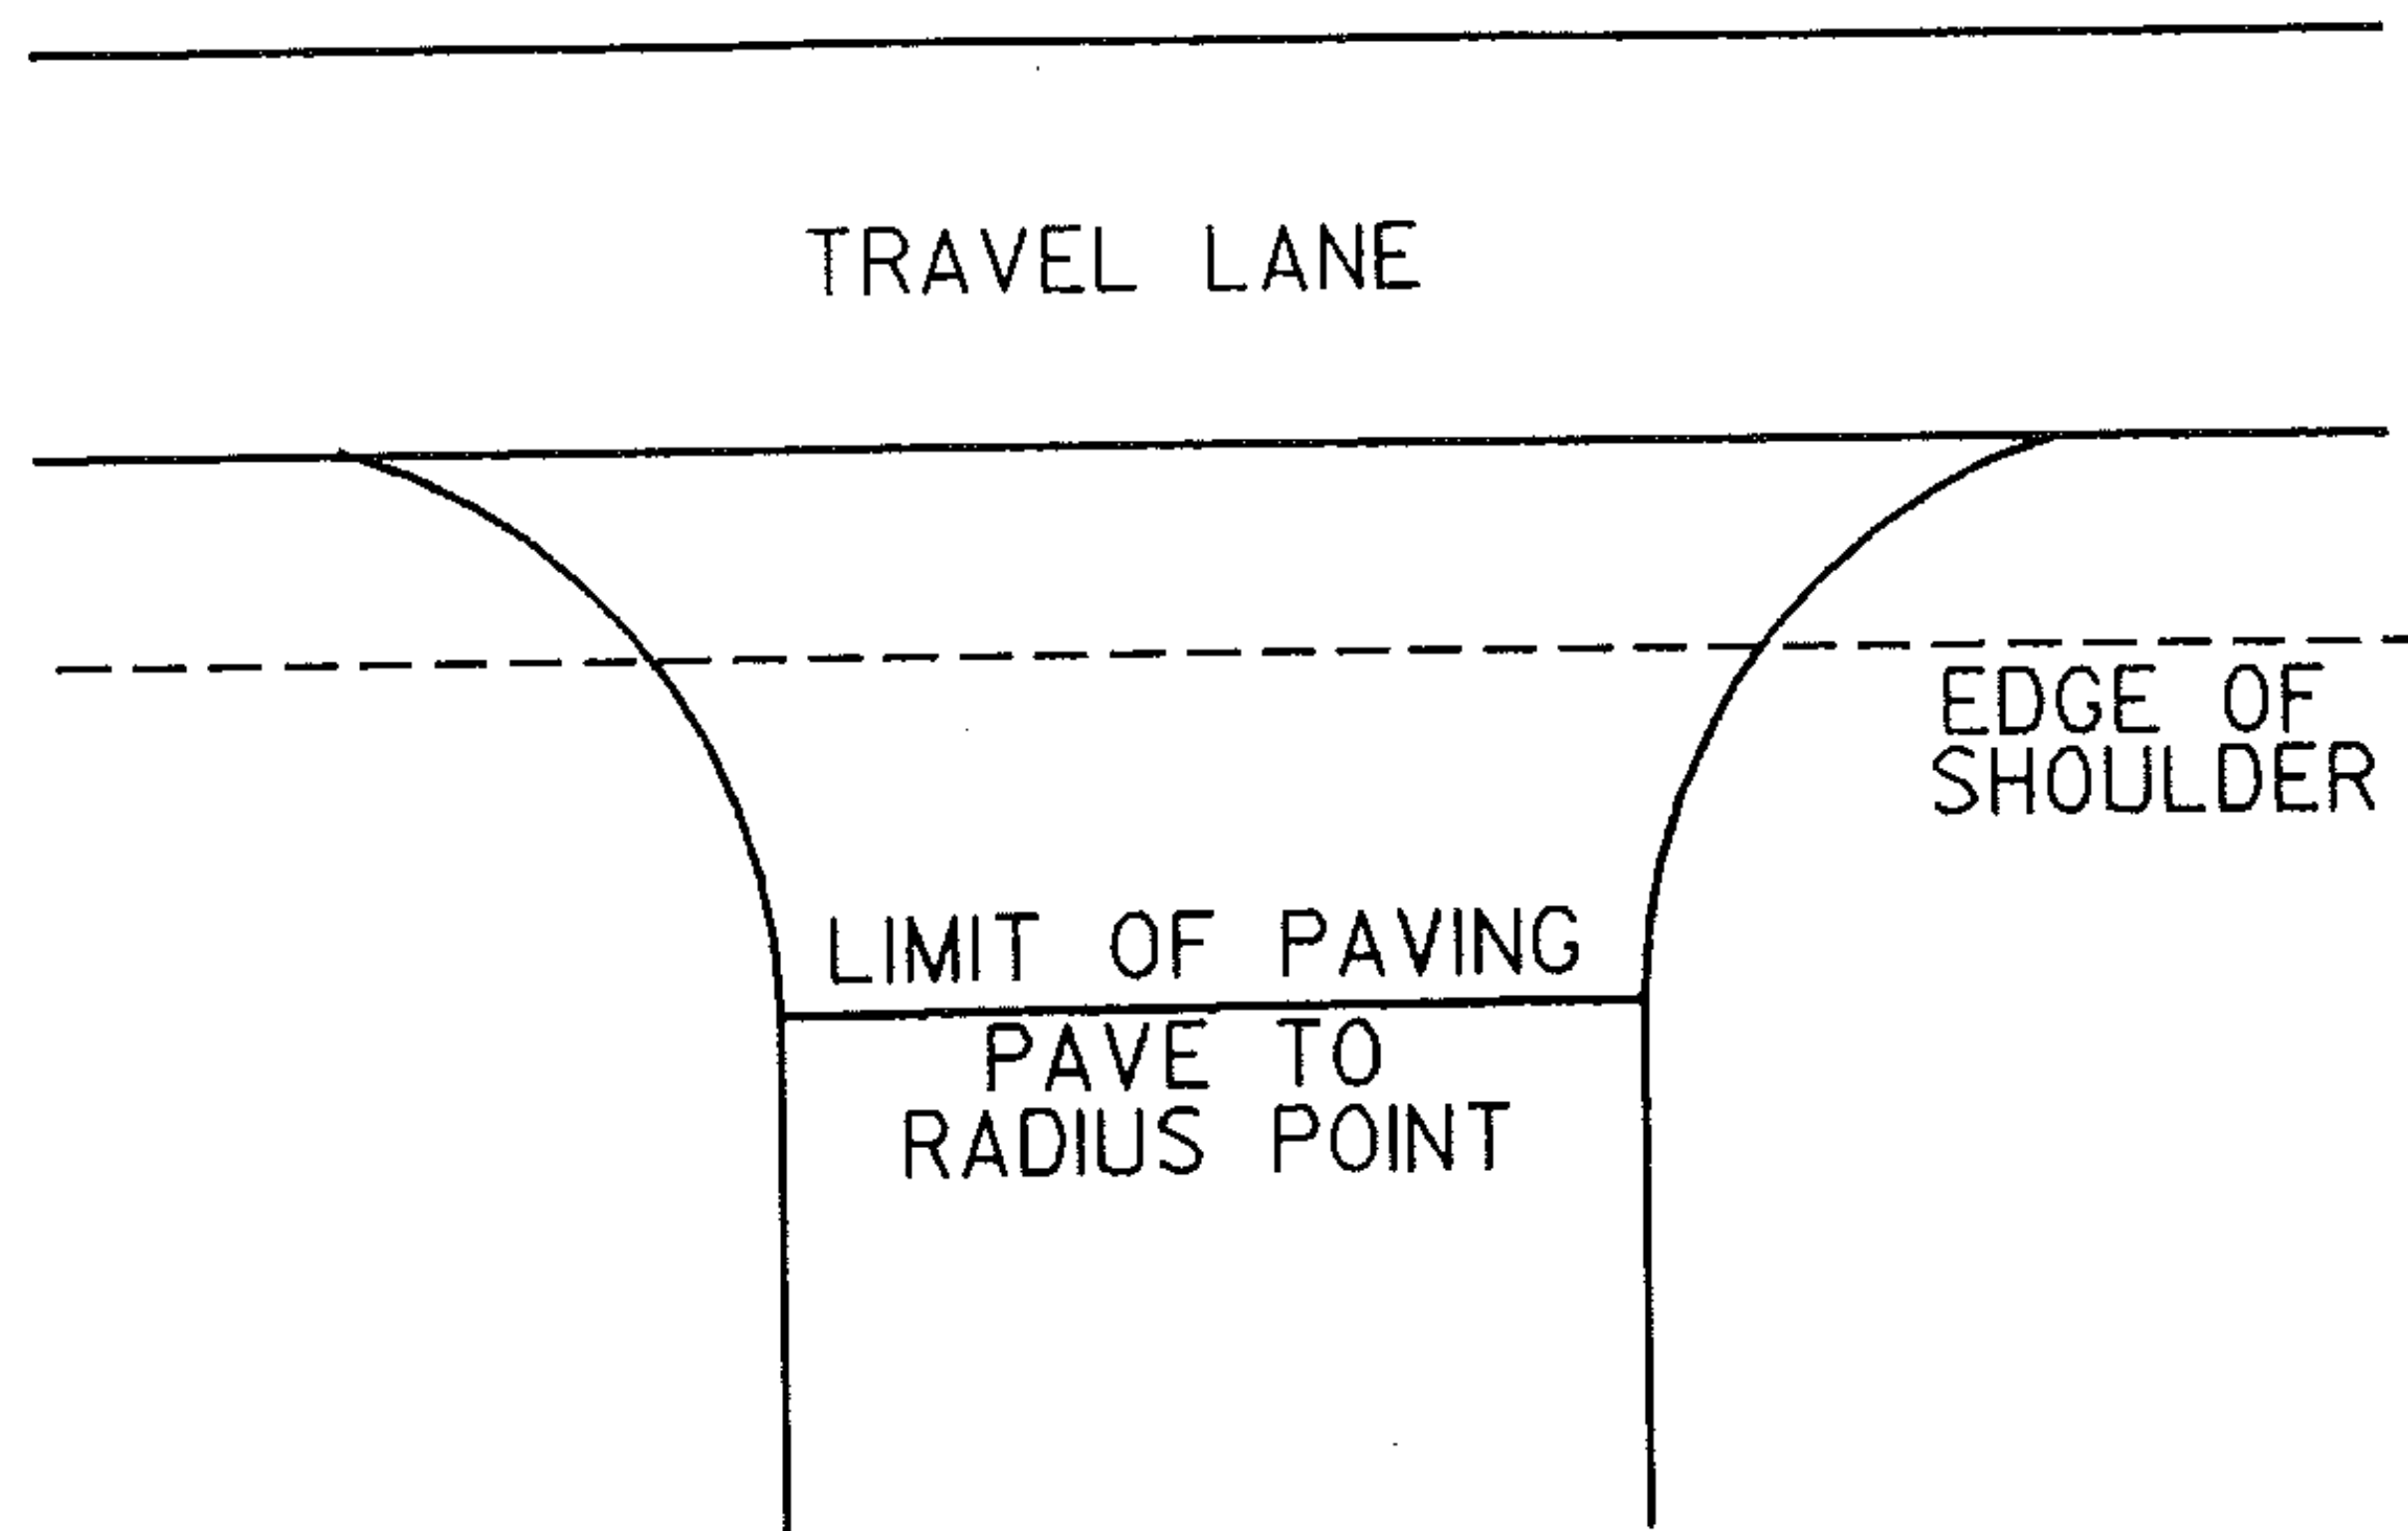

PAVING LIMITS FOR DRIVES

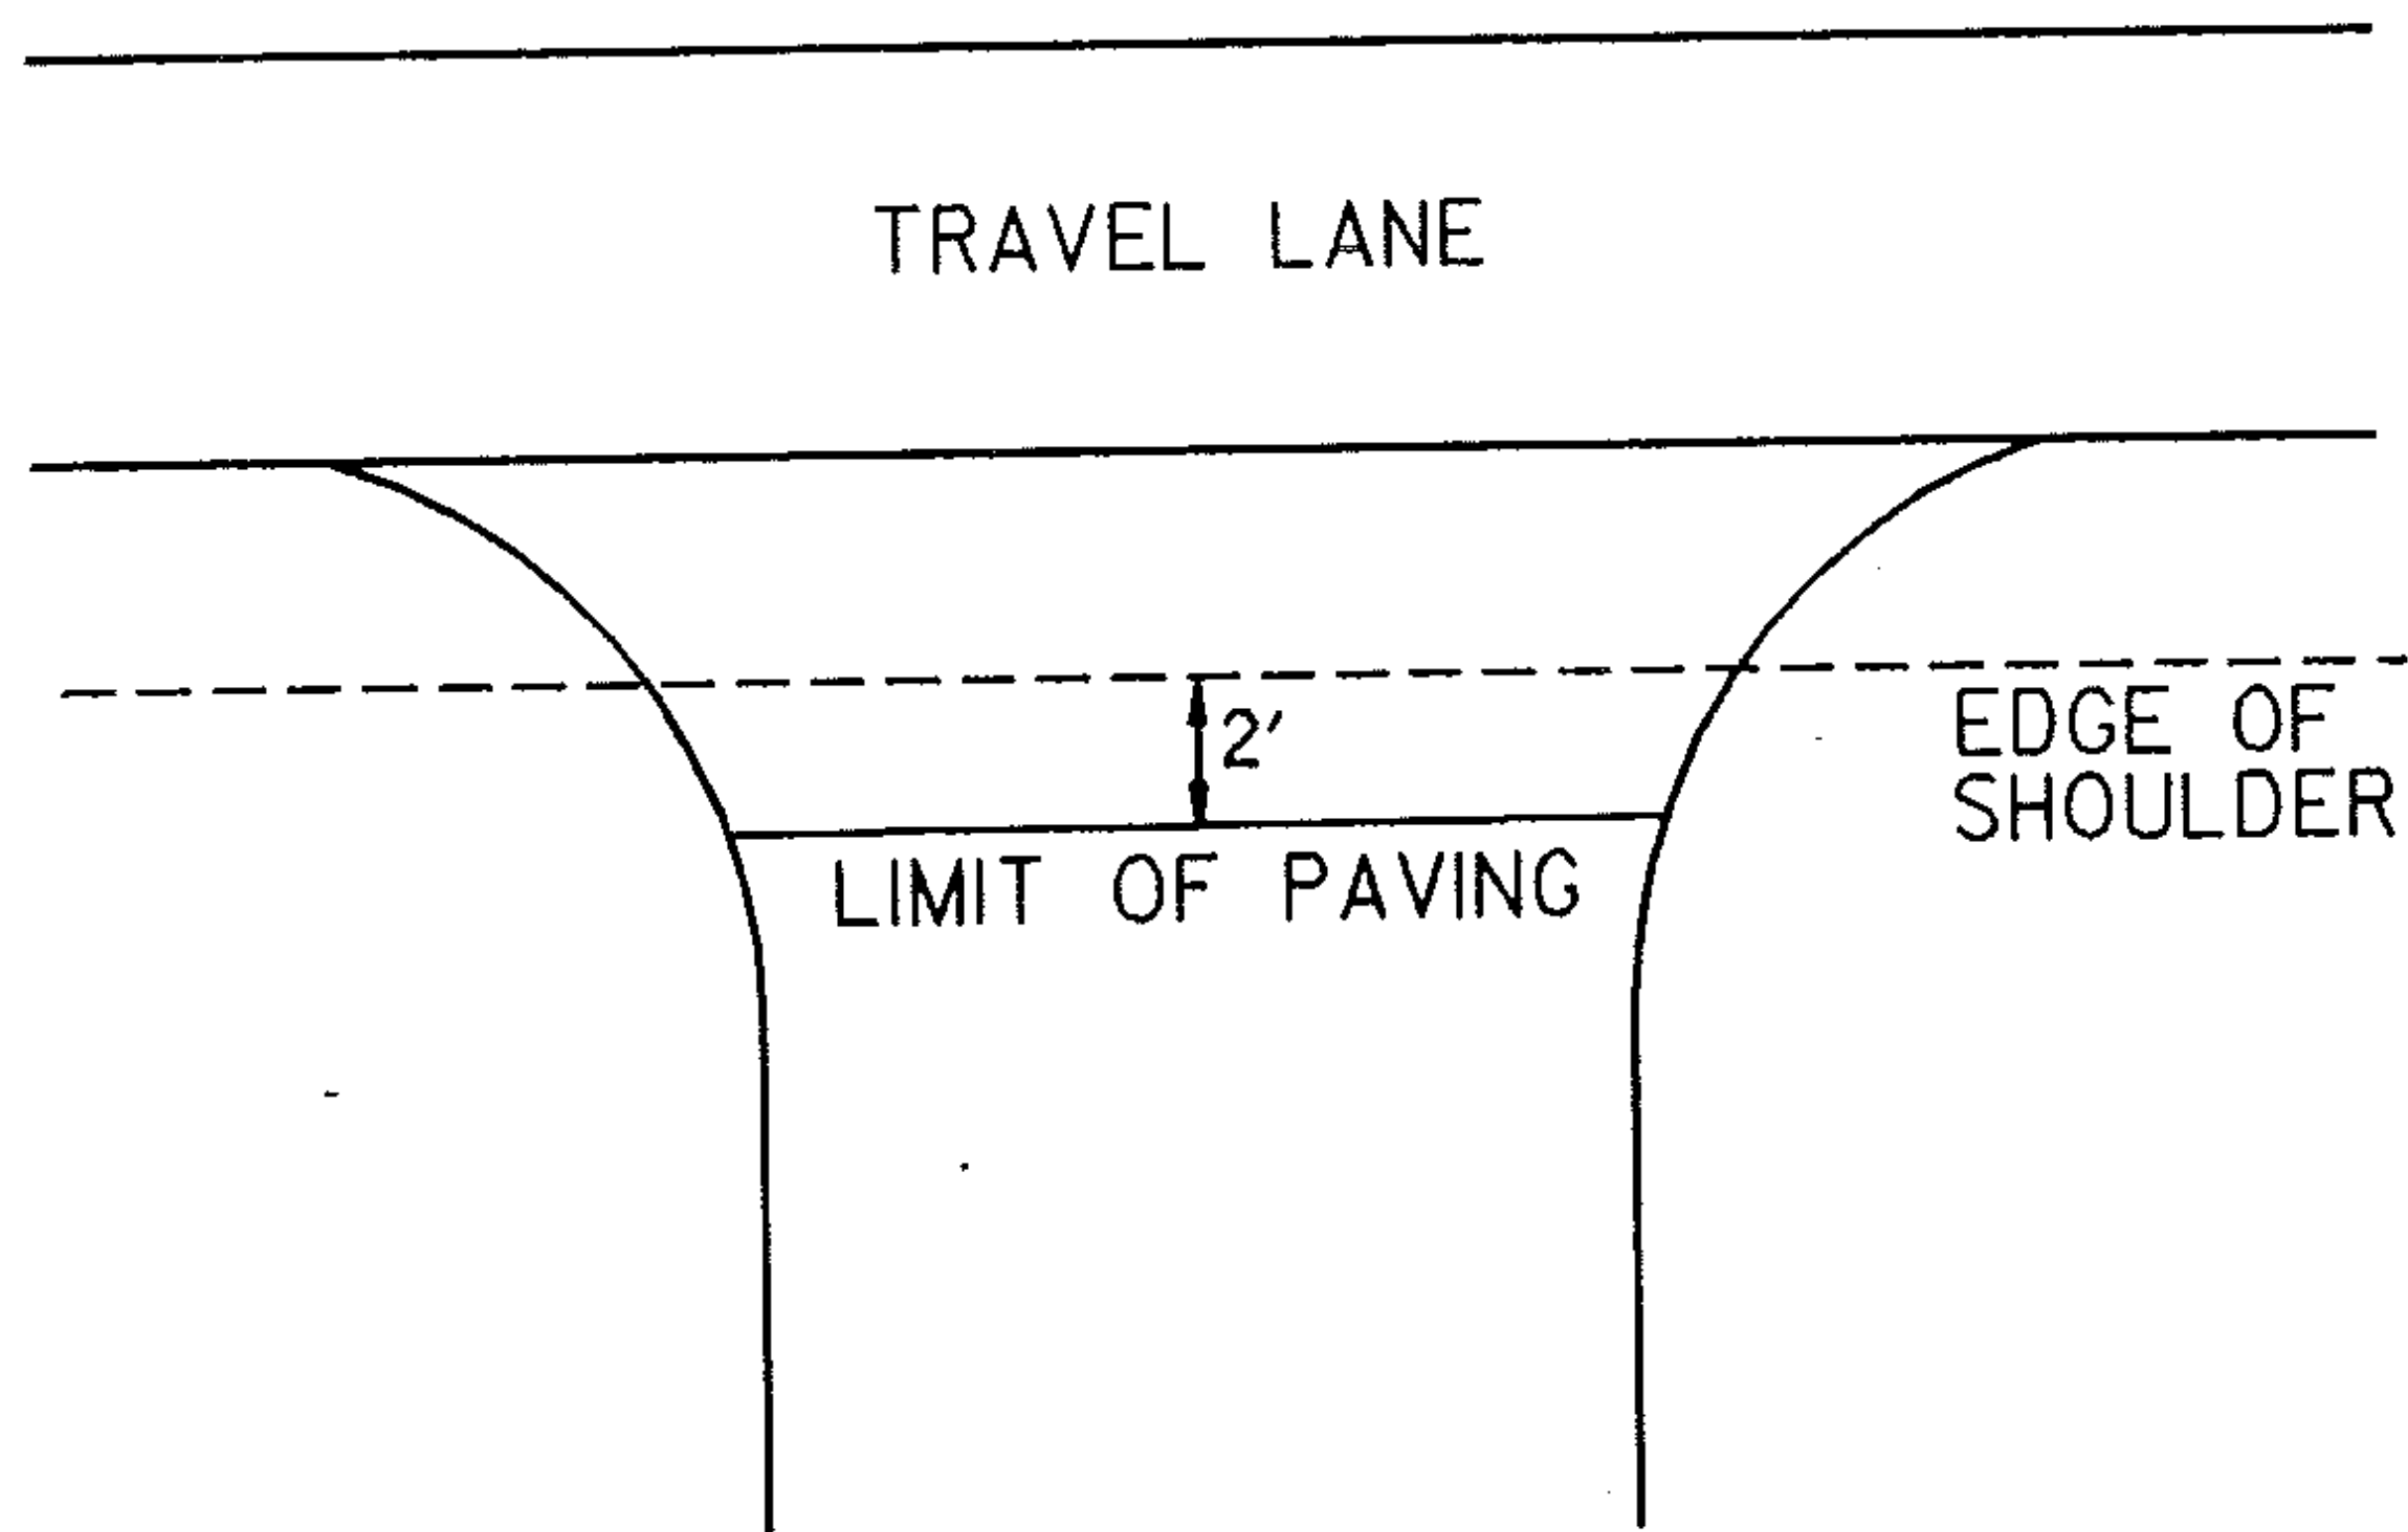

PROJECT _____

NO. _____

SHEET 6 OF 60 SHEETS