


# DESCRIPTION AND LOCATION

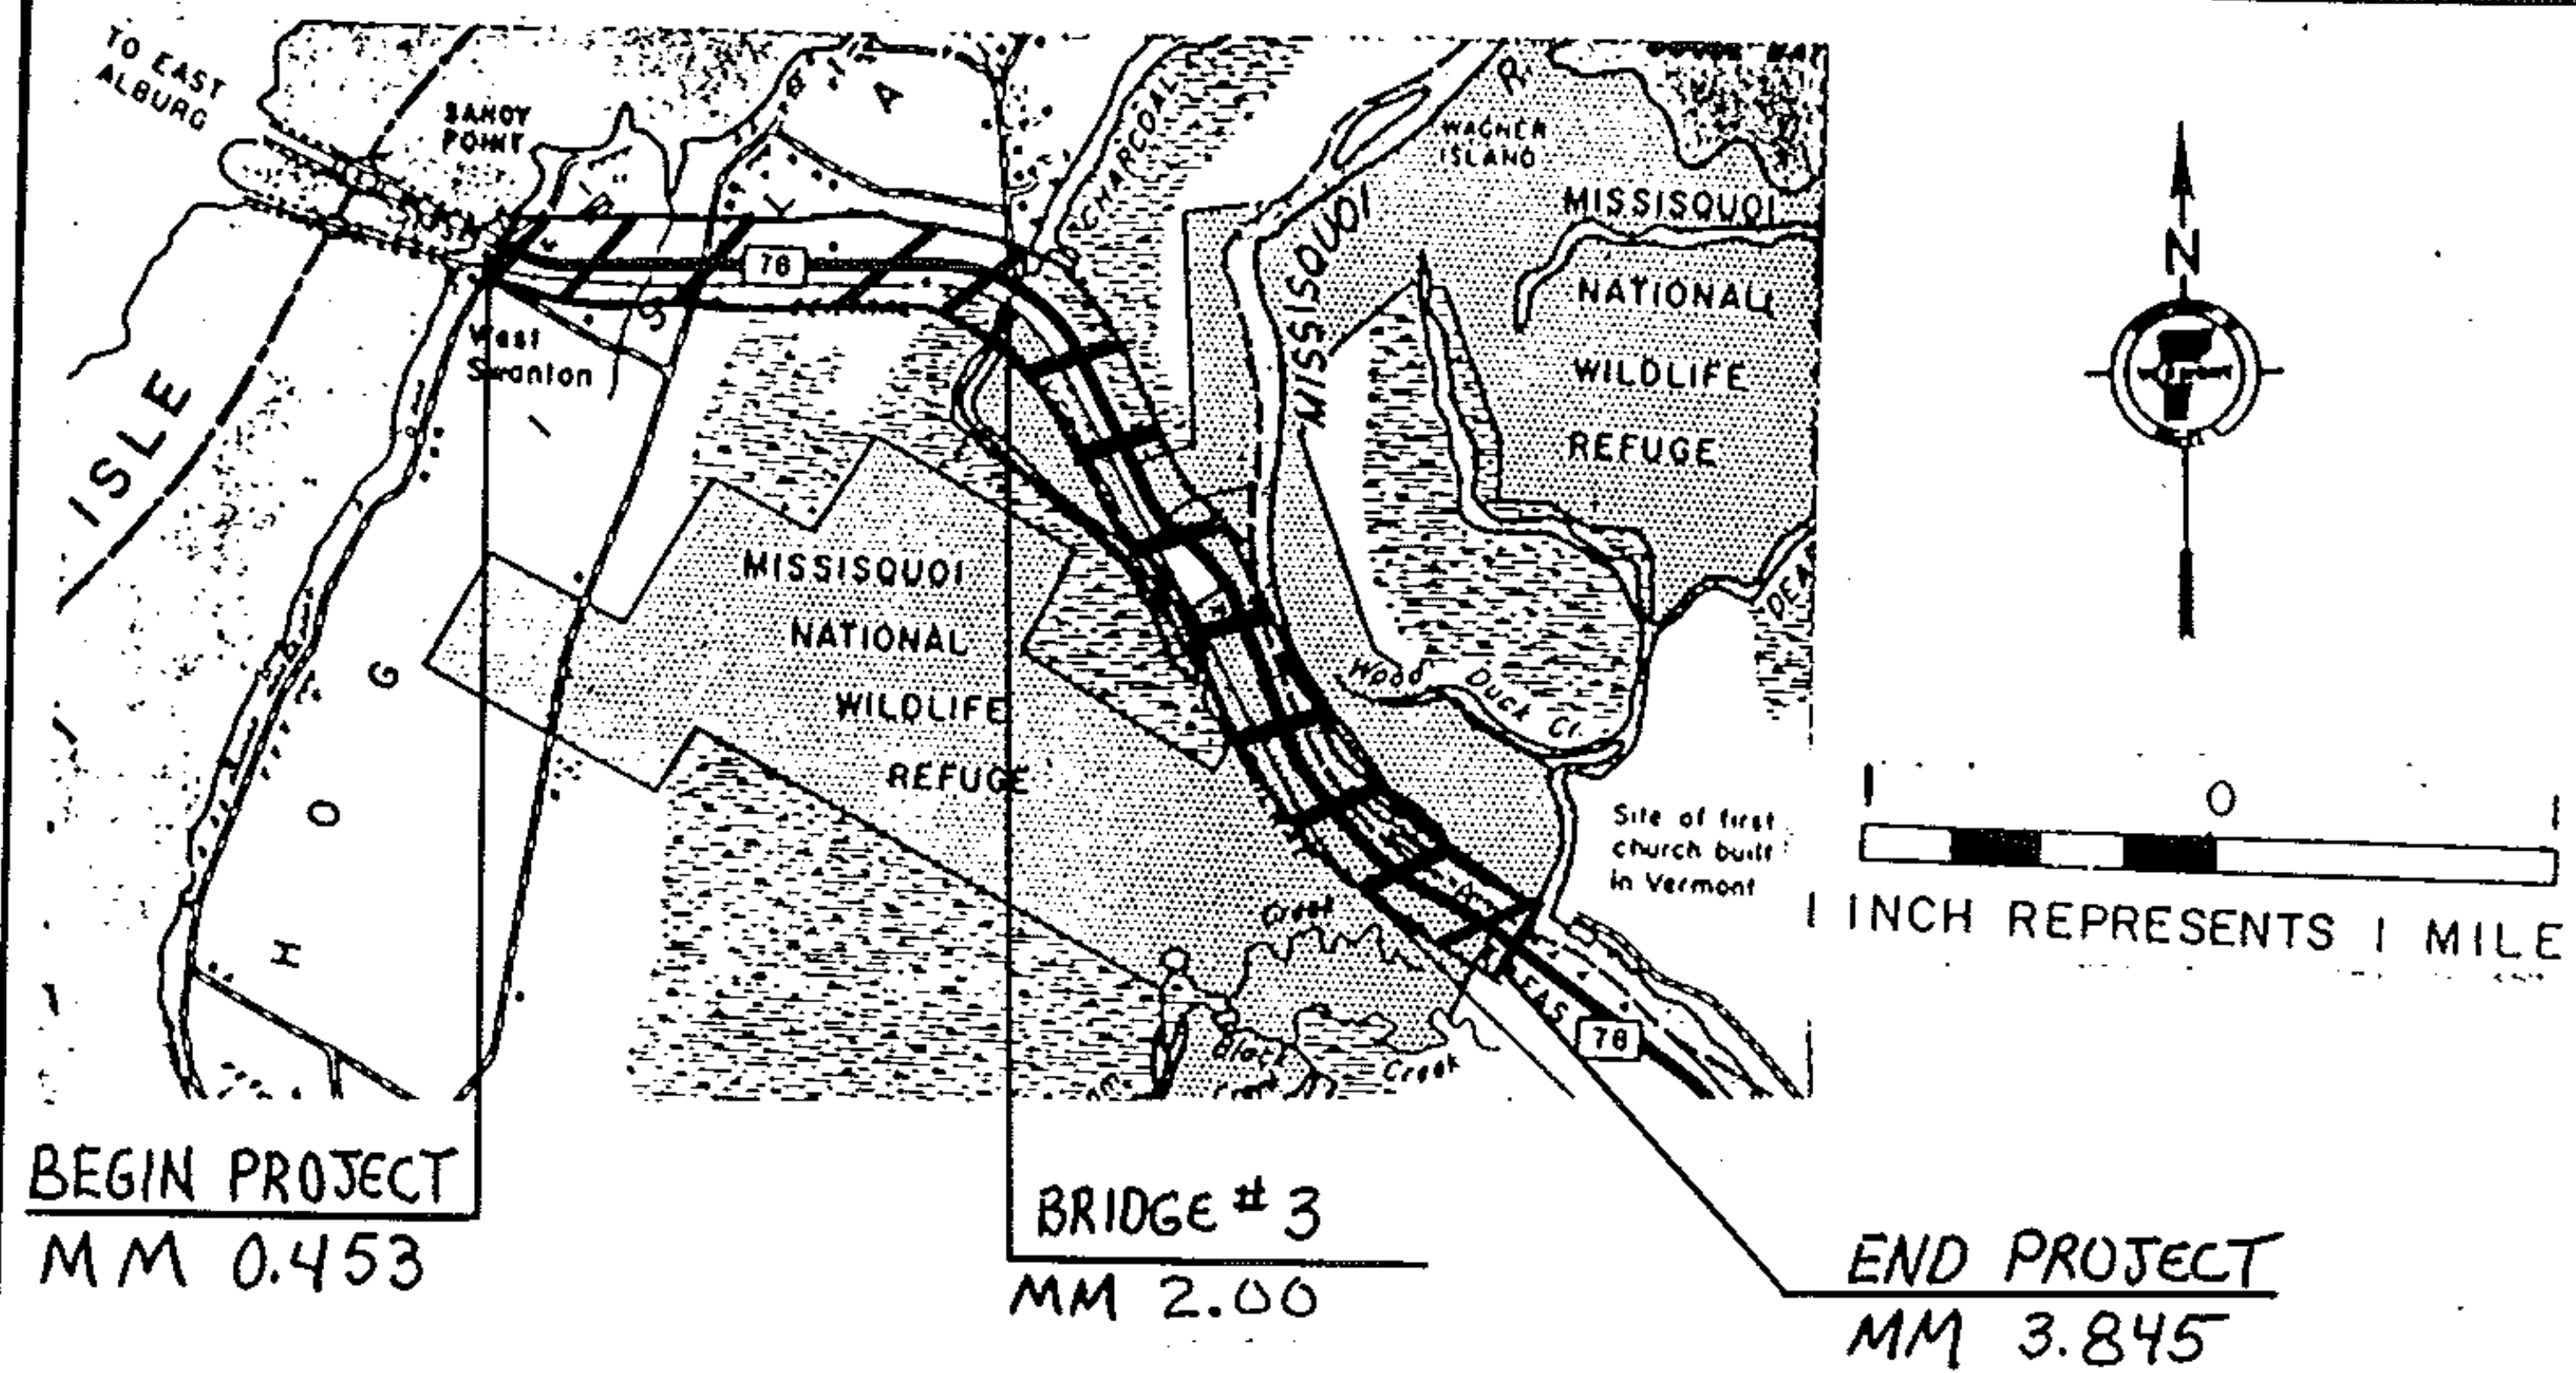

BEGINNING IN THE TOWN OF SWANTON ON VT. ROUTE 78 AT MM 0.453 AND EXTENDING EASTERLY 3.392 MILES TO MM 3.845. RESURFACING OF THE HIGHWAY, NEW PAVEMENT MARKINGS

1986 ADT 3950

LENGTH OF PROJECT = 3.392 MILES  
17,910 FEET

PROJECT SWANTON

NO. HMA 2814

SHEET 9 OF 60 SHEETS