


TYPICAL SECTIONS & DESIGN DATA

ITEM 406.25 BITUMINOUS CONCRETE PAVEMENT
LEVELING COURSE TYPE IV (385 TONS/MILE)
1/2" WEARING COURSE TYPE III ($\pm 1/4"$)
AS DIRECTED BY THE ENGINEER

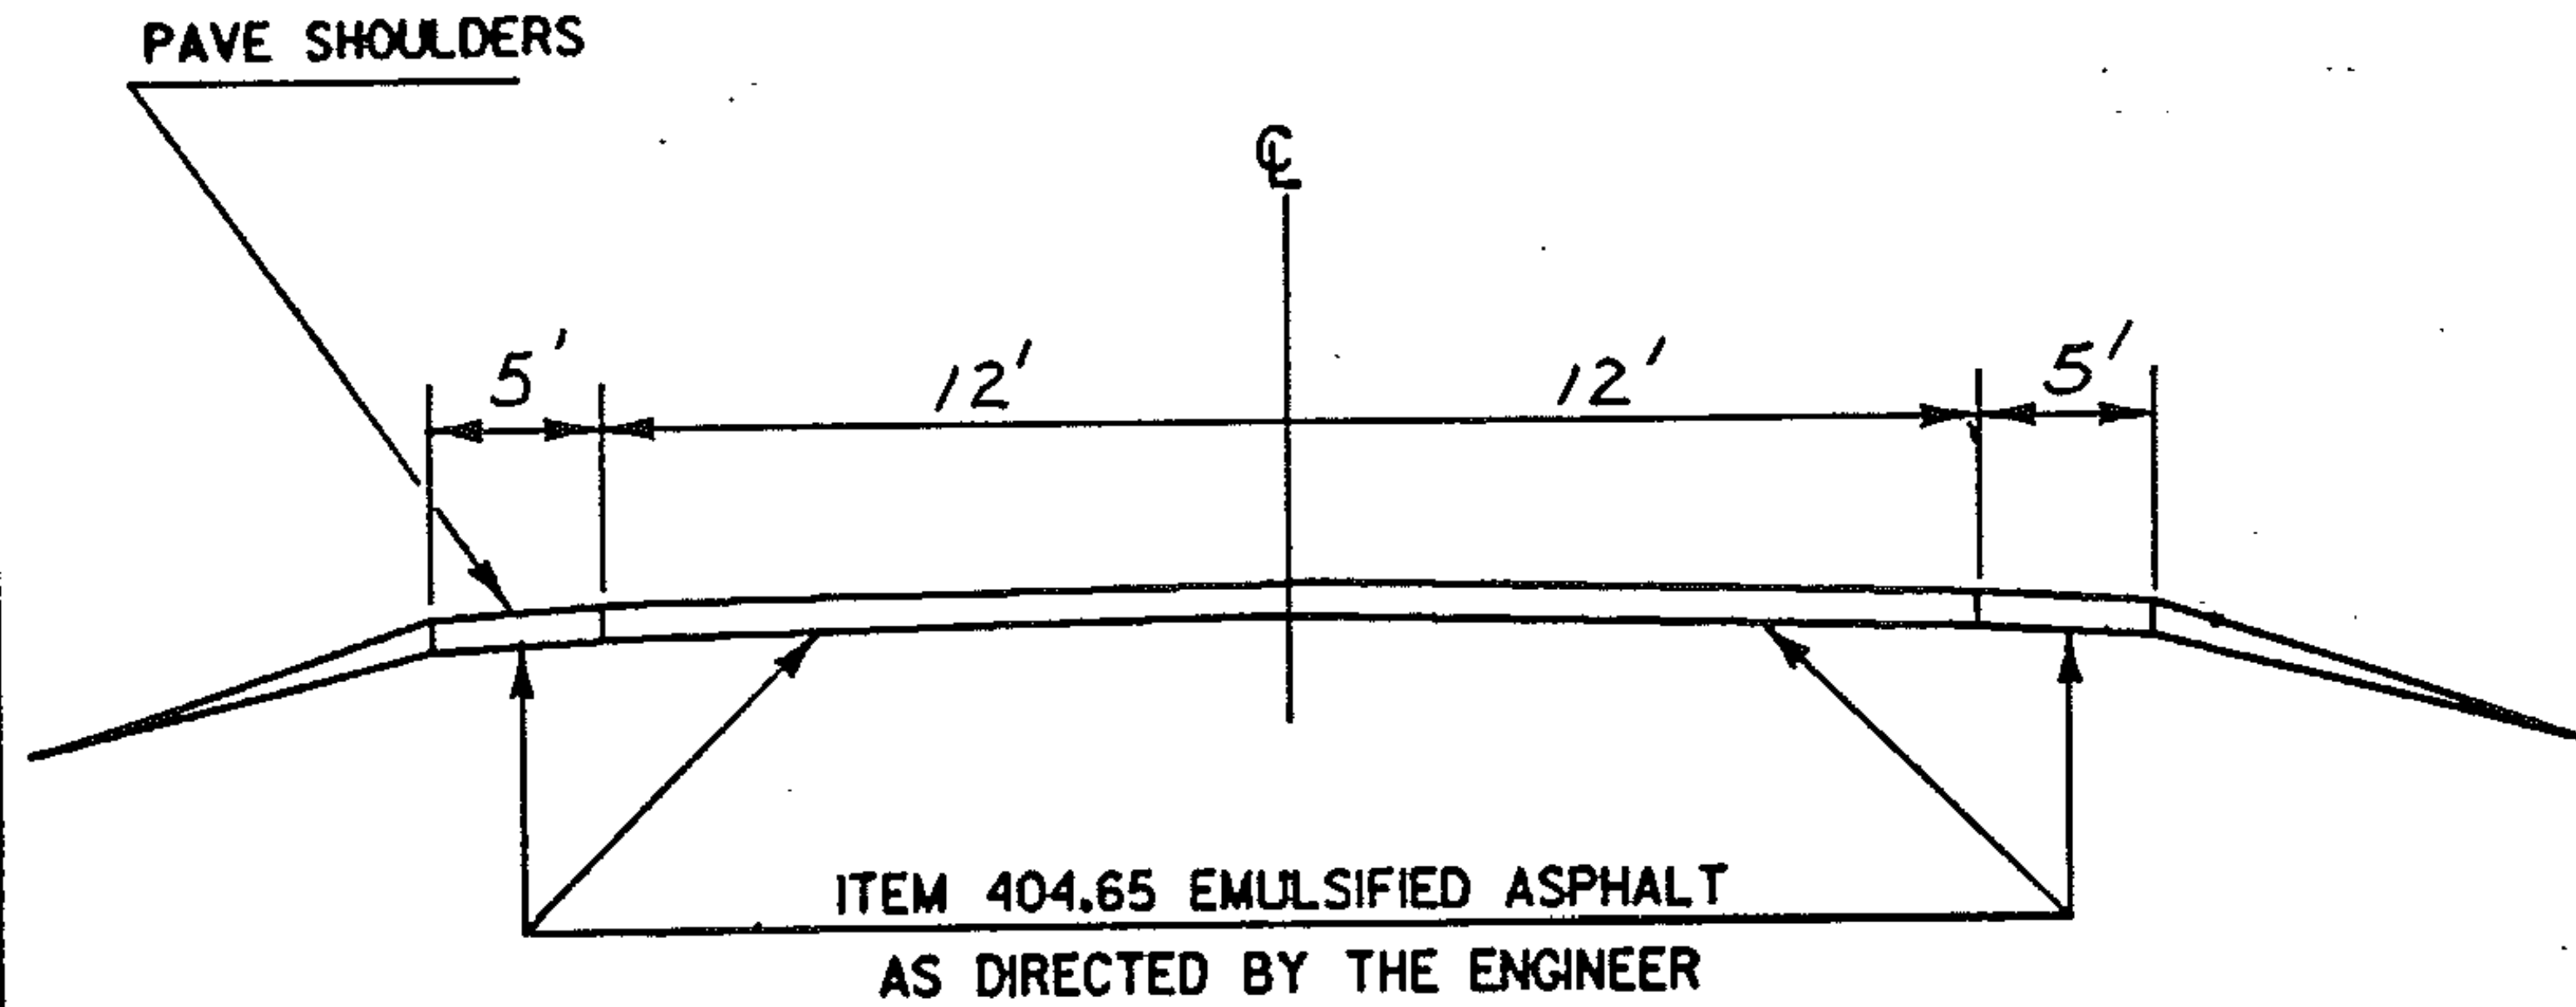

US 2 ALBURG MM 3.422 ~ MM 3.822

PROJECT ALBURG

NO. HMA 2846

SHEET 27 OF 60 SHEETS